

PART OF SECTION 10, TOWNSHIP 39 SOUTH, RANGE 19 EAST
SARASOTA COUNTY, FLORIDA

SHEET INDEX

1	4
---	---

-
- The map displays the project location in the City of Venice, California. The project is situated at the intersection of Venice Avenue and Center Road, marked by a black cross. The map includes labels for Pinebrook Road, Boulevard, Venice Avenue, Center Road, and Interstate 75. A north arrow is located in the top left corner, and a box labeled "PROJECT LOCATION" points to the intersection.

NO SCALE

ELECTRIC:	CABLE TELEVISION:
FPL 5667 NORTH MCINTOSH ROAD SARASOTA, FLORIDA 34233	COMCAST CABLE 5205 FRUITVILLE ROAD SARASOTA, FLORIDA 34232
TELEPHONE:	UTILITY LOCATING SERVICE:
CENTURY LINK 1701 RINGLING BLVD. SARASOTA, FLORIDA 34230	SUNSHINE STATE ONE CALL CENTER PHONE (800) 432-4770 (MINIMUM 48 HOURS NOTICE REQUIRED)

[illegible]

DEVELOPED BY:

501 NORTH CATTLEMEN ROAD
SUITE 100

PHONE: (941) 371-3008 FAX: (941) 371-7998

1	COVER SHEET
2	AERIAL PLAN
3	MASTER SITE AND PHASING PLAN
4	PRELIMINARY SUBDIVISION PLAN
5	MASTER DRAINAGE PLAN
6	DRAINAGE SITE PLAN (A)
7	DRAINAGE SITE PLAN (B)
8	DRAINAGE SITE PLAN (C)
9	DRAINAGE SITE PLAN (D)
10	DRAINAGE SITE PLAN (E)
11	PAVING, SIGNAGE AND GRADING SITE PLAN (A)
12	PAVING, SIGNAGE AND GRADING SITE PLAN (B)
13	PAVING, SIGNAGE AND GRADING SITE PLAN (C)
14	PAVING, SIGNAGE AND GRADING SITE PLAN (D)
15	PAVING, SIGNAGE AND GRADING SITE PLAN (E)
16	PAVING DETAILS AND TEMPORARY MODEL PARKING LOT DETAIL
17	DRAINAGE DETAILS (A)
18	DRAINAGE DETAILS (B)
19	CROSS SECTIONS (A)
20	CROSS SECTIONS (B)
21	MASTER UTILITY PLAN
22	PLAN AND PROFILE: TERRACINA DRIVE (STA. 1+00.00 TO STA. 11+00.00)
23	PLAN AND PROFILE: TERRACINA DRIVE (STA. 11+00.00 TO STA. 19+00.00)
24	PLAN AND PROFILE: TERRACINA DRIVE (STA. 19+00.00 TO STA. 27+00.00)
25	PLAN AND PROFILE: TERRACINA DRIVE (STA. 27+00.00 TO END)
26	PLAN AND PROFILE: CORDANA COURT (STA. 1+00.00 TO END) ALTESINO COURT (STA. 1+00.00 TO END)
27	PLAN AND PROFILE: VITIANO COURT (STA. 1+00.00 TO END) CORTENOVA COURT (STA. 1+00.00 TO END)
28	PLAN AND PROFILE: CAPULET DRIVE (STA. 1+00.00 TO END)
29	PLAN AND PROFILE: FONTANELLE CIRCLE (STA. 1+00.00 TO STA. 9+00.00)
30	PLAN AND PROFILE: FONTANELLE CIRCLE (STA. 9+00.00 TO END) PUMP STATION (1+00.00 TO END)
31	PLAN AND PROFILE: PORTOPALO DRIVE (STA. 0+00 TO END)
32	PLAN AND PROFILE: CLERMONT ROAD (STA. 1+00 TO END)
33	WATER DISTRIBUTION DETAILS
34	WASTE WATER COLLECTION DETAILS
35	BEST MANAGEMENT PRACTICES PLAN
36	BEST MANAGEMENT PRACTICES DETAILS
37	ZONING INFORMATION DOCUMENTS (ORDINANCE NO. 2008-014)
	 DENOTES SWFWMD SUBMITTAL

TOTAL PROJECT AREA		55.33 ACRES			WATER POTABLE WATER SUPPLY WILL BE PROVIDED BY SARASOTA COUNTY UTILITIES.	
PRESENT ZONING		RMF-1			SEWER WASTEWATER SERVICES WILL BE PROVIDED BY SARASOTA COUNTY UTILITIES.	
ABUTTING ZONING		NORTH: CUG-1 ROW EAST: CQ ROW SOUTH: BMH / CUE-1 WEST: RMF-1 / CUE-1			GARBAGE GARBAGE PICKUP WILL BE PROVIDED BY SARASOTA COUNTY WASTE MANAGEMENT VIA CURB-SIDE PICKUP (INCLUDING CLUBHOUSE GARBAGE PICKUP)	
CHARACTER AND INTENDED USE		CONVENTIONAL SUBDIVISION			ROADWAYS PRIVATE ROADS WILL BE MAINTAINED BY THE VERONA RESERVE COMMUNITY ASSOCIATION, INC. ACCESS TO THIS PROJECT IS PROVIDED DIRECT FROM JACKARACA BOULEVARD A VENUE AVENUE.	
PROPOSED NUMBER OF UNITS SHOWN		165 SINGLE FAMILY (63 DETACHED (102 ATTACHED VILLAS)			COMMON AREAS TO BE MAINTAINED BY THE VERONA RESERVE COMMUNITY ASSOCIATION, INC.	
PARCEL SIZE		2.9 UNITS / ACRE			EASEMENTS UTILITY EASEMENTS WILL BE PROVIDED FOR SANITARY SEWER MAINS & WATER MAINS IN ACCORDANCE WITH SARASOTA COUNTY ORDINANCE NO. 99-008S AND THE SARASOTA COUNTY LULU DRAINAGE EASEMENTS ARE DESIGNATED ON THE PLAN.	
TOTAL UNITS ALLOWED		331 (6 UNITS / ACRE)			TREE LOCATIONS THE PROPOSED DEVELOPMENT AND ITS ORIENTATION TO THE EXISTING TREES IS SHOWN ON THE AERIAL PHOTOGRAPH. TREES WILL BE PRESERVED WHERE POSSIBLE. TREES WITH A MINIMUM PERMIT WILL BE APPLIED FOR PRIOR TO CONSTRUCTION.	
BUILDING INFORMATION					FEMA DESIGNATION THE PROJECT IS LOCATED IN FLOOD ZONE "4F" (MINIMUM FLOOD ELEVATION REQUIRED IS 12.09' NAD OR 14.22 FEET) AND FLOOD ZONE "X" (NO MINIMUM FLOOD ELEVATION). THIS IS SHOWN ON FORM PANEL # 332Z, DATED 9/30/92.	
AMENITY BUILDING	CONSTRUCTION TYPE	NO. OF BUILDINGS	NO. OF UNITS			
CLUBHOUSE BUILDING	TYPE VI	1	N/A			
RESIDENTIAL BUILDINGS						
SINGLE FAMILY DETACHED		63	63			
SINGLE FAMILY ATTACHED TYPICAL		51	102			
RESIDENTIAL TOTAL:		114	165	ENVIRONMENTAL AND SURFACE WATER MANAGEMENT SYSTEM PRIVATE DRAINAGE SYSTEM WILL BE MAINTAINED BY THE VERONA RESERVE COMMUNITY ASSOCIATION, INC.		
PARKING CALCULATIONS						
TYPE	RATIO	SPACES REQUIRED	SPACES PROVIDED			
SINGLE FAMILY UNIT	2 SPACES PER UNIT	330	330**	STATEMENT OF OWNERSHIP AND UNIFIED CONTROL		
CLUBHOUSE	1 SPACE PER 250 S.F. (1,194 S.F.)	5	5 *	TAYLOR MORRISON OF FLORIDA, INC. 801 NORTH CATTLEBARK ROAD SUITE 100 SARASOTA, FL 34232 PHONE: (941) 371-3008 FAX: (941) 371-3998		
TOTAL:		335	335 *	Construction h with STIPULA dated Construction w/ir da		
* 1 HANDICAP SPACE INCLUDED IN TOTAL						
** SINGLE FAMILY UNIT PARKING SPACES PROVIDED VIA GARAGE AND/OR DRIVEWAY						
LAND USE				*COMMON AREAS INCLUDING, BUT LIMITED TO PRIVATE RECREATION AREAS, OPEN SPACE AND LANDSCAPE AREAS. DRAINAGE AREAS, LAKE AND ROADWAYS, SANITARIES AND ENTRANCES SHALL BE MAINTAINED UNDER THE UNIFIED OWNERSHIP AND MANAGEMENT OF THE VERONA RESERVE COMMUNITY ASSOCIATION, INC. DATE: JAN 25 2011 THIS AUTHORIZATION IS SUBJECT TO EXISTING REQUIREMENTS OF SARASOTA COUNTY, FLORIDA AND ANY SPECIAL REQUIREMENTS OF THE BOARD OF		
BUILDINGS & AMENITY		9.10 AC. (16.0%)				
ROADWAY, DRIVEWAYS & SIDEWALKS		9.33 AC. (16.4%)				
TOTAL IMPERVIOUS AREA		18.43 AC. (32.4%)				
LAKE AND DETENTION AREAS		9.04 AC. (15.8%)				
WETLANDS AND CONSERVATION AREAS		5.00 AC. (8.8%)				
OPEN SPACE		24.52 AC. (43.0%)				
TOTAL PERVIOUS AREA		38.96 AC. (67.6%)				
TOTAL AREA		56.99 AC. (100.0%)				

I HEREBY CERTIFY THAT TO THE BEST OF MY KNOWLEDGE AND BELIEF THE DESIGN OF THIS PROJECT, AS PREPARED UNDER MY PERSONAL DIRECTION AND CONTROL COMPLIES WITH ALL APPLICABLE STANDARDS, INCLUDING THE "MANUAL OF UNIFORM MINIMUM STANDARDS FOR DESIGN, CONSTRUCTION AND MAINTENANCE FOR STREETS AND HIGHWAYS" AS ADOPTED BY THE FLORIDA DEPARTMENT OF TRANSPORTATION PURSUANT TO SUBSECTION 335.07(1) AND (4), FLORIDA STATUTES AND THE SARASOTA COUNTY LAND DEVELOPMENT REGULATIONS.

**WALDROP
ENGINEERING**

INC.

VERONA RESERVE

CLIENT: TAYLOR MORRISON OF FLORIDA, INC.

COVER SHEET

GENERAL FILE COPY

[illegible]

FLORIDA CERTIFICATE OF AUTHORIZATION #6063

Authorized
Licensee letter

No 78207

STATE OF FLORIDA

NICHOLAS B. SPEACH, P.E.

PLU-1974-CR-NO. 70207

12/15/10

SET NUMBER: 225-01-01

SHEET :

10-024924 DS

MASTER SITE & PHASING PLAN

FLORIDA CERTIFICATE OF AUTHORIZATION 486


NICHOLAS B. SPEACH, P.E. 12/15/10
FL CERTIFICATE NO 70207

SET NUMBER:	225-01-01
SHEET :	1



0.0 0.4 0.8 1.2 1.6 2.0 2.4 2.8 3.2 3.6 4.0 4.4 4.8 5.2 5.6 6.0 6.4 6.8 7.2 7.6 8.0 8.4 8.8 9.2 9.6 10.0

J:\225-01 Verona Reserve\Ausc\AD\225-01-01 Consultant Subdivision Plans\Reserve\0104.dwg Dec 14, 2010 2:17pm

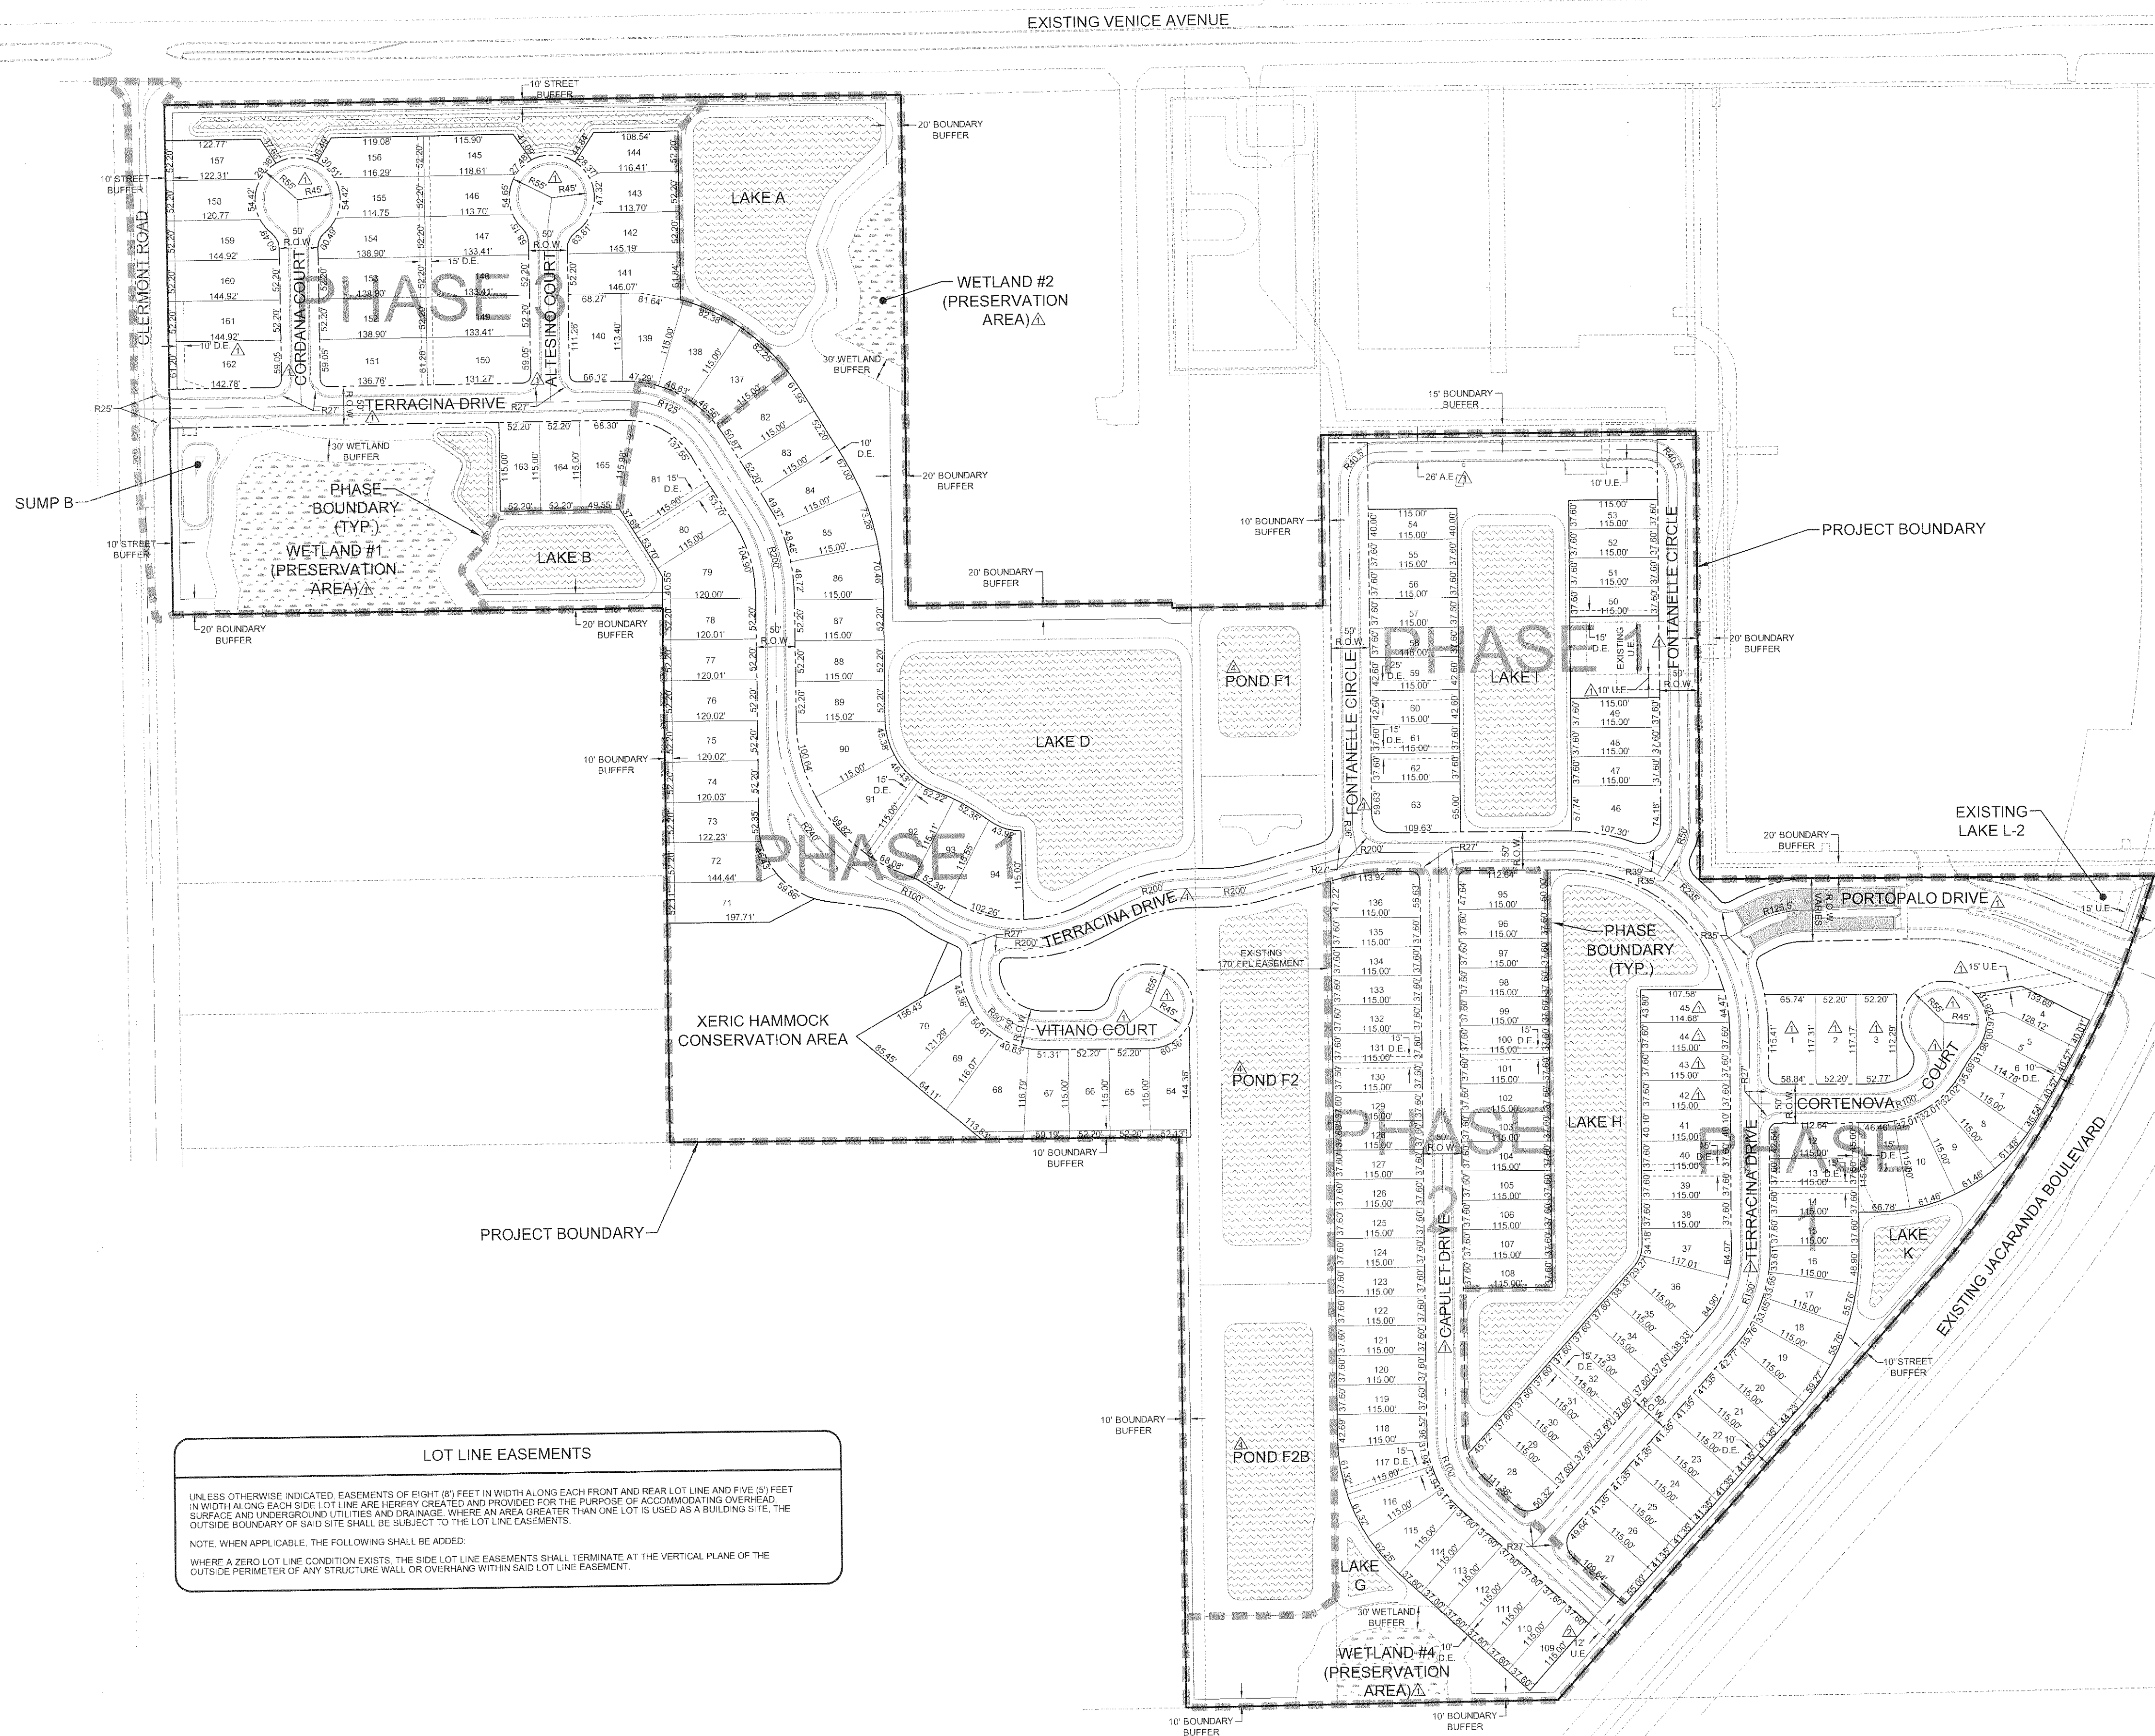

LOT LINE EASEMENTS

UNLESS OTHERWISE INDICATED, EASEMENTS OF EIGHT (8) FEET IN WIDTH ALONG EACH FRONT AND REAR LOT LINE AND FIVE (5) FEET IN WIDTH ALONG EACH SIDE LOT LINE ARE HEREBY CREATED AND PROVIDED FOR THE PURPOSE OF ACCOMMODATING OVERHEAD SURFACE AND UNDERGROUND UTILITIES AND DRAINAGE. WHERE AN AREA GREATER THAN ONE LOT IS USED AS A BUILDING SITE, THE OUTSIDE BOUNDARY OF SAID SITE SHALL BE SUBJECT TO THE LOT LINE EASEMENTS.

NOTE: WHEN APPLICABLE, THE FOLLOWING SHALL BE ADDED:

WHERE A ZERO LOT LINE CONDITION EXISTS, THE SIDE LOT LINE EASEMENTS SHALL TERMINATE AT THE VERTICAL PLANE OF THE OUTSIDE PERIMETER OF ANY STRUCTURE WALL OR OVERHANG WITHIN SAID LOT LINE EASEMENT.




CIVIL ENGINEERING &
LAND DEVELOPMENT CONSULTANTS

29100 BONITA GRANDE DRIVE - SUITE 305 BONITA SPRINGS, FL 34135
P: 239-405-7999 F: 239-405-7777 E: info@waldropengineering.com



VERONA RESERVE

CLIENT: TAYLOR MORRISON OF FLORIDA, INC.


PRELIMINARY SUBDIVISION PLAN

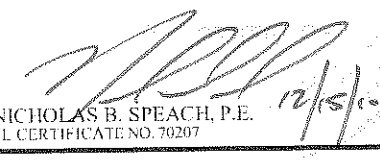PLAN REVISIONS	
07/28/10	REVISED PER SARASOTA COUNTY COMMENTS
08/04/10	REVISED PER SARASOTA COUNTY COMMENTS
10/14/10	REVISED PER CLIENT COMMENTS
FLORIDA CERTIFICATE OF AUTHORIZATION #8636	
	
NICHOLAS B. SPEECHLE, P.E. REGISTERED PROFESSIONAL ENGINEER	
SET NUMBER:	225-01-01
SHEET:	4

J:\225-01 Verona Reserve\AutoCAD\225-01.dwg Concurrent Subdivision Plans\225-01.dwg Dec 14, 2010 2:17pm

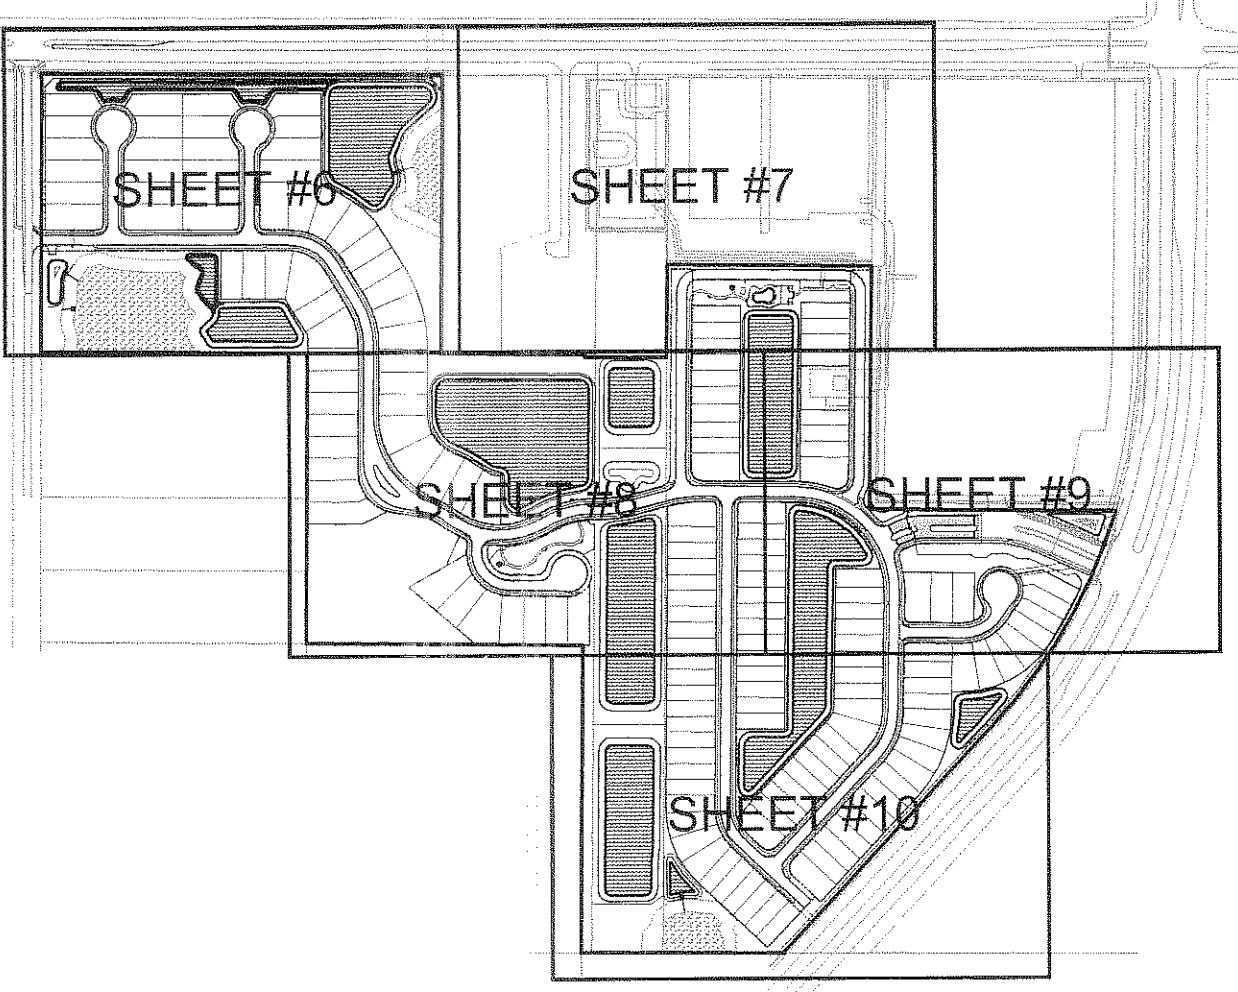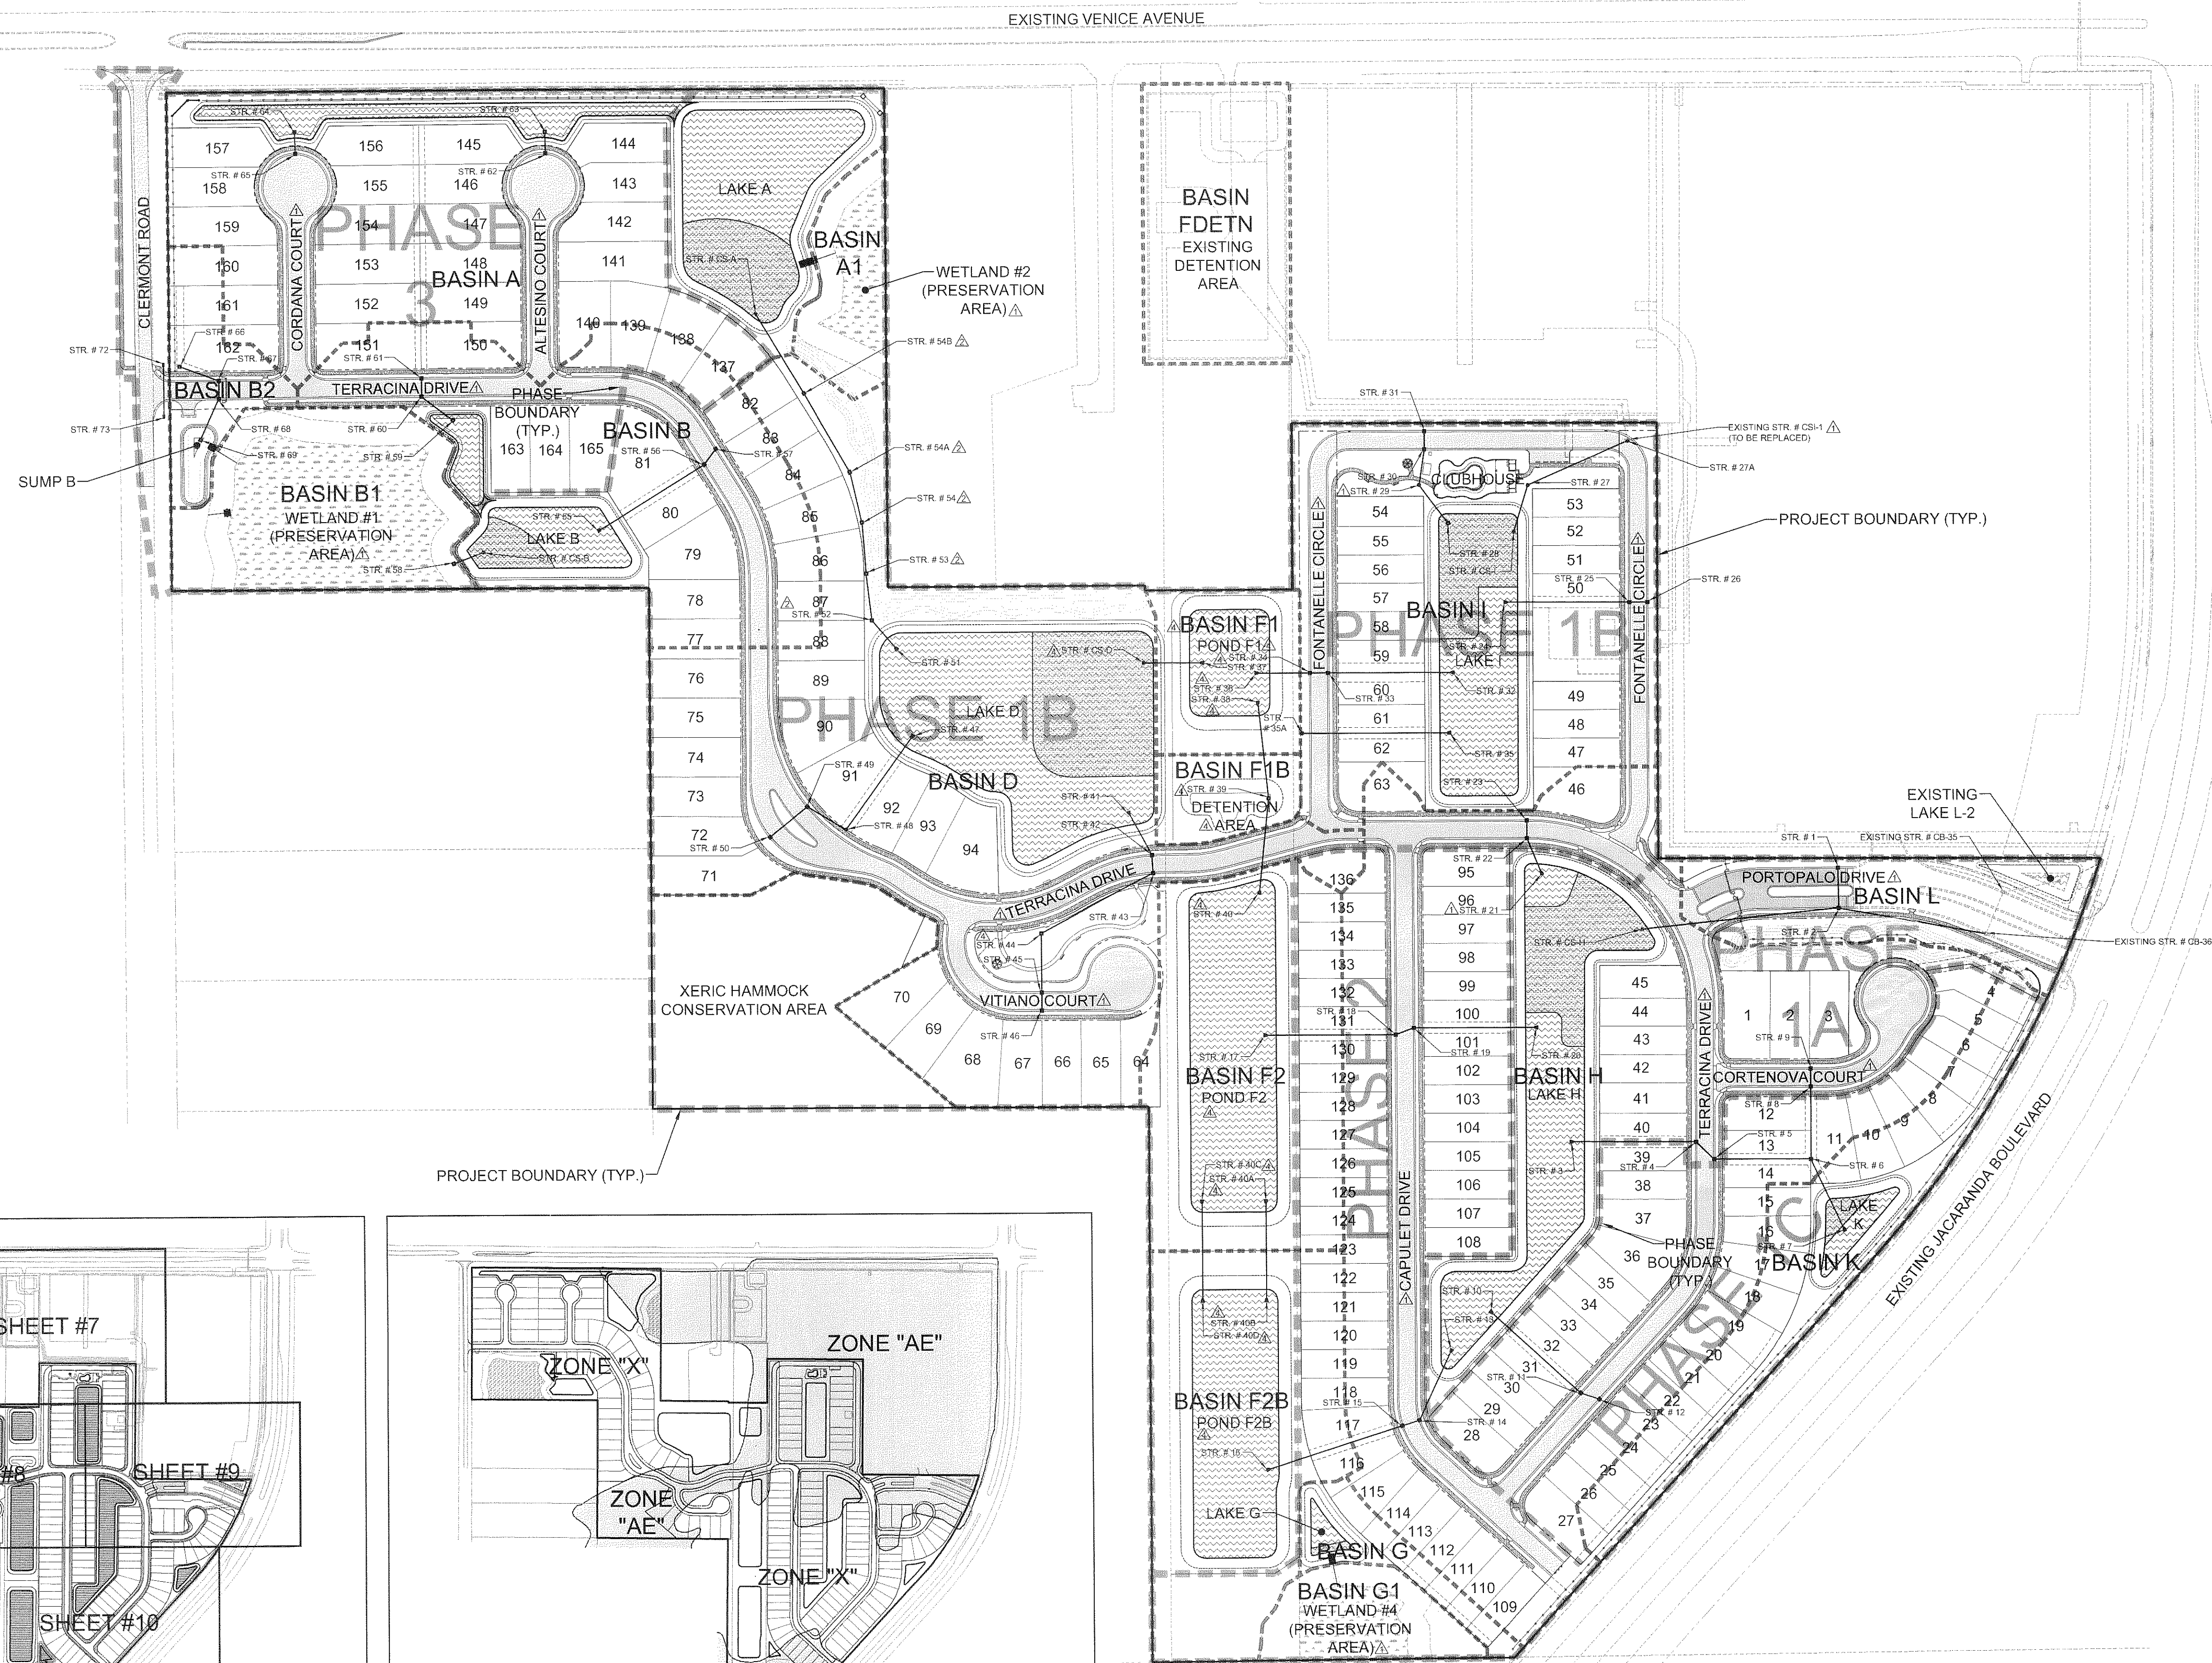

DRAINAGE SITE PLAN
SHEET MAP

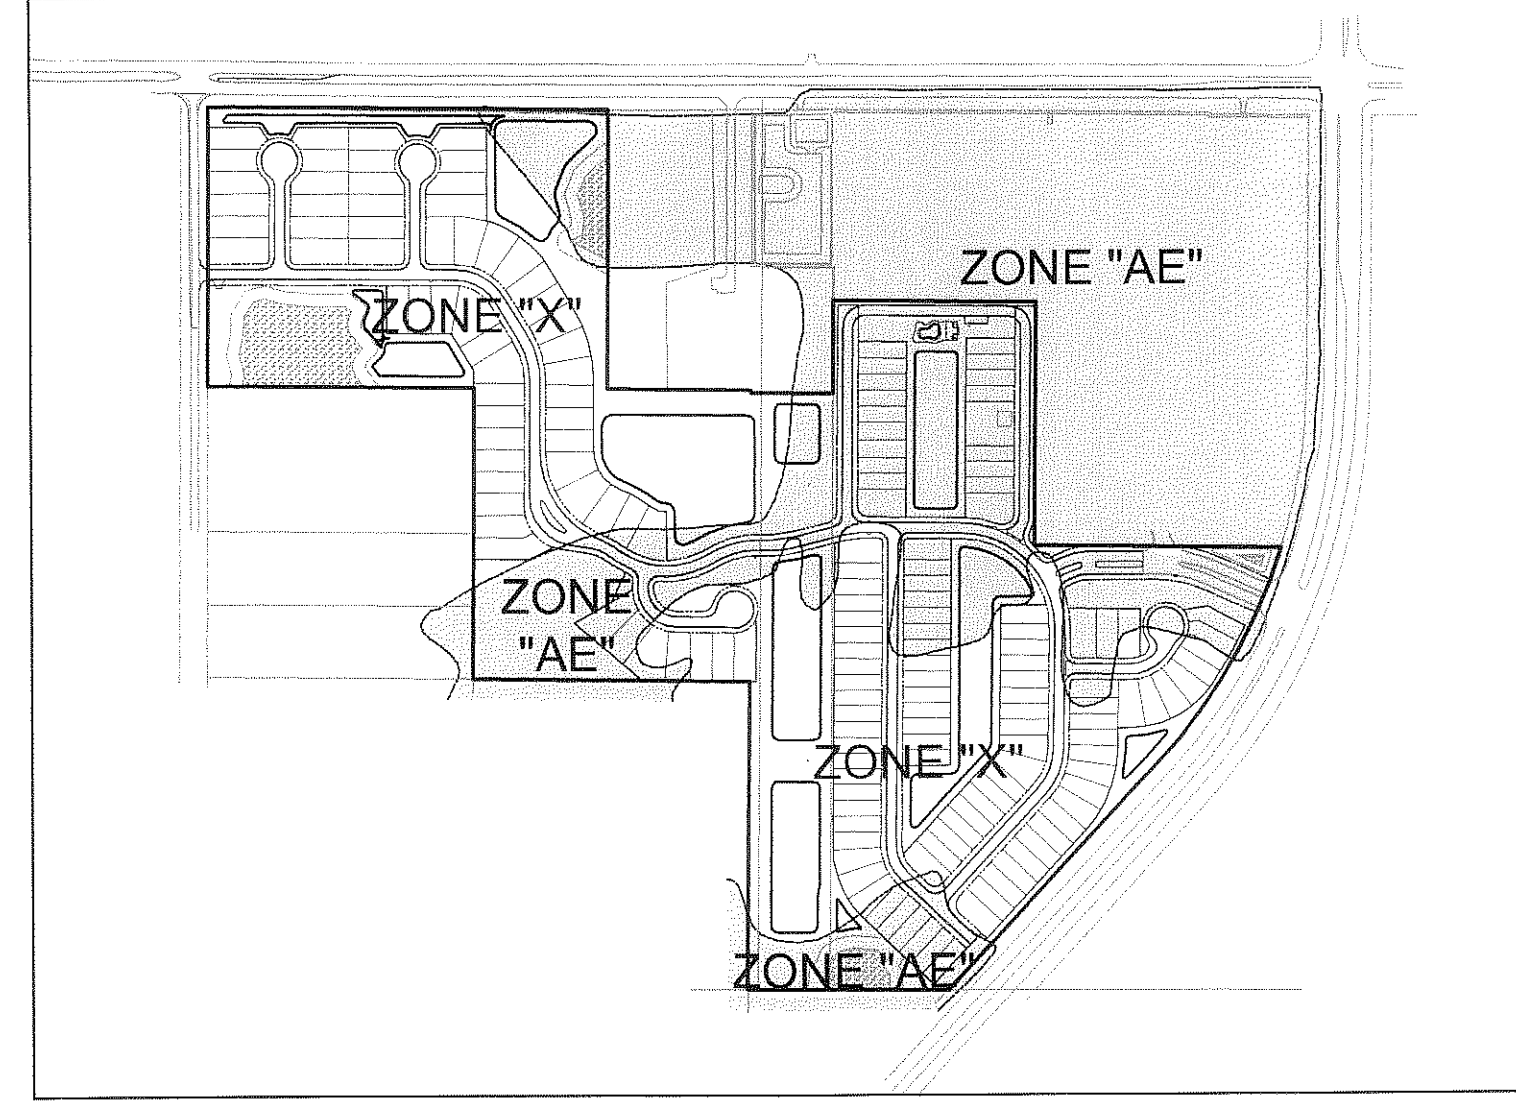

FEMA FLOOD MAP
PANEL NUMBER 125144 0332 E, DATED SEPTEMBER 3, 1992

WALDROP ENGINEERING

CIVIL ENGINEERING &
LAND DEVELOPMENT CONSULTANTS

25400 BONTA GRANDE DRIVE, SUITE 205 BONTA SPRINGS, FL 34135
P: 239-405-7777 F: 239-405-7599 EMAIL: info@waldropengineering.com

VERONA RESERVE

CLIENT: TAYLOR MORRISON OF FLORIDA, INC.

MASTER DRAINAGE PLAN

PLAN REVISIONS	
07/29/10	REVISED PER SARASOTA COUNTY COMMENTS
08/04/10	REVISED PER SARASOTA COUNTY COMMENTS
12/04/10	REVISED PER CLIENT COMMENTS
FLORIDA CERTIFICATE OF AUTHORIZATION #885	
NICHOLAS B. SPEACH, P.E. FL. CERTIFICATE NO. 70207	
SET NUMBER:	225-01-01
SHEET:	5

J:\225-01 Verona Reserve\AutoCAD\225-01-01 Concurrent Subdivision Plans\225-01-01.dwg Date: 11/20/10 2:18pm

MATCH LINE - SEE SHEET #6

MATCH LINE - SEE SHEET #8

MATCH LINE - SEE SHEET #9

EXISTING VENICE AVENUE

EXISTING DETENTION AREA

EXISTING JACARANDA COMMONS
SHOPPING CENTER

FONTANELLE CIRCLE

PARK AND PICNIC AREA

CLUBHOUSE

LAKE 1


LITTORAL AREA
0.31 AC

LEGEND

- BASIN BOUNDARY
- RIGHT OF WAY LINE
- EASEMENT LINE
- EDGE OF WATER
- 100 YR ELEVATION
- TRACT LINE
- LOT LINE
- WETLAND BOUNDARY
- SWALE

-Z-
SCALE: 1" = 40'

WALDROP
ENGINEERING

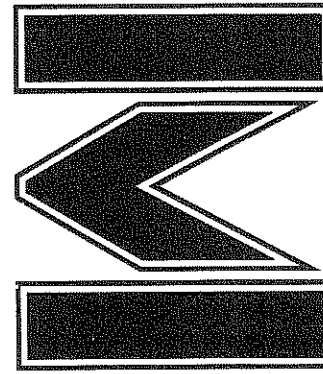

CIVIL ENGINEERING &
LAND DEVELOPMENT CONSULTANTS
29100 BONITA GRANDE DRIVE - SUITE 305 BONITA SPRINGS, FL 34135
P: 239-405-7777 F: 239-405-7599 EMAIL: info@waldropengineering.com

VERONA RESERVE

CLIENT: TAYLOR MORRISON OF FLORIDA, INC.

DRAINAGE SITE PLAN (B)

PLAN REVISIONS

NO.	REVISION
1	REVISED PER SARASOTA COUNTY COMMENTS
2	REVISED PER SARASOTA COUNTY COMMENTS
3	REVISED PER CLIENT COMMENTS

FLORIDA CERTIFICATE OF AUTHORIZATION #0003





NICHOLAS B. SPECKLE, P.E.
FL. CERTIFICATE NO. 70237

SET NUMBER: 225-01-01


SHEET: 7

1/22/25-01 Verona Reserve Area CADD225-01-01 Concurrent Subdivision Plans/Record225010108.dwg Dec 14, 2010 - 21:0pm

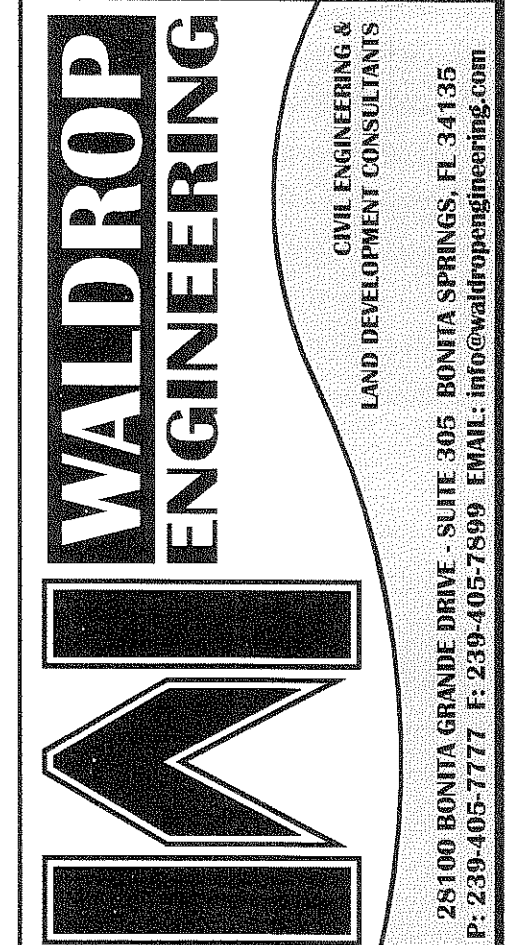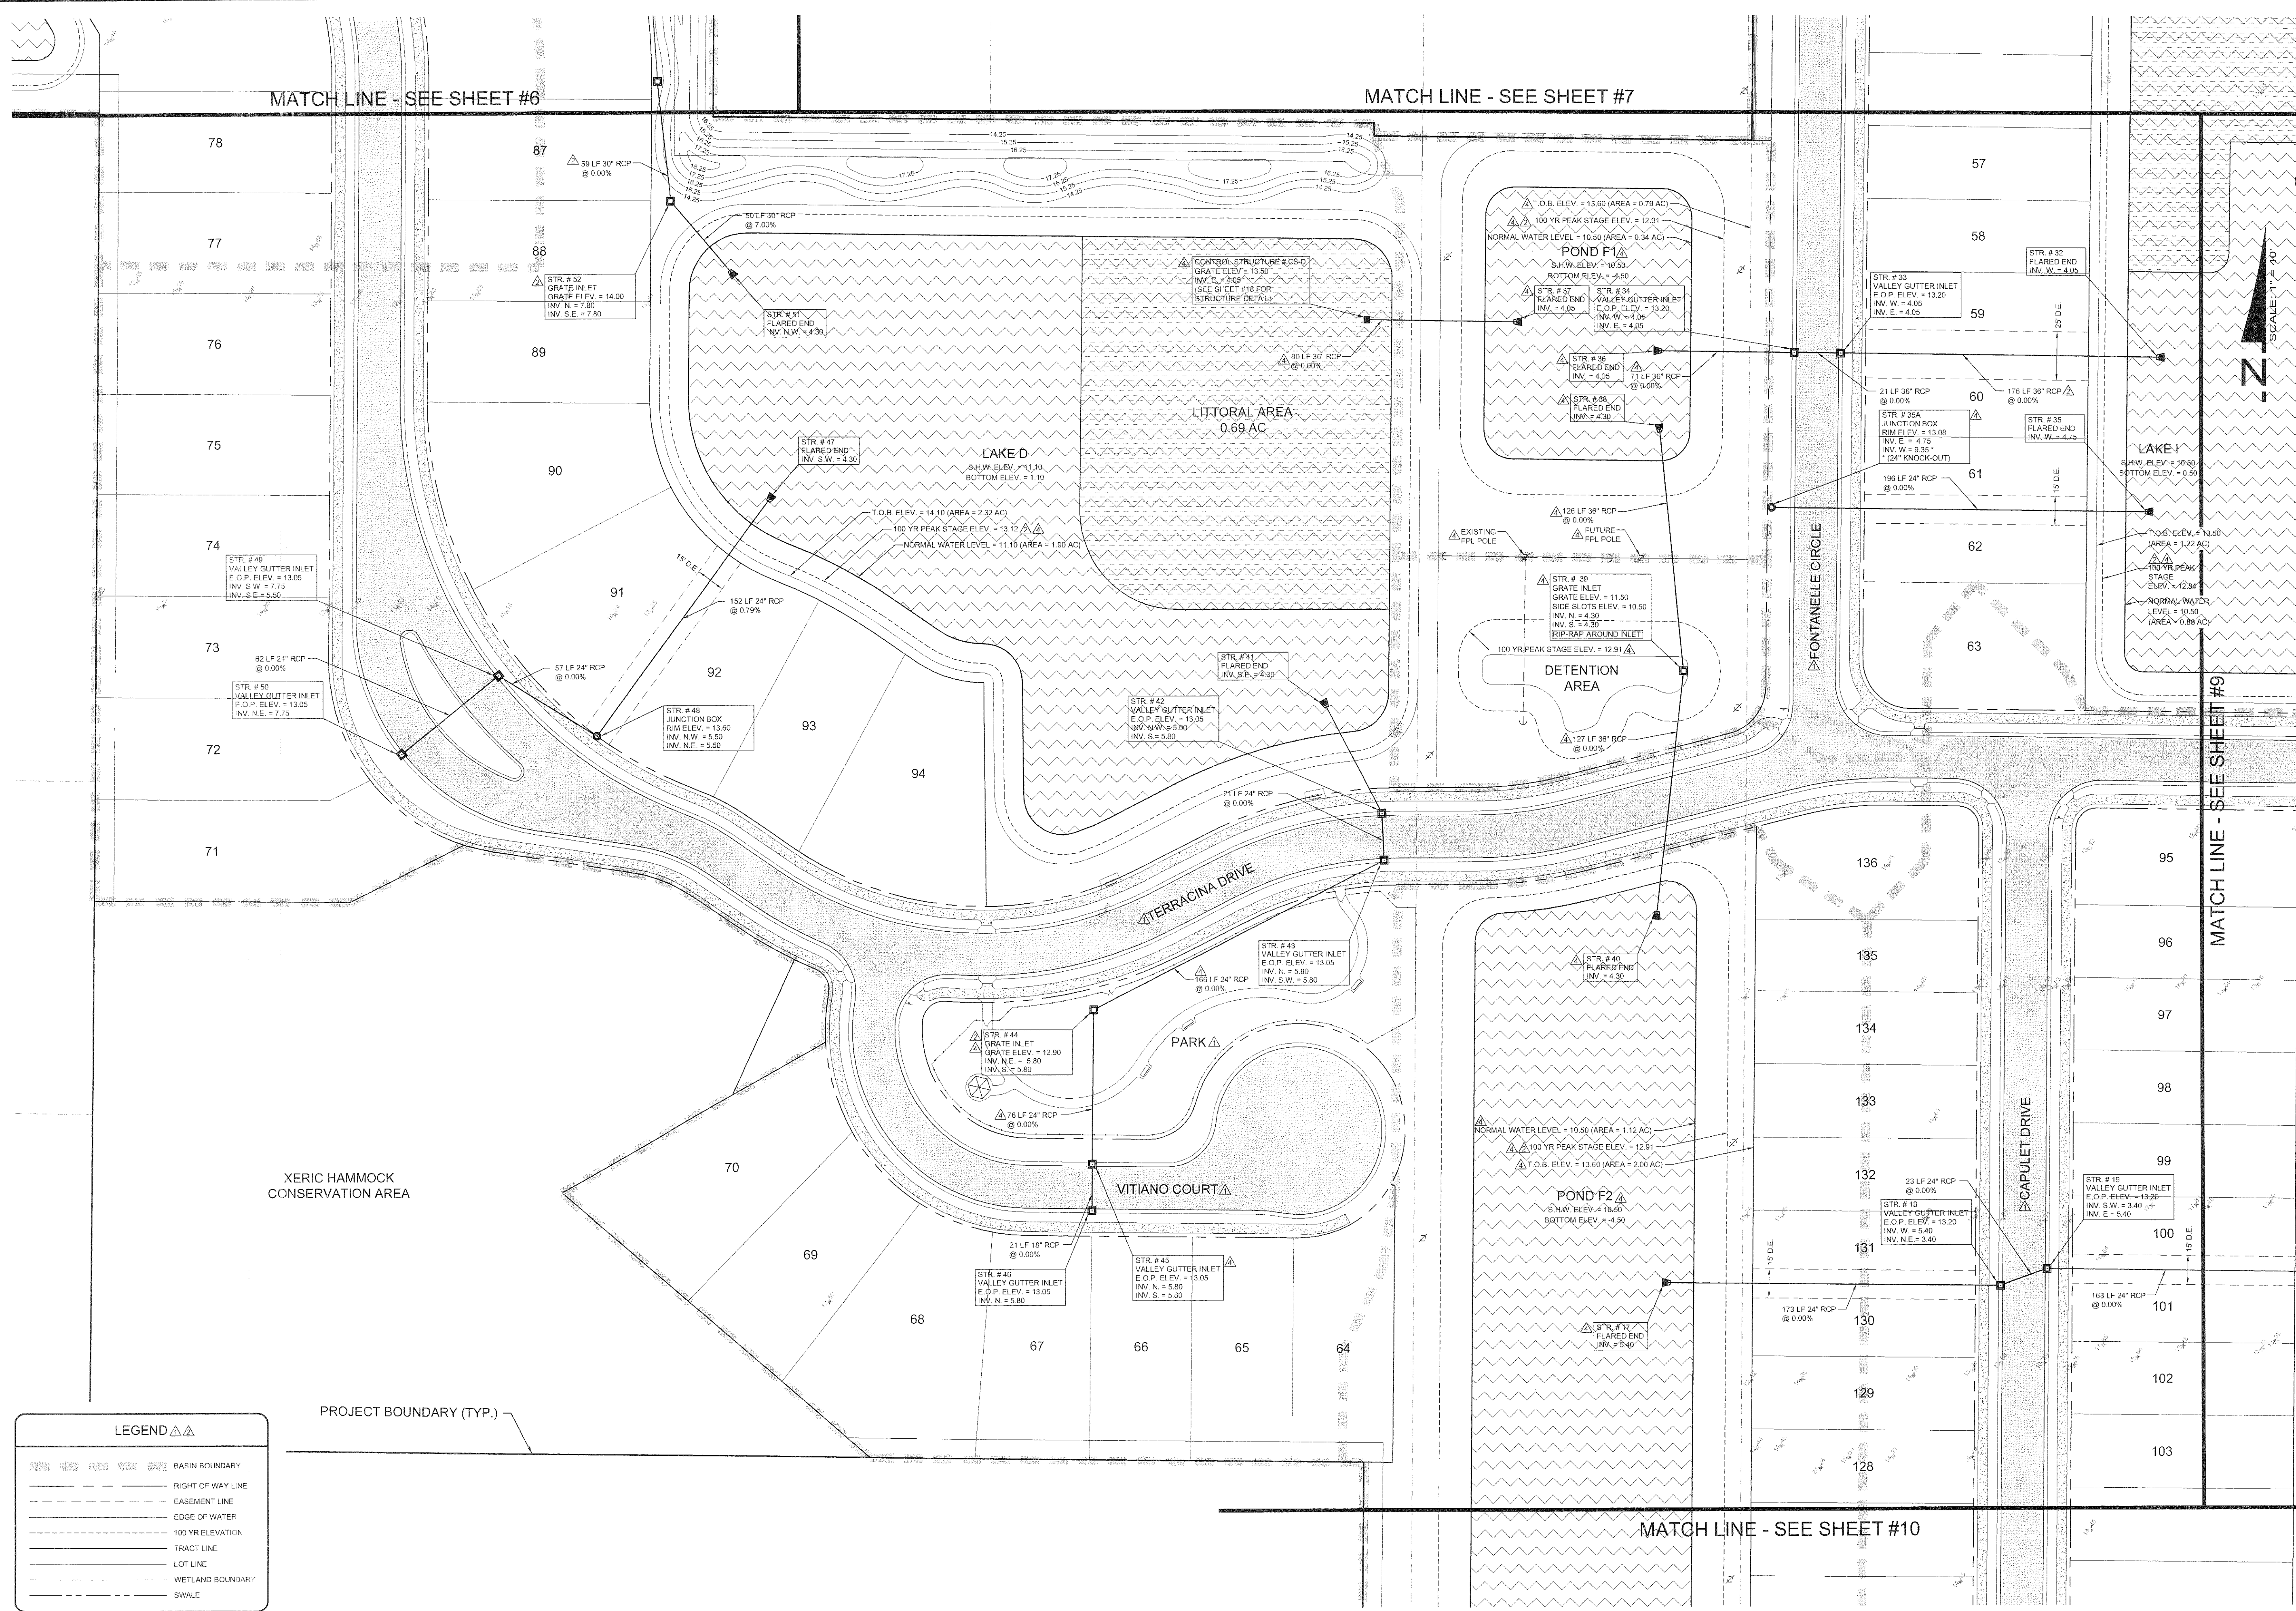


VERONA RESERVE
CLIENT: TAYLOR MORRISON OF FLORIDA, INC.
DRAINAGE SITE PLAN (C)

PLAN REVISIONS	
1/22/25	REVISED PER SARASOTA COUNTY COMMENTS
1/22/25	REVISED PER SARASOTA COUNTY COMMENTS
1/22/25	REVISED PER CLIENT COMMENTS
FLORIDA CERTIFICATE OF AUTHORIZATION 13635	
 NICHOLAS R. SPACHL, P.E. FLORIDA CERTIFICATE NO. 10207	
SET NUMBER:	225-01-01
SHEET:	8

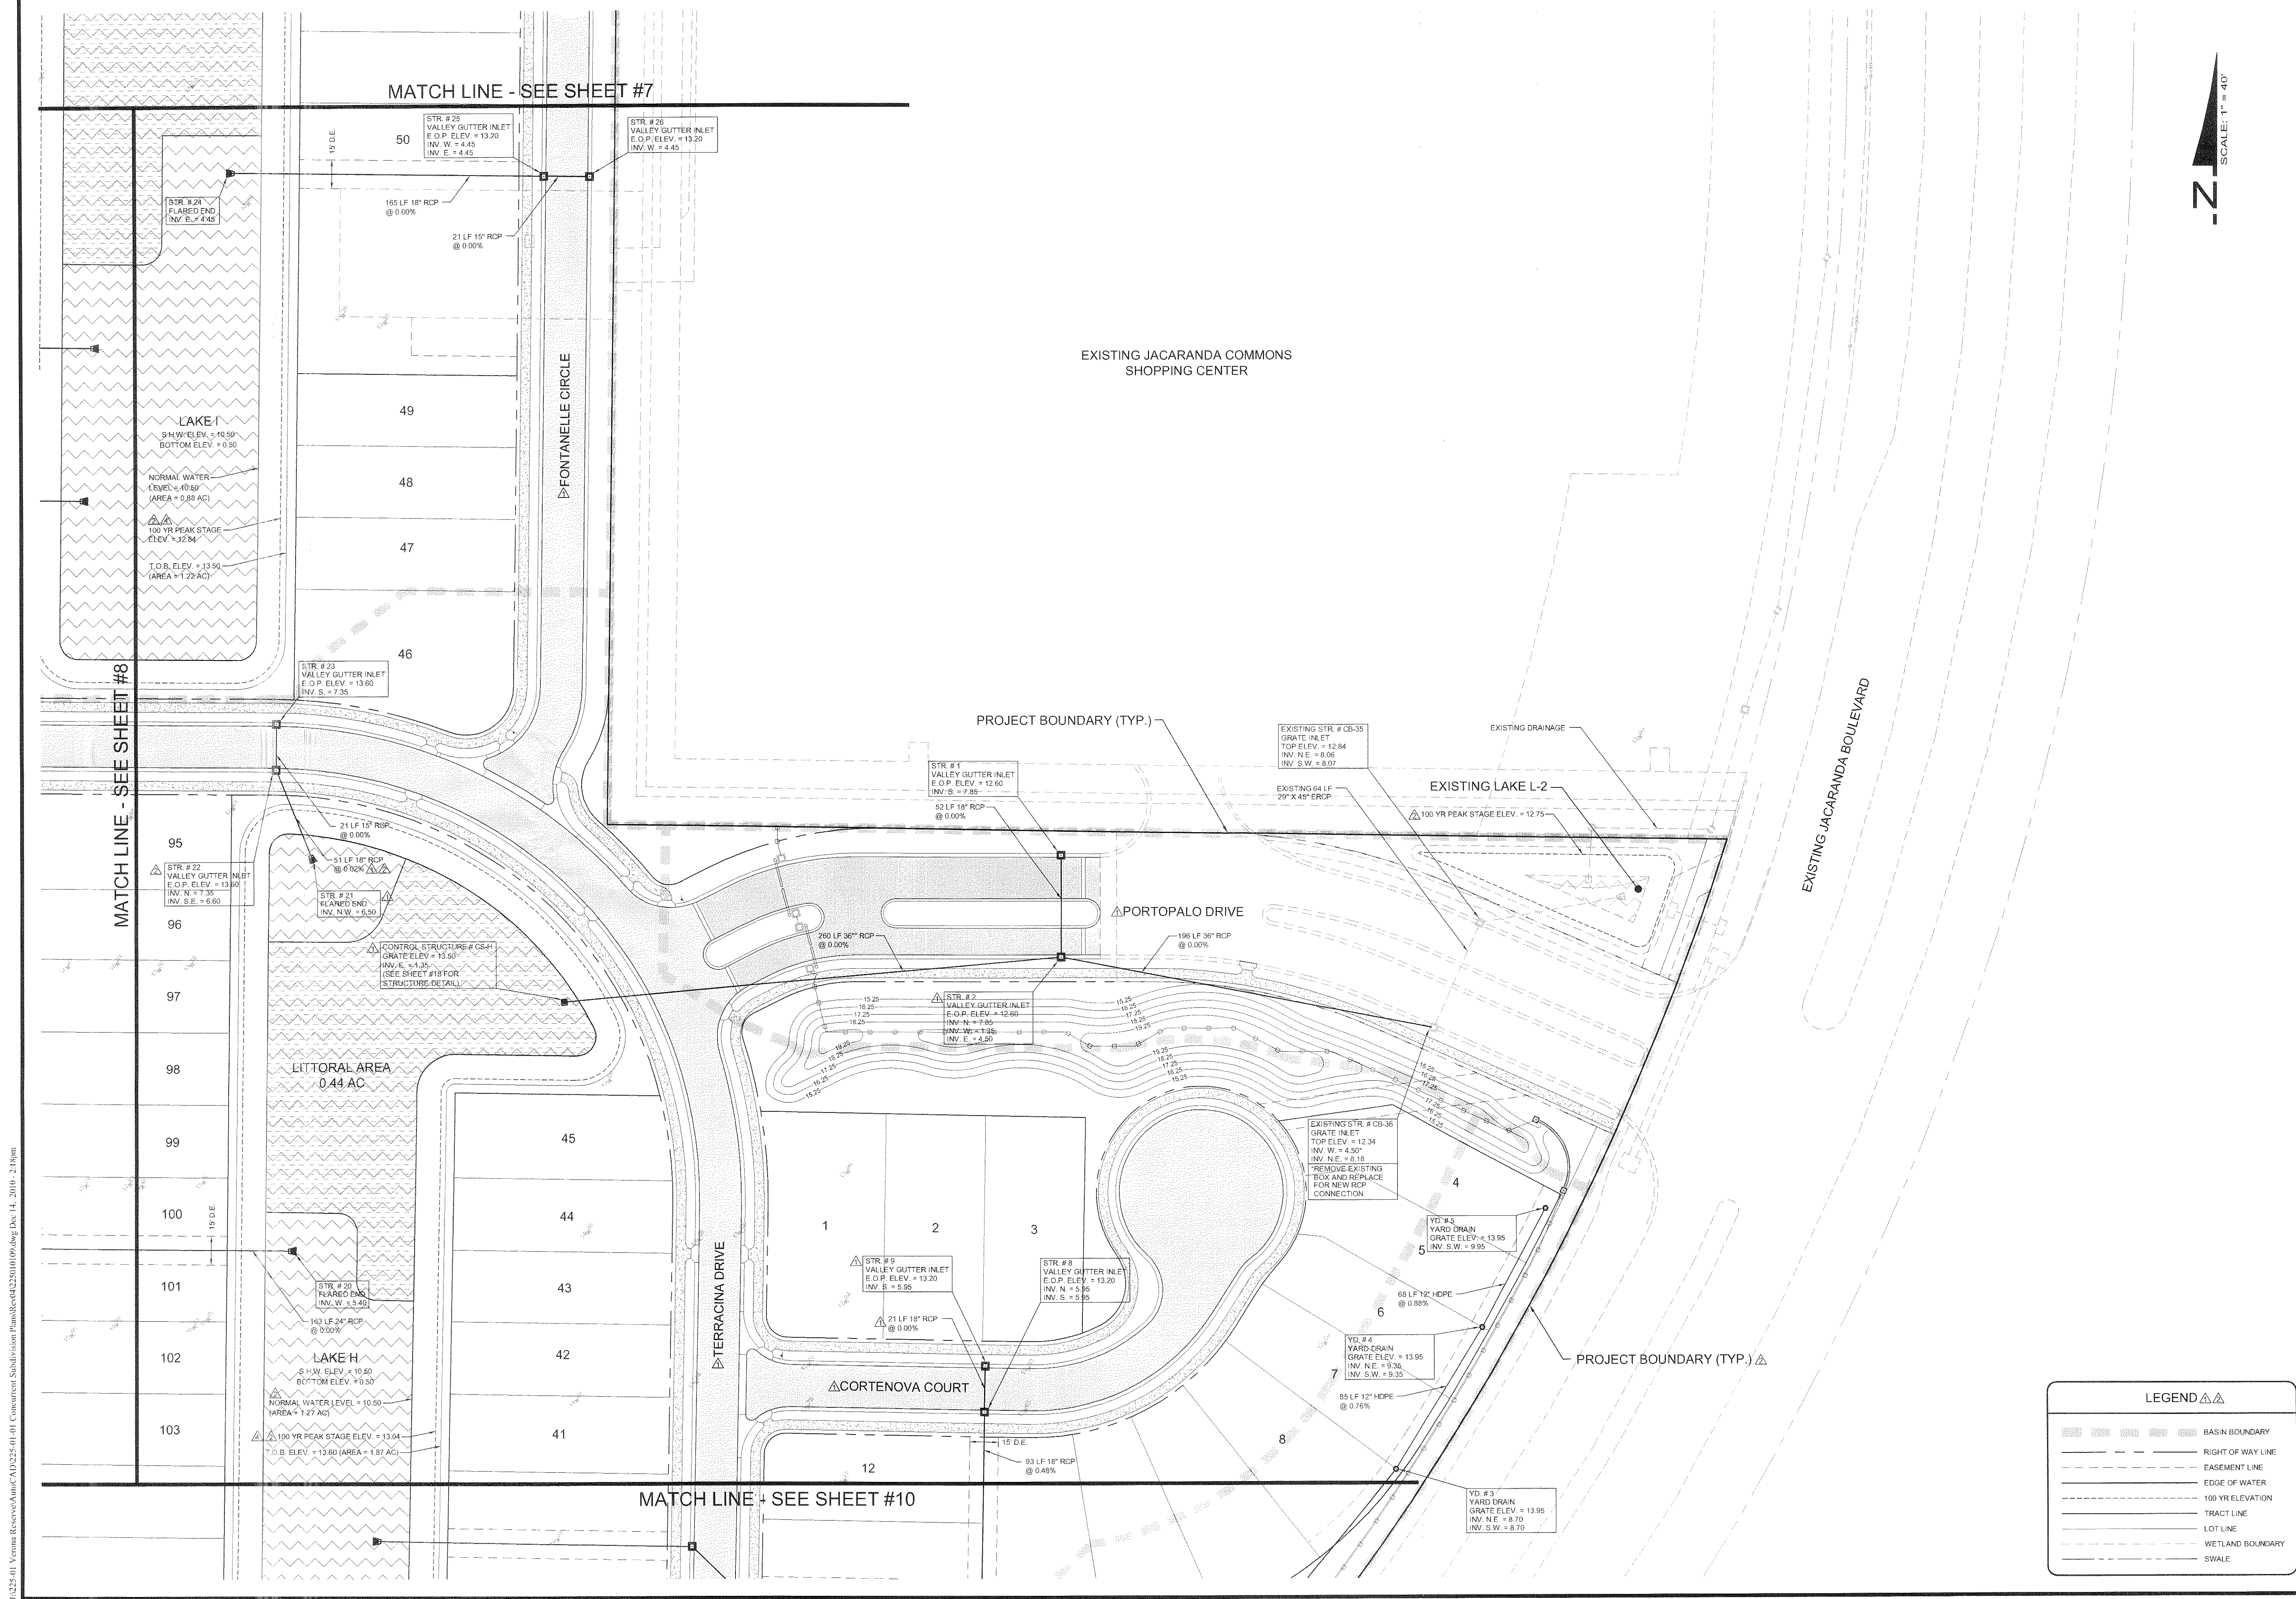

-Z-
SCALE: 1" = 40'

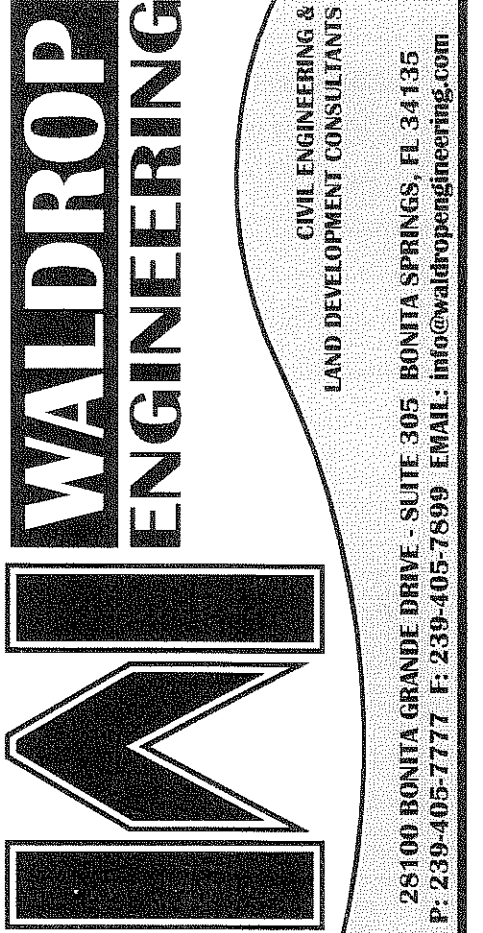


VERONA RESERVE

CLIENT: TAYLOR MORRISON OF FLORIDA, INC.

DRAINAGE SITE PLAN (D)

PLAN REVISIONS	
10/28/10	REVISED PER SARASOTA COUNTY COMMENTS
09/14/10	REVISED PER SARASOTA COUNTY COMMENTS
12/14/10	REVISED PER CLIENT COMMENTS
FLORIDA CERTIFICATE OF AUTHORIZATION #1606	
NICHOLAS B. SPEAR, P.E. LICENSE # 70207	
12/15/10	
SET NUMBER: 225-01-01	
SHEET: 9	

1/22/25-01 Verona Reserve Area CAD225-01-01 Concurrent Subdivision Plans/MapCAD22501010.dwg Dec. 14, 2010 - 2:18pm

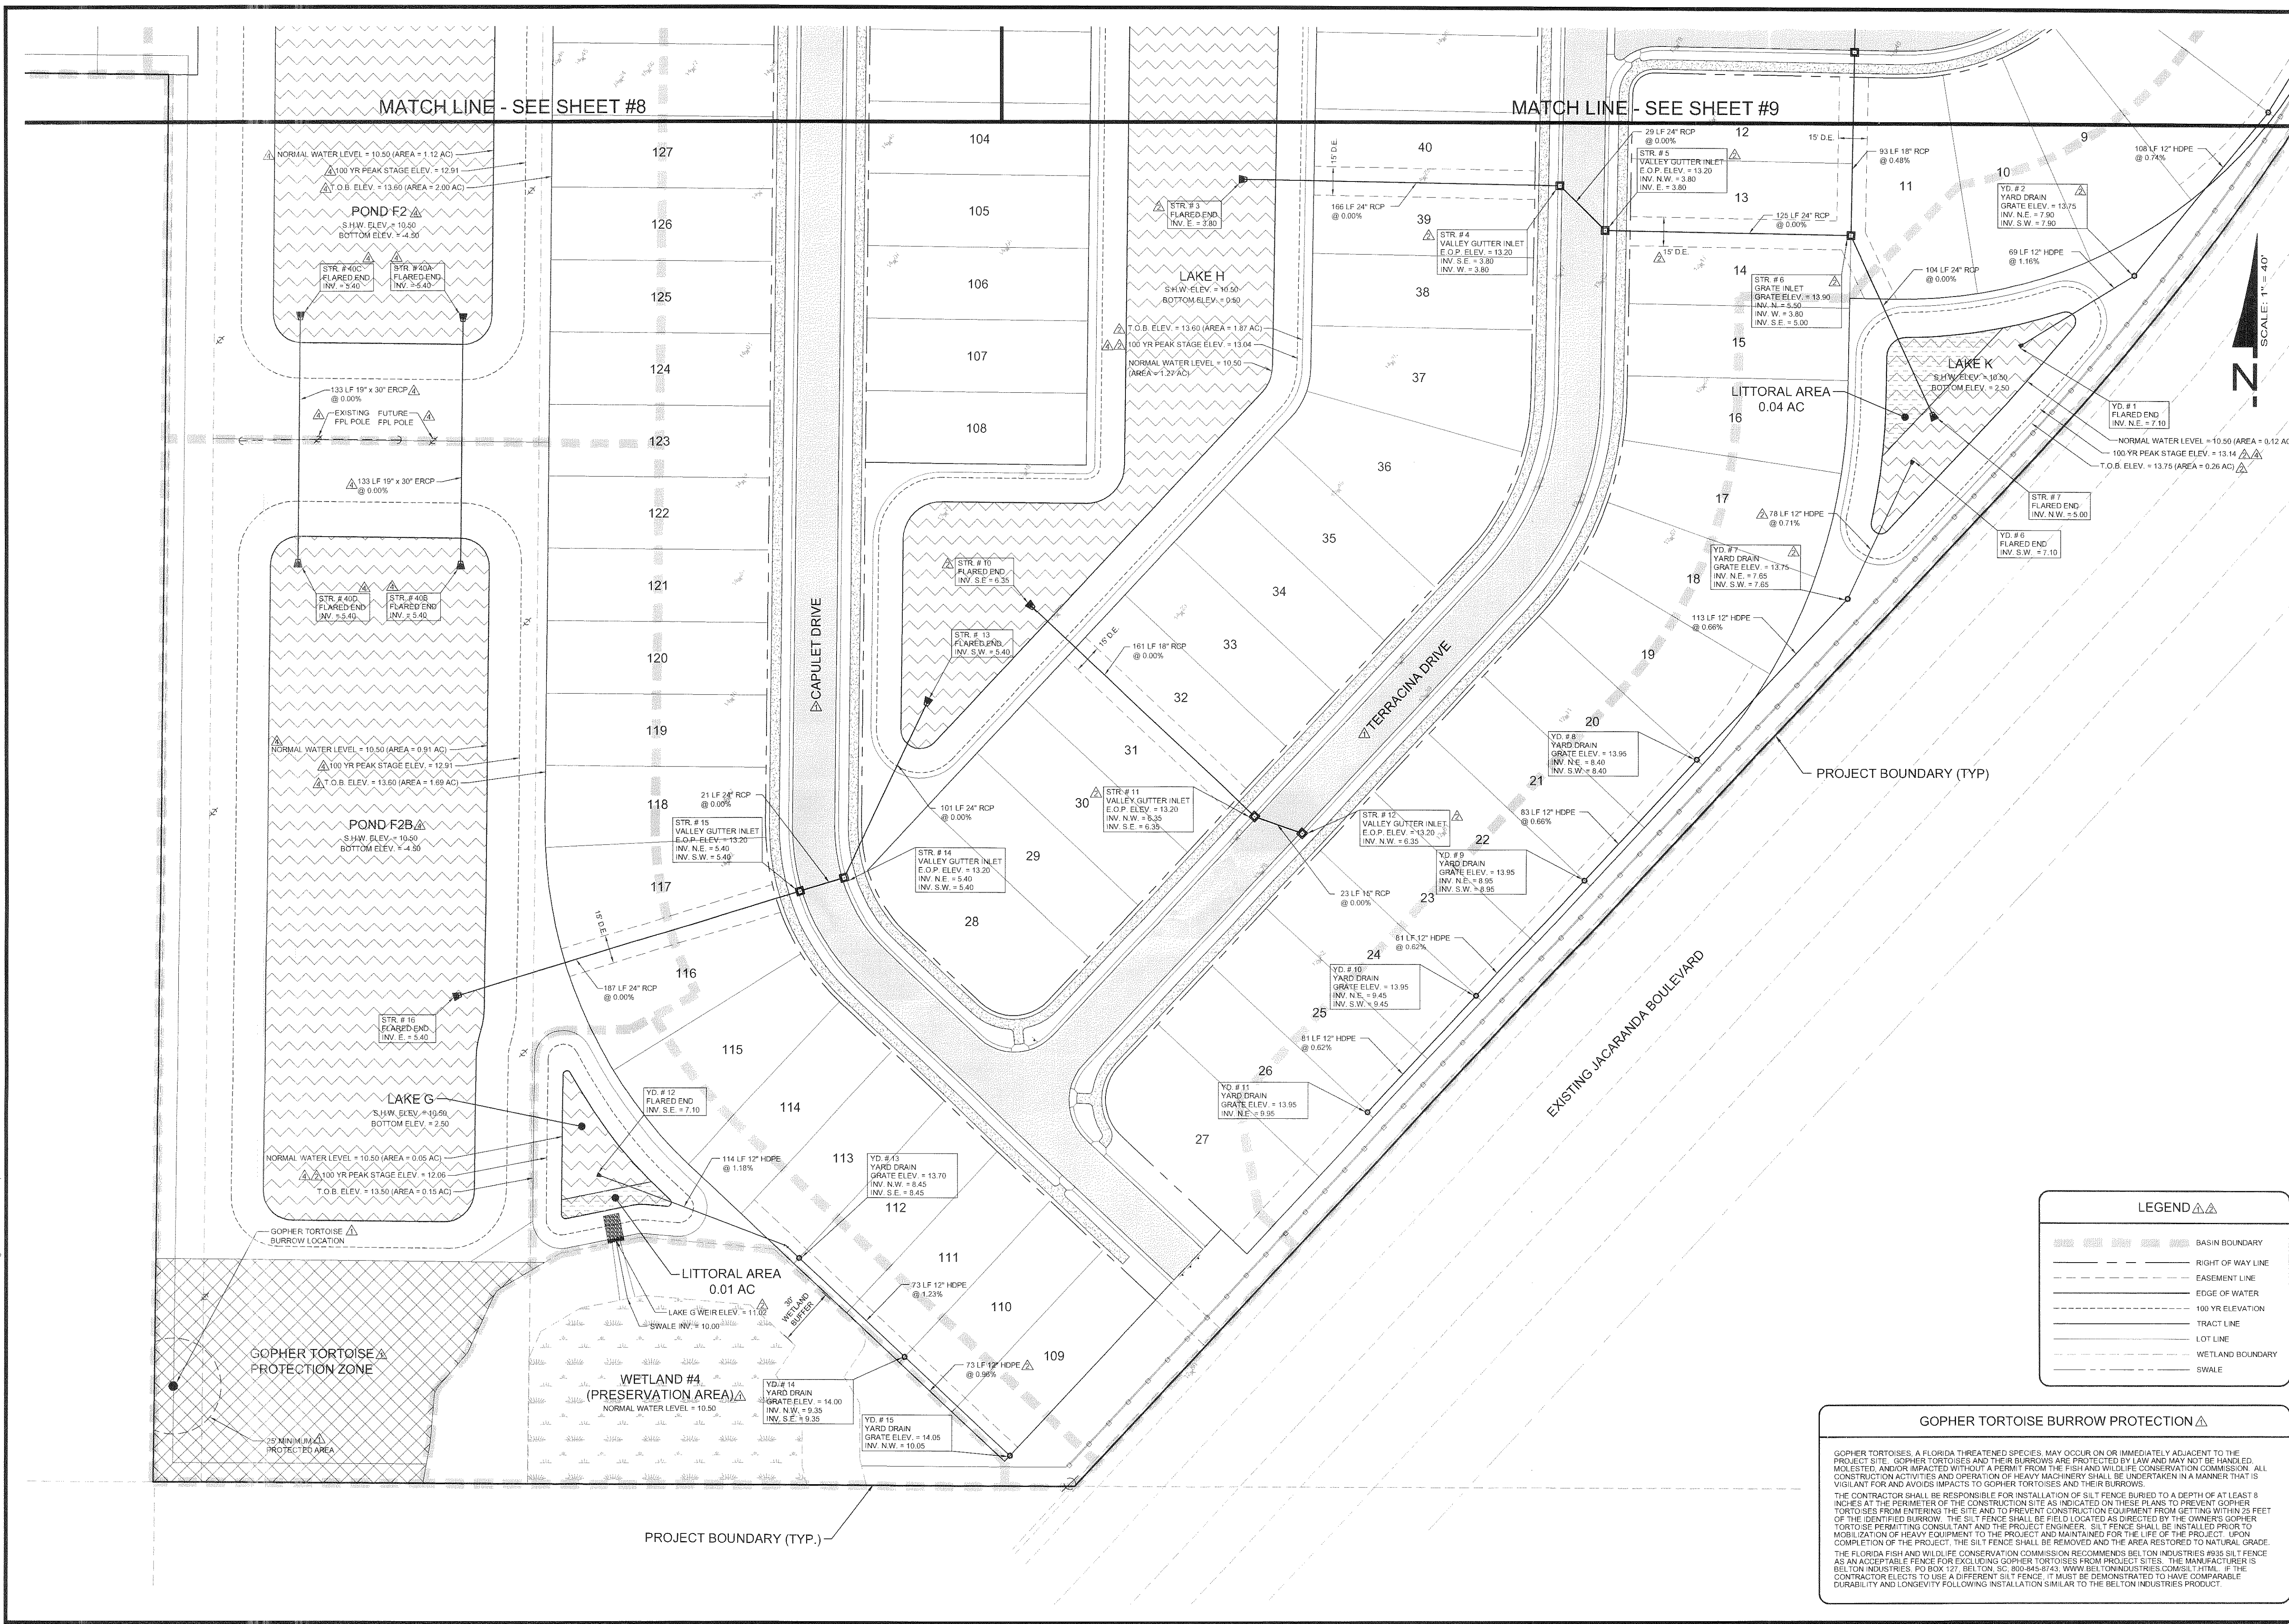

LEGEND	
	BASIN BOUNDARY
	RIGHT OF WAY LINE
	EASEMENT LINE
	EDGE OF WATER
	100 YR ELEVATION
	TRACT LINE
	LOT LINE
	WETLAND BOUNDARY
	SWALE

GOPHER TORTOISE BURROW PROTECTION

GOPHER TORTOISES, A FLORIDA THREATENED SPECIES, MAY OCCUR ON OR IMMEDIATELY ADJACENT TO THE PROJECT SITE. GOPHER TORTOISES AND THEIR BURROWS ARE PROTECTED BY LAW AND MAY NOT BE HANDLED, MOLESTED, AND/OR IMPACTED WITHOUT A PERMIT FROM THE FISH AND WILDLIFE CONSERVATION COMMISSION. ALL CONSTRUCTION ACTIVITIES AND OPERATION OF HEAVY MACHINERY SHALL BE UNDERTAKEN IN A MANNER THAT IS VIGILANT FOR AND AVOIDS IMPACTS TO GOPHER TORTOISES AND THEIR BURROWS.

THE CONTRACTOR SHALL BE RESPONSIBLE FOR INSTALLATION OF SILT FENCE BURIED TO A DEPTH OF AT LEAST 8 INCHES AT THE PERIMETER OF THE CONSTRUCTION SITE AS INDICATED ON THESE PLANS TO PREVENT GOPHER TORTOISES FROM ENTERING THE SITE AND TO PREVENT CONSTRUCTION EQUIPMENT FROM GETTING WITHIN 25 FEET OF THE IDENTIFIED BURROW. THE SILT FENCE SHALL BE FIELD LOCATED AS DIRECTED BY THE OWNERS GOPHER TORTOISE PERMITTING CONSULTANT AND THE PROJECT ENGINEER. SILT FENCE SHALL BE INSTALLED PRIOR TO MOBILIZATION OF HEAVY EQUIPMENT TO THE PROJECT AND MAINTAINED FOR THE LIFE OF THE PROJECT. UPON COMPLETION OF THE PROJECT, THE SILT FENCE SHALL BE REMOVED AND THE AREA RESTORED TO NATURAL GRADE.

THE FLORIDA FISH AND WILDLIFE CONSERVATION COMMISSION RECOMMENDS BELTON INDUSTRIES #935 SILT FENCE AS AN ACCEPTABLE FENCE FOR EXCLUDING GOPHER TORTOISES FROM PROJECT SITES. THE MANUFACTURER IS BELTON INDUSTRIES, PO BOX 127, BELTON, SC 29004-0127. WWW.BELTONINDUSTRIES.COM/SILT.FENCE. IF THE CONTRACTOR ELECTS TO USE A DIFFERENT SILT FENCE, IT MUST BE DEMONSTRATED TO HAVE COMPARABLE DURABILITY AND LONGEVITY FOLLOWING INSTALLATION SIMILAR TO THE BELTON INDUSTRIES PRODUCT.

WALDROP ENGINEERING

CIVIL ENGINEERING &
LAND DEVELOPMENT CONSULTANTS
254100 SANTA GRANDE DRIVE SUITE 305 BONTA SPRINGS, FL 34135
P: 239-405-7777 F: 239-405-7599 EMAIL: info@waldropeng.com


VERONA RESERVE

CLIENT: TAYLOR MORRISON OF FLORIDA, INC.

DRAINAGE SITE PLAN (E)

PLAN REVISIONS	
01/22/10	REVISED PER SARASOTA COUNTY COMMENTS
09/14/10	REVISED PER SARASOTA COUNTY COMMENTS
12/14/10	REVISED PER CLIENT COMMENTS
FLORIDA CERTIFICATE OF AUTHORIZATION #9856	
NICHOLAS E. SPEACHT, P.E.	
SET NUMBER:	225-01-01
SHEET:	10

1222-01 Verona Reserve Area Civil Subdivision Plan (Rev. 02/20/11) 11.dwg (Dec 14, 2010 - 2:16pm)

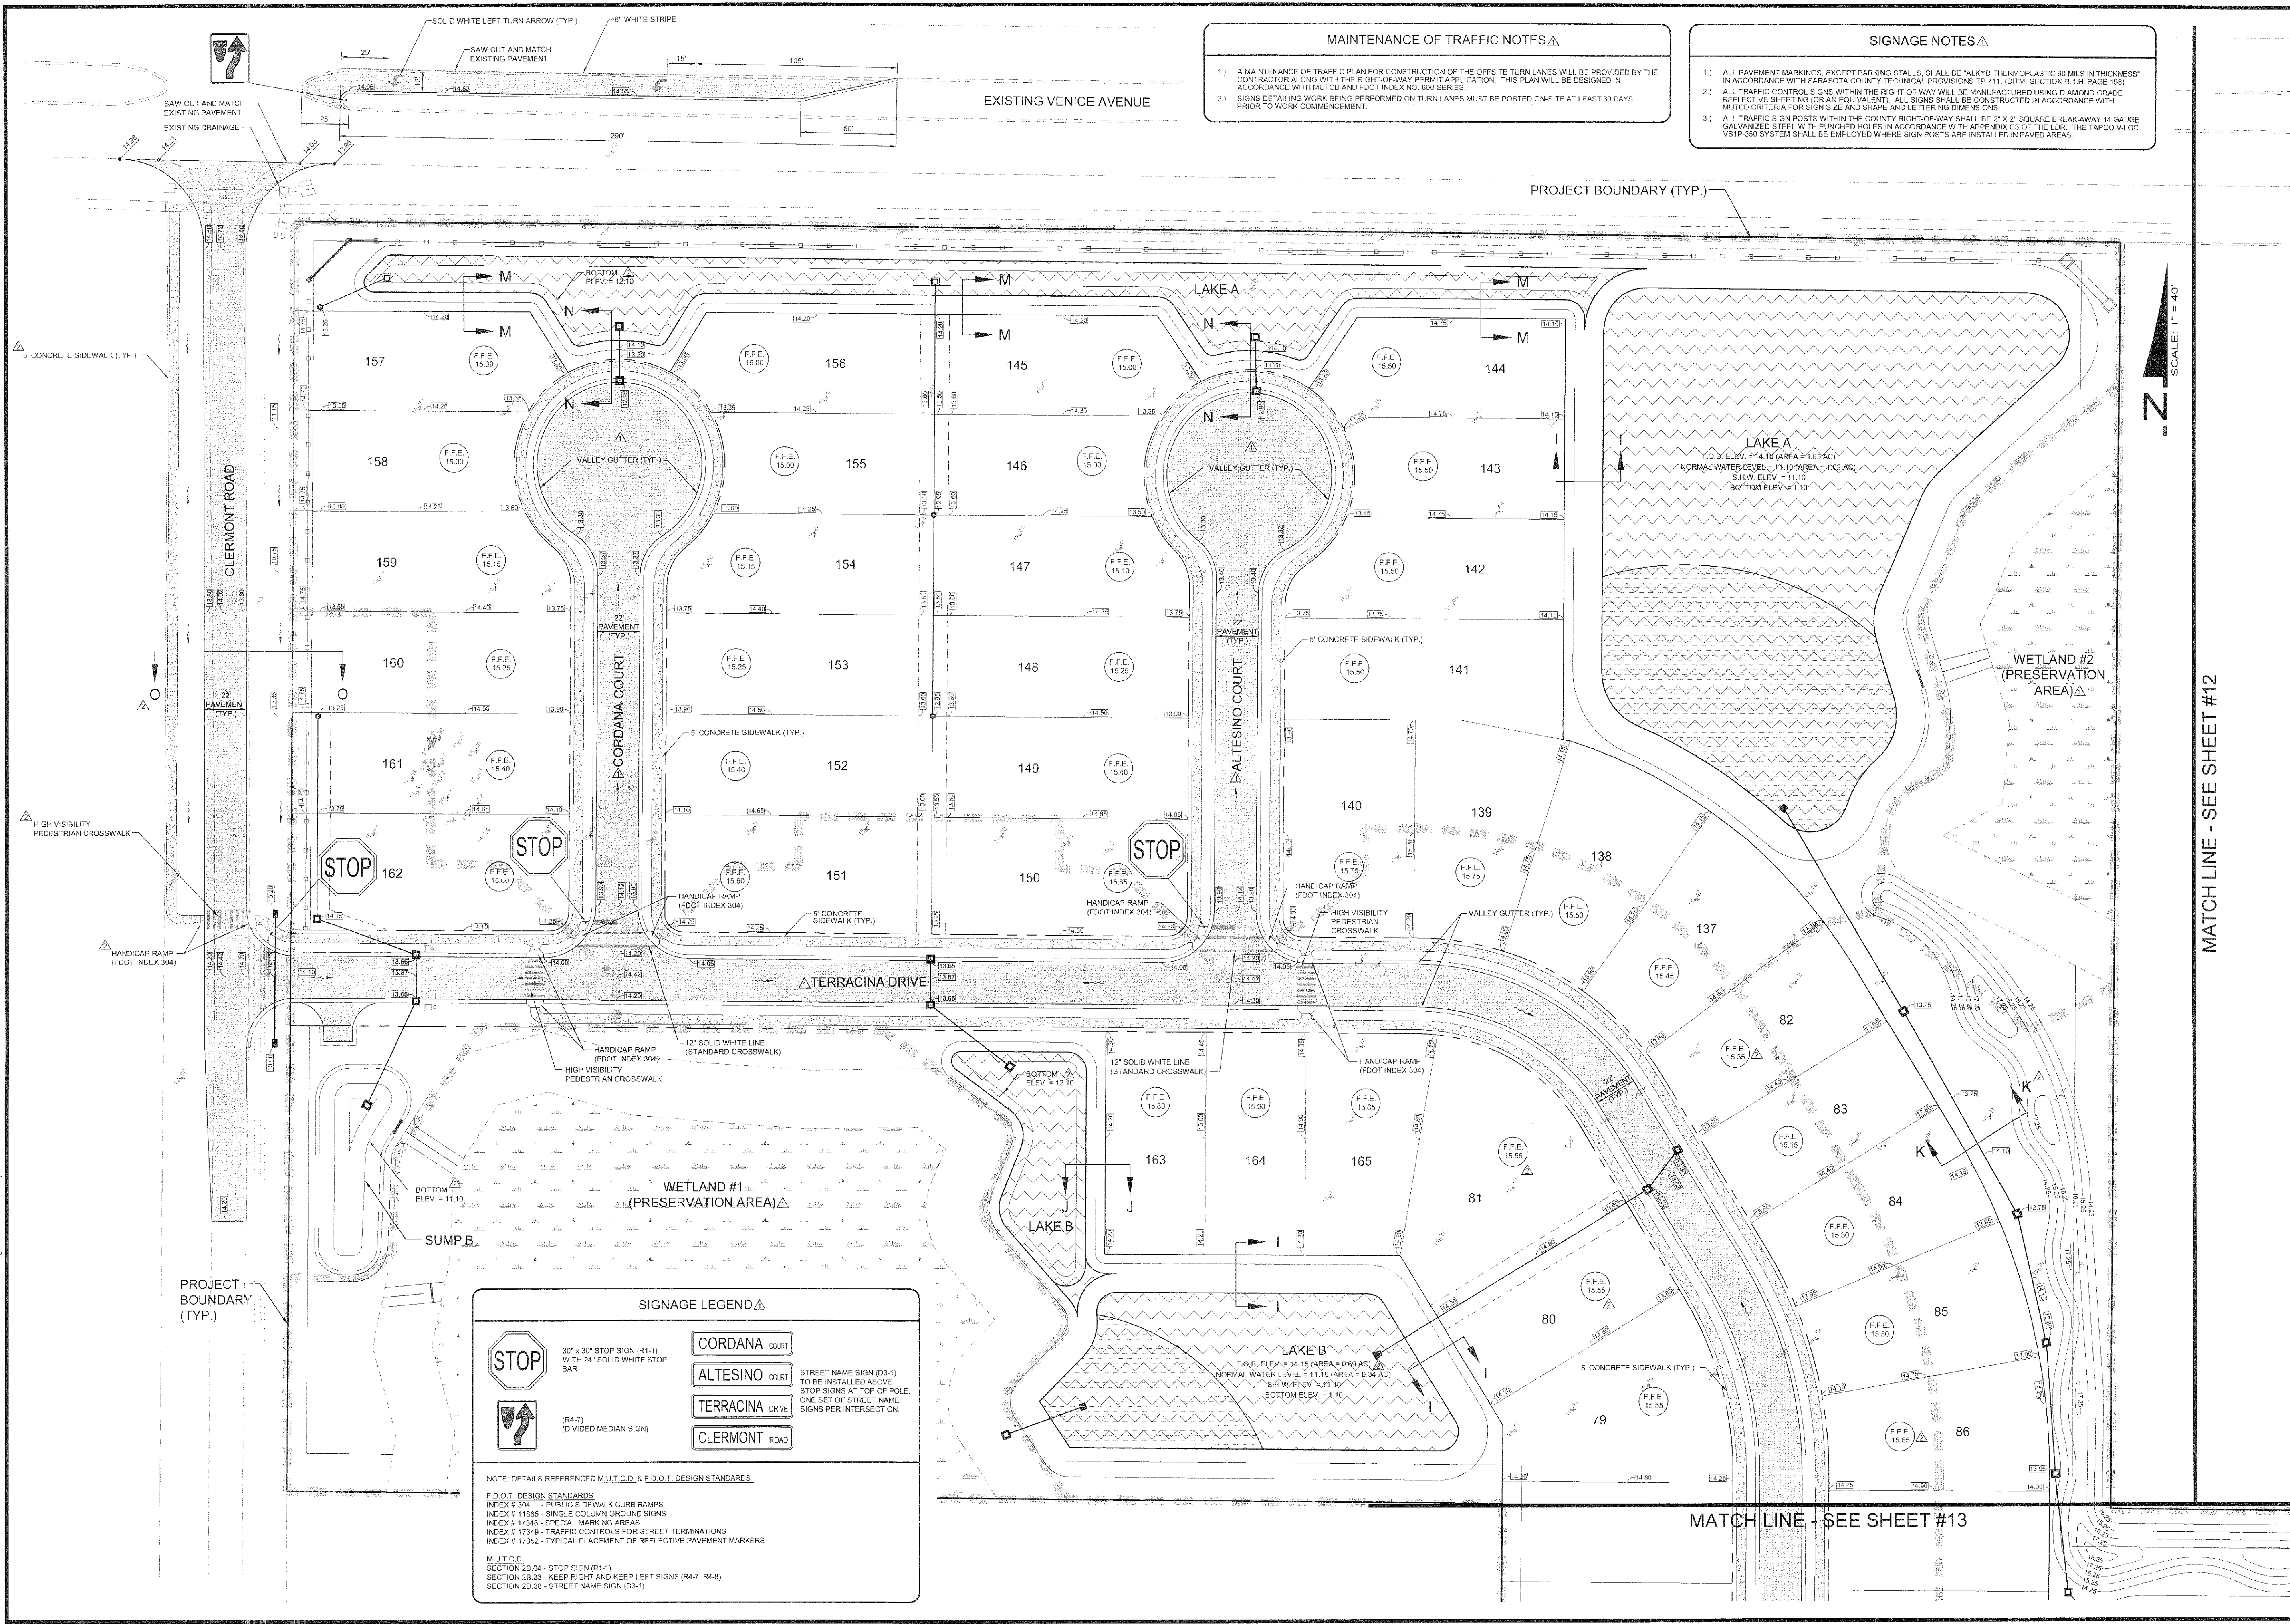

MAINTENANCE OF TRAFFIC NOTES

1.) A MAINTENANCE OF TRAFFIC PLAN FOR CONSTRUCTION OF THE OFFSITE TURN LANES WILL BE PROVIDED BY THE CONTRACTOR ALONG WITH THE RIGHT-OF-WAY PERMIT APPLICATION. THIS PLAN WILL BE DESIGNED IN ACCORDANCE WITH MUTCD AND FDOT INDEX NO. 400 SERIES.

2.) SIGNS DETAILING WORK BEING PERFORMED ON TURN LANES MUST BE POSTED, ON-SITE AT LEAST 30 DAYS PRIOR TO WORK COMMENCEMENT.

SIGNAGE NOTES

1.) ALL PAVEMENT MARKINGS, EXCEPT PARKING STALLS, SHALL BE "ALKYD THERMOPLASTIC 90 MILS IN THICKNESS" IN ACCORDANCE WITH SARASOTA COUNTY TECHNICAL PROVISIONS TP 711 (D.T.M. SECTION B.1.H. PAGE 108).

2.) ALL TRAFFIC CONTROL SIGNS WITHIN THE RIGHT-OF-WAY WILL BE MANUFACTURED USING DIAMOND GRADE REFLECTIVE SHEETING (OR AN EQUIVALENT). ALL SIGNS SHALL BE CONSTRUCTED IN ACCORDANCE WITH MUTCD CRITERIA FOR SIGN SIZE AND SHAPE AND LETTERING DIMENSIONS.

3.) ALL TRAFFIC SIGN POSTS WITHIN THE COUNTY RIGHT-OF-WAY SHALL BE 2" X 2" SQUARE BREAKAWAY 14 GAUGE GALVANIZED STEEL WITH PUNCHED HOLES IN ACCORDANCE WITH APPENDIX C3 OF THE LRP. THE TAPCO VALCO VSIP-350 SYSTEM SHALL BE EMPLOYED WHERE SIGN POSTS ARE INSTALLED IN PAVED AREAS.

SIGNAGE LEGEND

30" x 30" STOP SIGN (R1-1) WITH 24" SOLID WHITE STOP BAR

(R4-7) (DIVIDED MEDIAN SIGN)

CORDANA COURT

ALTESINO COURT

TERRACINA DRIVE

CLERMONT ROAD

STREET NAME SIGN (D3-1) TO BE INSTALLED ABOVE STOP SIGNS AT TOP OF POLE. ONE SET OF STREET NAME SIGNS PER INTERSECTION.

NOTE: DETAILS REFERENCED MUTCD & FDOT DESIGN STANDARDS.

FDOT DESIGN STANDARDS

INDEX # 304 - PUBLIC SIDEWALK CURB RAMP

INDEX # 1185 - SINGLE COLUMN GROUND SIGNS

INDEX # 17340 - SPECIAL MARKING AREAS

INDEX # 17349 - TRAFFIC CONTROLS FOR STREET TERMINATIONS

INDEX # 17352 - TYPICAL PLACEMENT OF REFLECTIVE PAVEMENT MARKERS

MUTCD

SECTION 2B.04 - STOP SIGN (R1-1)

SECTION 2B.33 - KEEP RIGHT AND KEEP LEFT SIGNS (R4-7, R4-8)

SECTION 2D.38 - STREET NAME SIGN (D3-1)

WALDROP ENGINEERING

CIVIL ENGINEERING & LAND DEVELOPMENT CONSULTANTS

25100 BONTA GRANDE DRIVE - SUITE 305 BONTA SPRINGS, FL 34135
P: 239-405-7777 F: 239-405-7599 EMAIL: info@waldropengineering.com

VERONA RESERVE

CLIENT: TAYLOR MORRISON OF FLORIDA, INC.

PAVING, SIGNAGE & GRADING SITE PLAN (A)

PLAN REVISIONS

NO.	DATE	REVISION
1	07/20/10	REVISED PER SARASOTA COUNTY COMMENTS
2	08/14/10	REVISED PER SARASOTA COUNTY COMMENTS

FLORIDA CERTIFICATE OF AUTHORIZATION #0636

NICHOLAS S. SPURCH, P.E.
FLORIDA CERTIFICATE NO. 79207

12/15/10

SET NUMBER: 225-01-01

SHEET: 11

A:\225-01 Verona Reserve\AutoCAD\225-01-01 Consultant Subdivision Plans\225-01-01.dwg Dec 14, 2010 - 2:38pm

MATCH LINE - SEE SHEET #11

EXISTING VENICE AVENUE

EXISTING DRY DETENTION AREA

EXISTING JACARANDA COMMONS
SHOPPING CENTER

PROJECT BOUNDARY (TYP.)

MATCH LINE - SEE SHEET #13

MATCH LINE - SEE SHEET #14

SIGNAGE NOTES

- 1) ALL PAVEMENT MARKINGS, EXCEPT PARKING STALLS, SHALL BE "ALKYD THERMOPLASTIC 80 MILS IN THICKNESS" IN ACCORDANCE WITH SARASOTA COUNTY TECHNICAL PROVISIONS TP 711, (DITM, SECTION B.1.H, PAGE 108).
- 2) ALL TRAFFIC CONTROL SIGNS WITHIN THE RIGHT-OF-WAY WILL BE MANUFACTURED USING DIAMOND GRADE REFLECTIVE SHEETING (OR AN EQUIVALENT). ALL SIGNS SHALL BE CONSTRUCTED IN ACCORDANCE WITH MUTCD CRITERIA FOR SIGN SIZE AND SHAPE AND LETTERING DIMENSIONS.
- 3) ALL TRAFFIC SIGN POSTS WITHIN THE COUNTY RIGHT-OF-WAY SHALL BE 2" X 2" SQUARE BREAK-AWAY 14 GAUGE GALVANIZED STEEL WITH PUNCHED HOLES IN ACCORDANCE WITH APPENDIX C3 OF THE LOR. THE TAPCO V-LOC VS1P-350 SYSTEM SHALL BE EMPLOYED WHERE SIGN POSTS ARE INSTALLED IN PAVED AREAS.

MAINTENANCE OF TRAFFIC NOTES

- 1) A MAINTENANCE OF TRAFFIC PLAN FOR CONSTRUCTION OF THE OFF-SITE TURN LANES WILL BE PROVIDED BY THE CONTRACTOR ALONG WITH THE RIGHT-OF-WAY PERMIT APPLICATION. THIS PLAN WILL BE DESIGNED IN ACCORDANCE WITH MUTCD AND FDOT INDEX NO. 800 SERIES.
- 2) SIGNS DETAILING WORK BEING PERFORMED ON TURN LANES MUST BE POSTED ON-SITE AT LEAST 30 DAYS PRIOR TO WORK COMMENCEMENT.

SIGNAGE LEGEND




(FDOT INDEX # 17355)
(HANDICAP PARKING SIGN)

NOTE: DETAILS REFERENCED M.U.T.C.D. & F.D.O.T. DESIGN STANDARDS

F.D.O.T. DESIGN STANDARDS
INDEX # 304 - PUBLIC SIDEWALK CURB RAMPS
INDEX # 11865 - SINGLE COLUMN GROUND SIGNS
INDEX # 17346 - SPECIAL MARKING AREAS
INDEX # 17349 - TRAFFIC CONTROLS FOR STREET TERMINATIONS
INDEX # 17352 - TYPICAL PLACEMENT OF REFLECTIVE PAVEMENT MARKERS

-Z-
SCALE: 1" = 40'

**WALDROP
ENGINEERING**

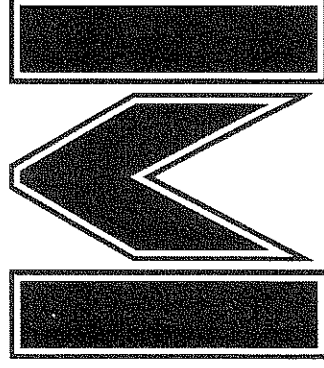

CIVIL ENGINEERING &
LAND DEVELOPMENT CONSULTANTS
28100 RONITA GRANDE DRIVE, SUITE 202, RONITA SPRINGS, FL 34135
P: 239-405-7777 F: 239-405-7899 EMAIL: info@waldropengineering.com

VERONA RESERVE

CLIENT: TAYLOR MORRISON OF FLORIDA, INC.


PAVING, SIGNAGE & GRADING SITE PLAN (B)

PLAN REVISIONS

NO.	DATE	REVISION
01	07/28/10	REVISED PER SARASOTA COUNTY COMMENTS
02	08/14/10	REVISED PER SARASOTA COUNTY COMMENTS


FLORIDA CERTIFICATE OF AUTHORIZATION 08036


NICHOLAS B. SPEAR, P.E.
FL CERTIFICATE NO. 70207
12/15/10
SET NUMBER: 225-01-01
SHEET: 12








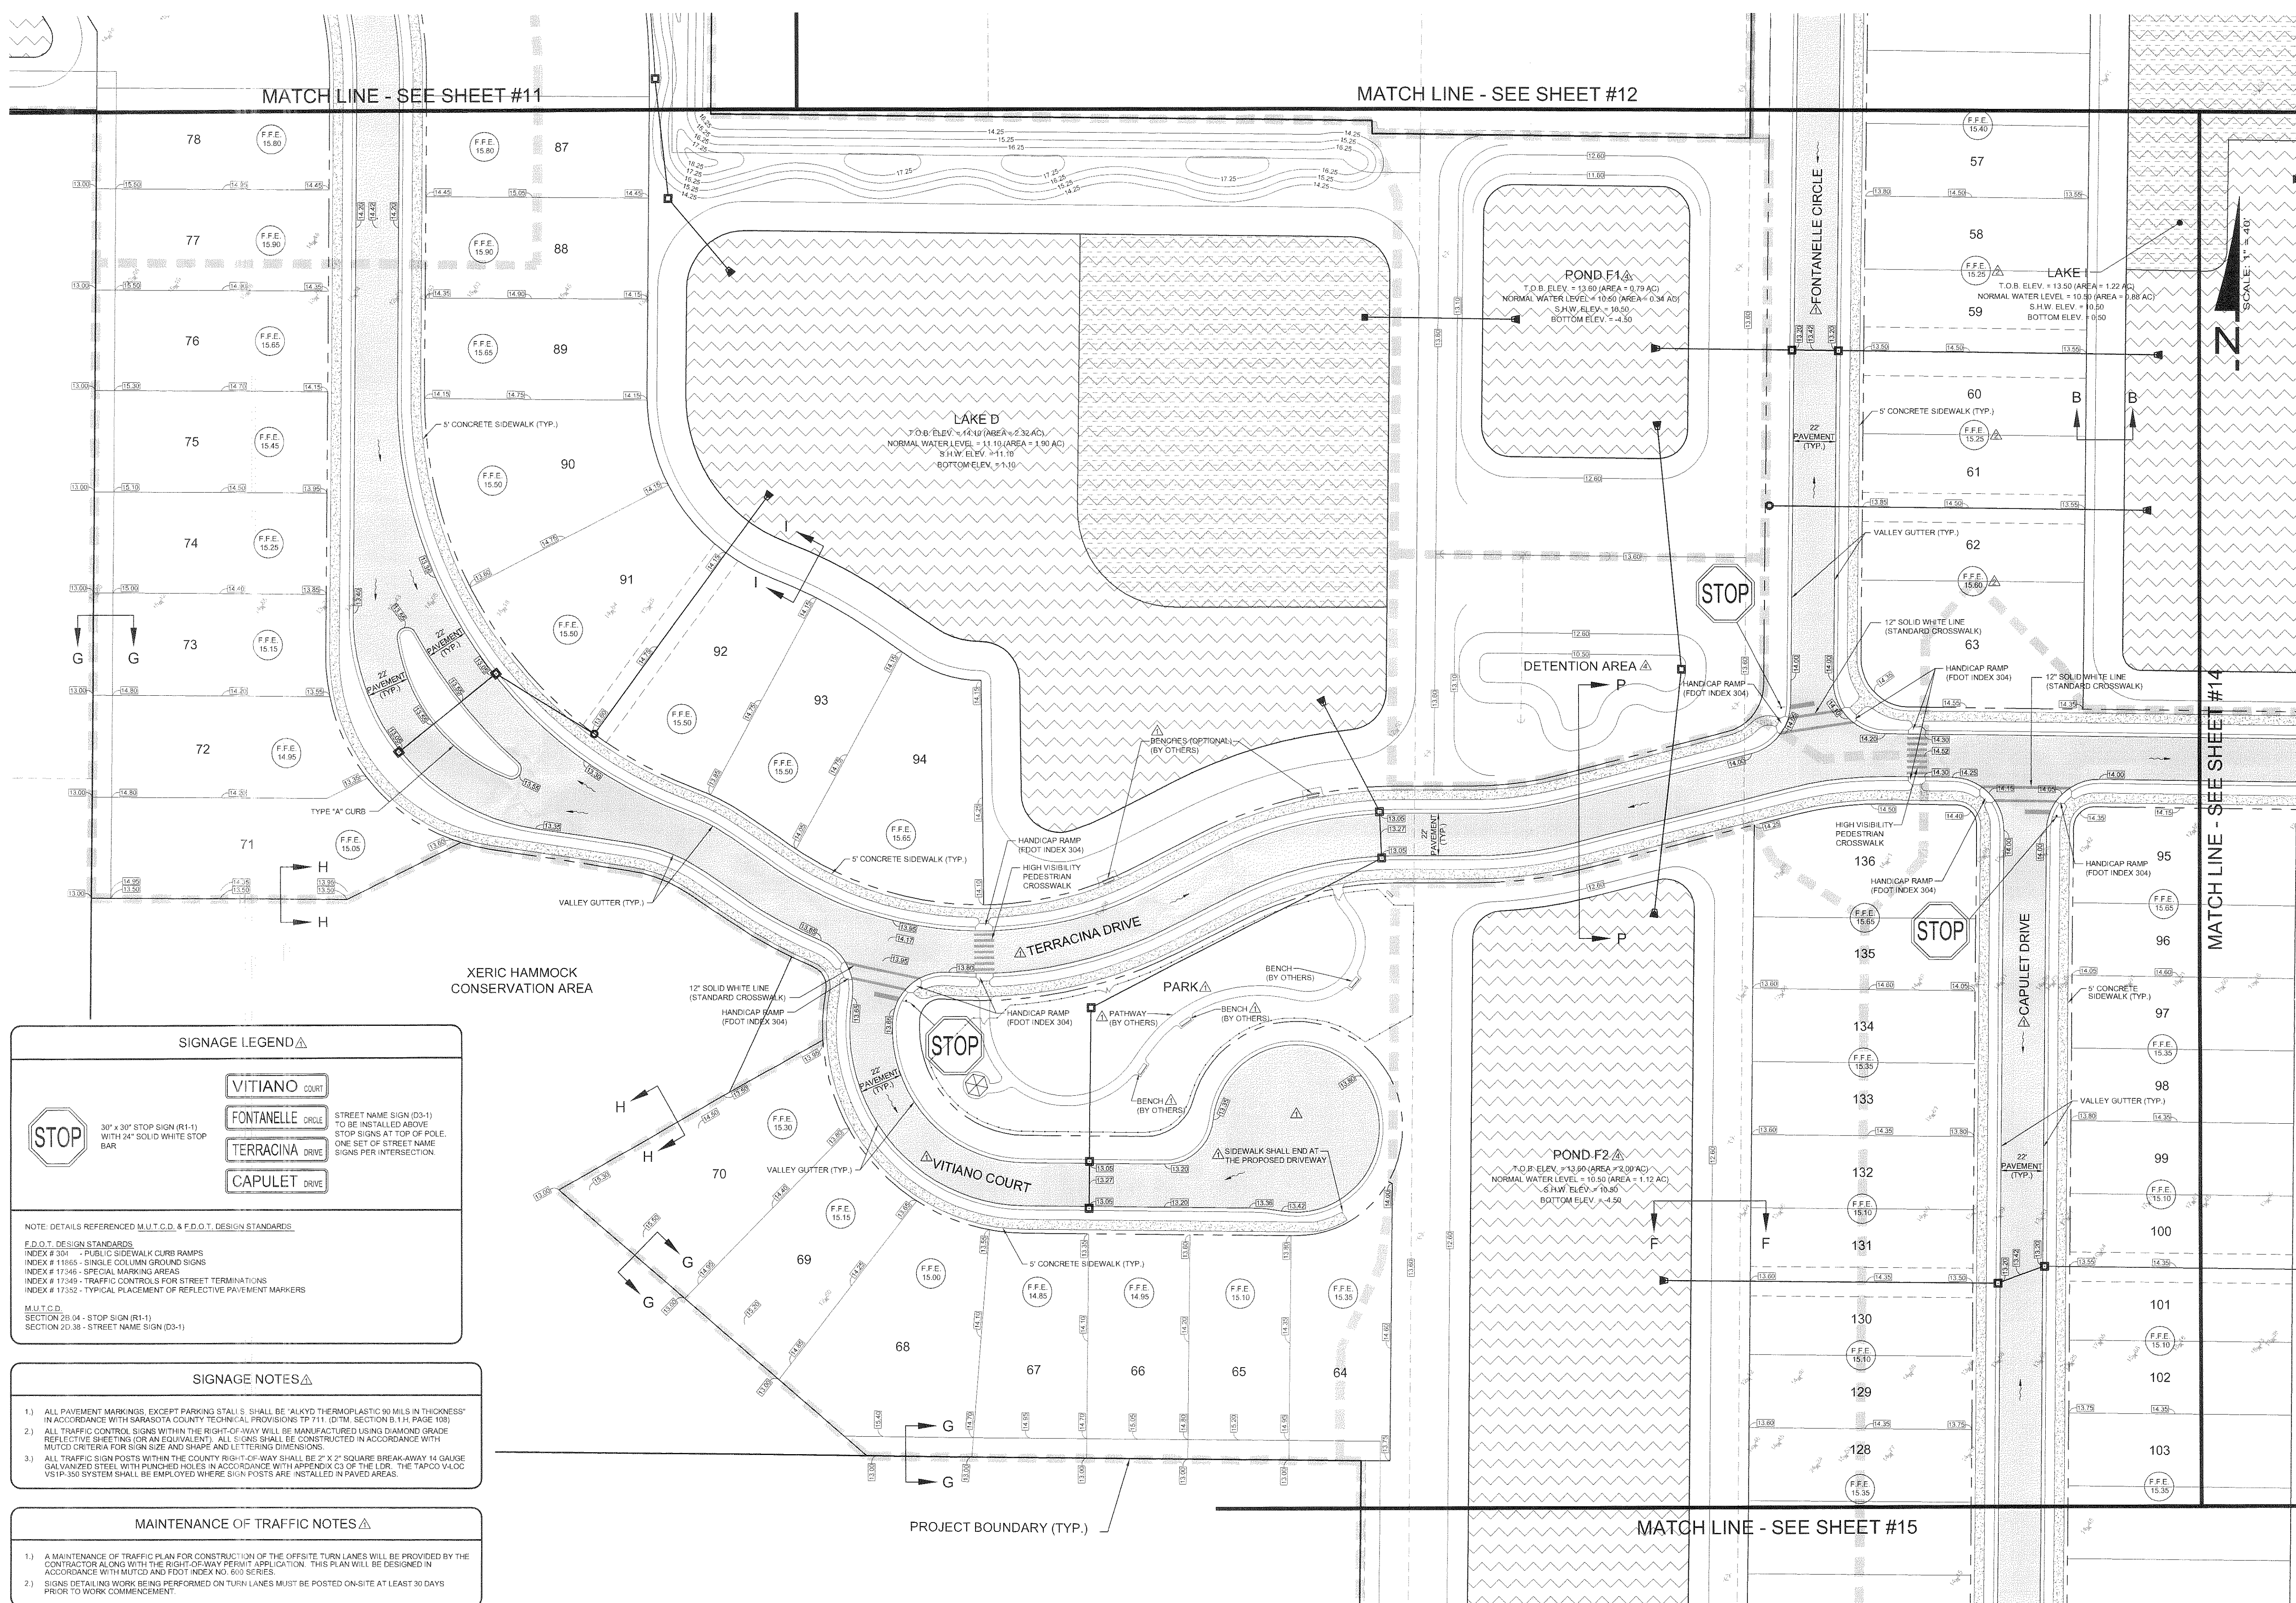


VERONA RESERVE

PAVING, SIGNAGE & GRADING SITE PLAN (C)


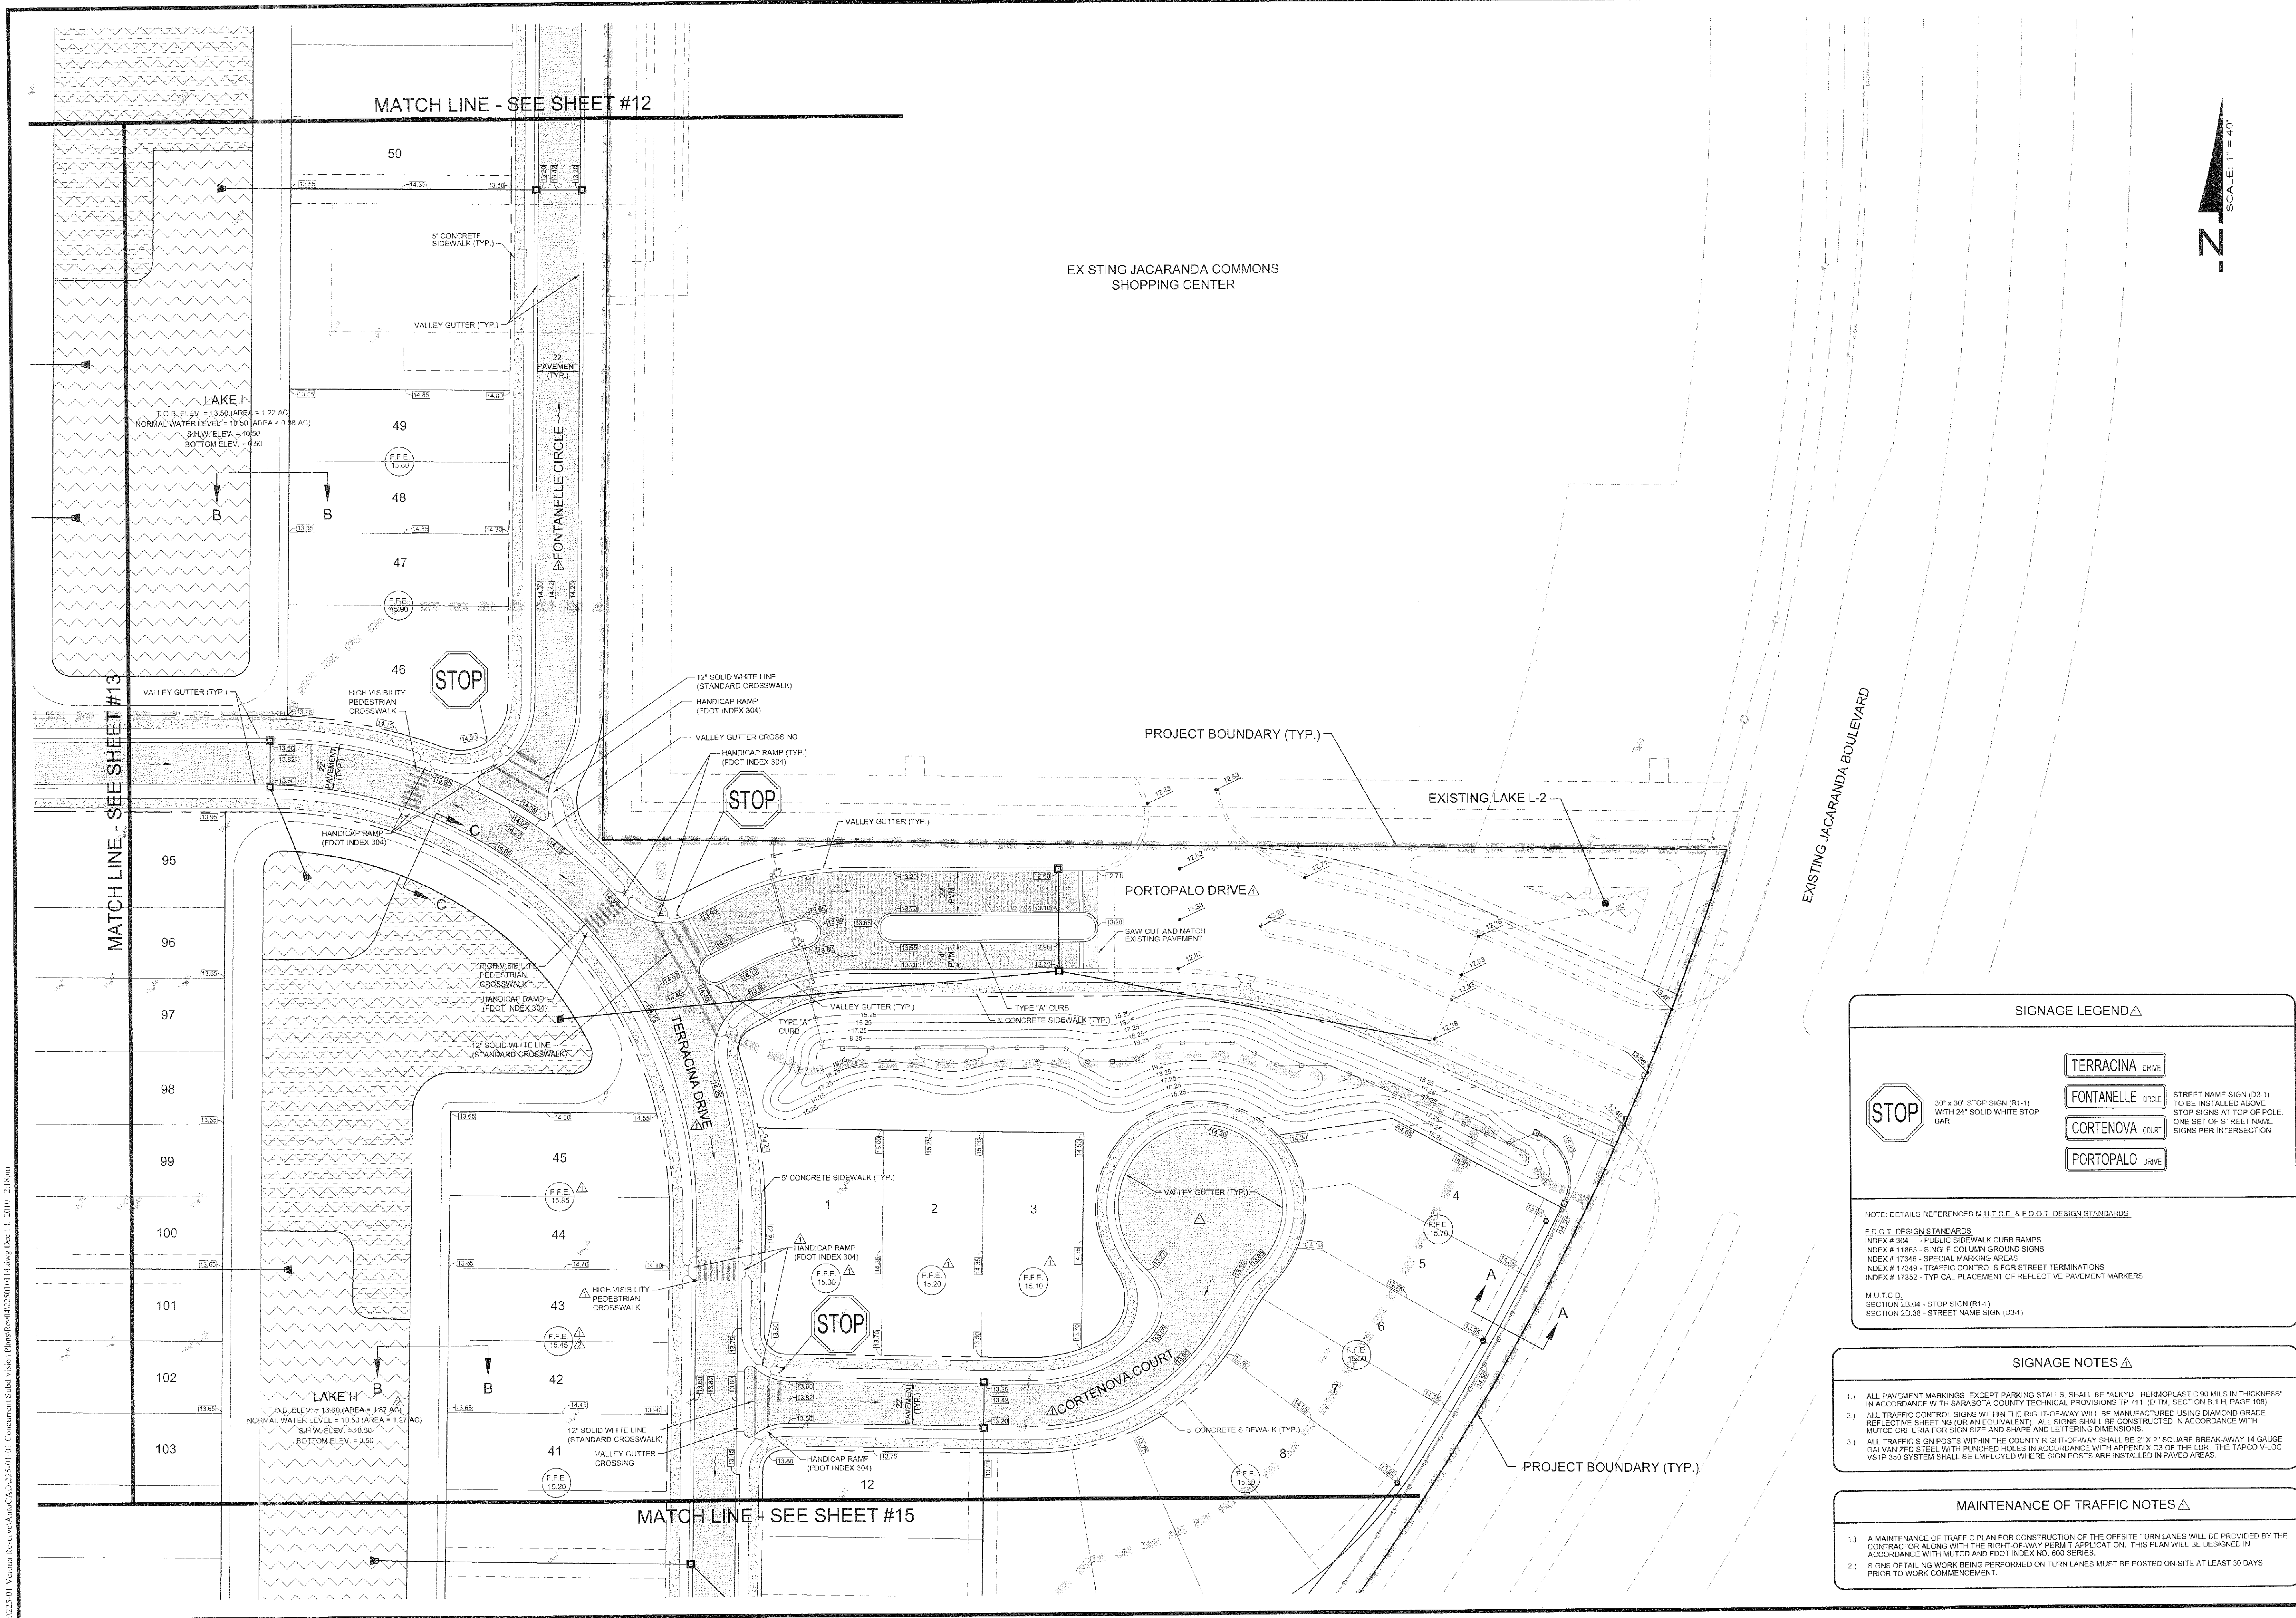


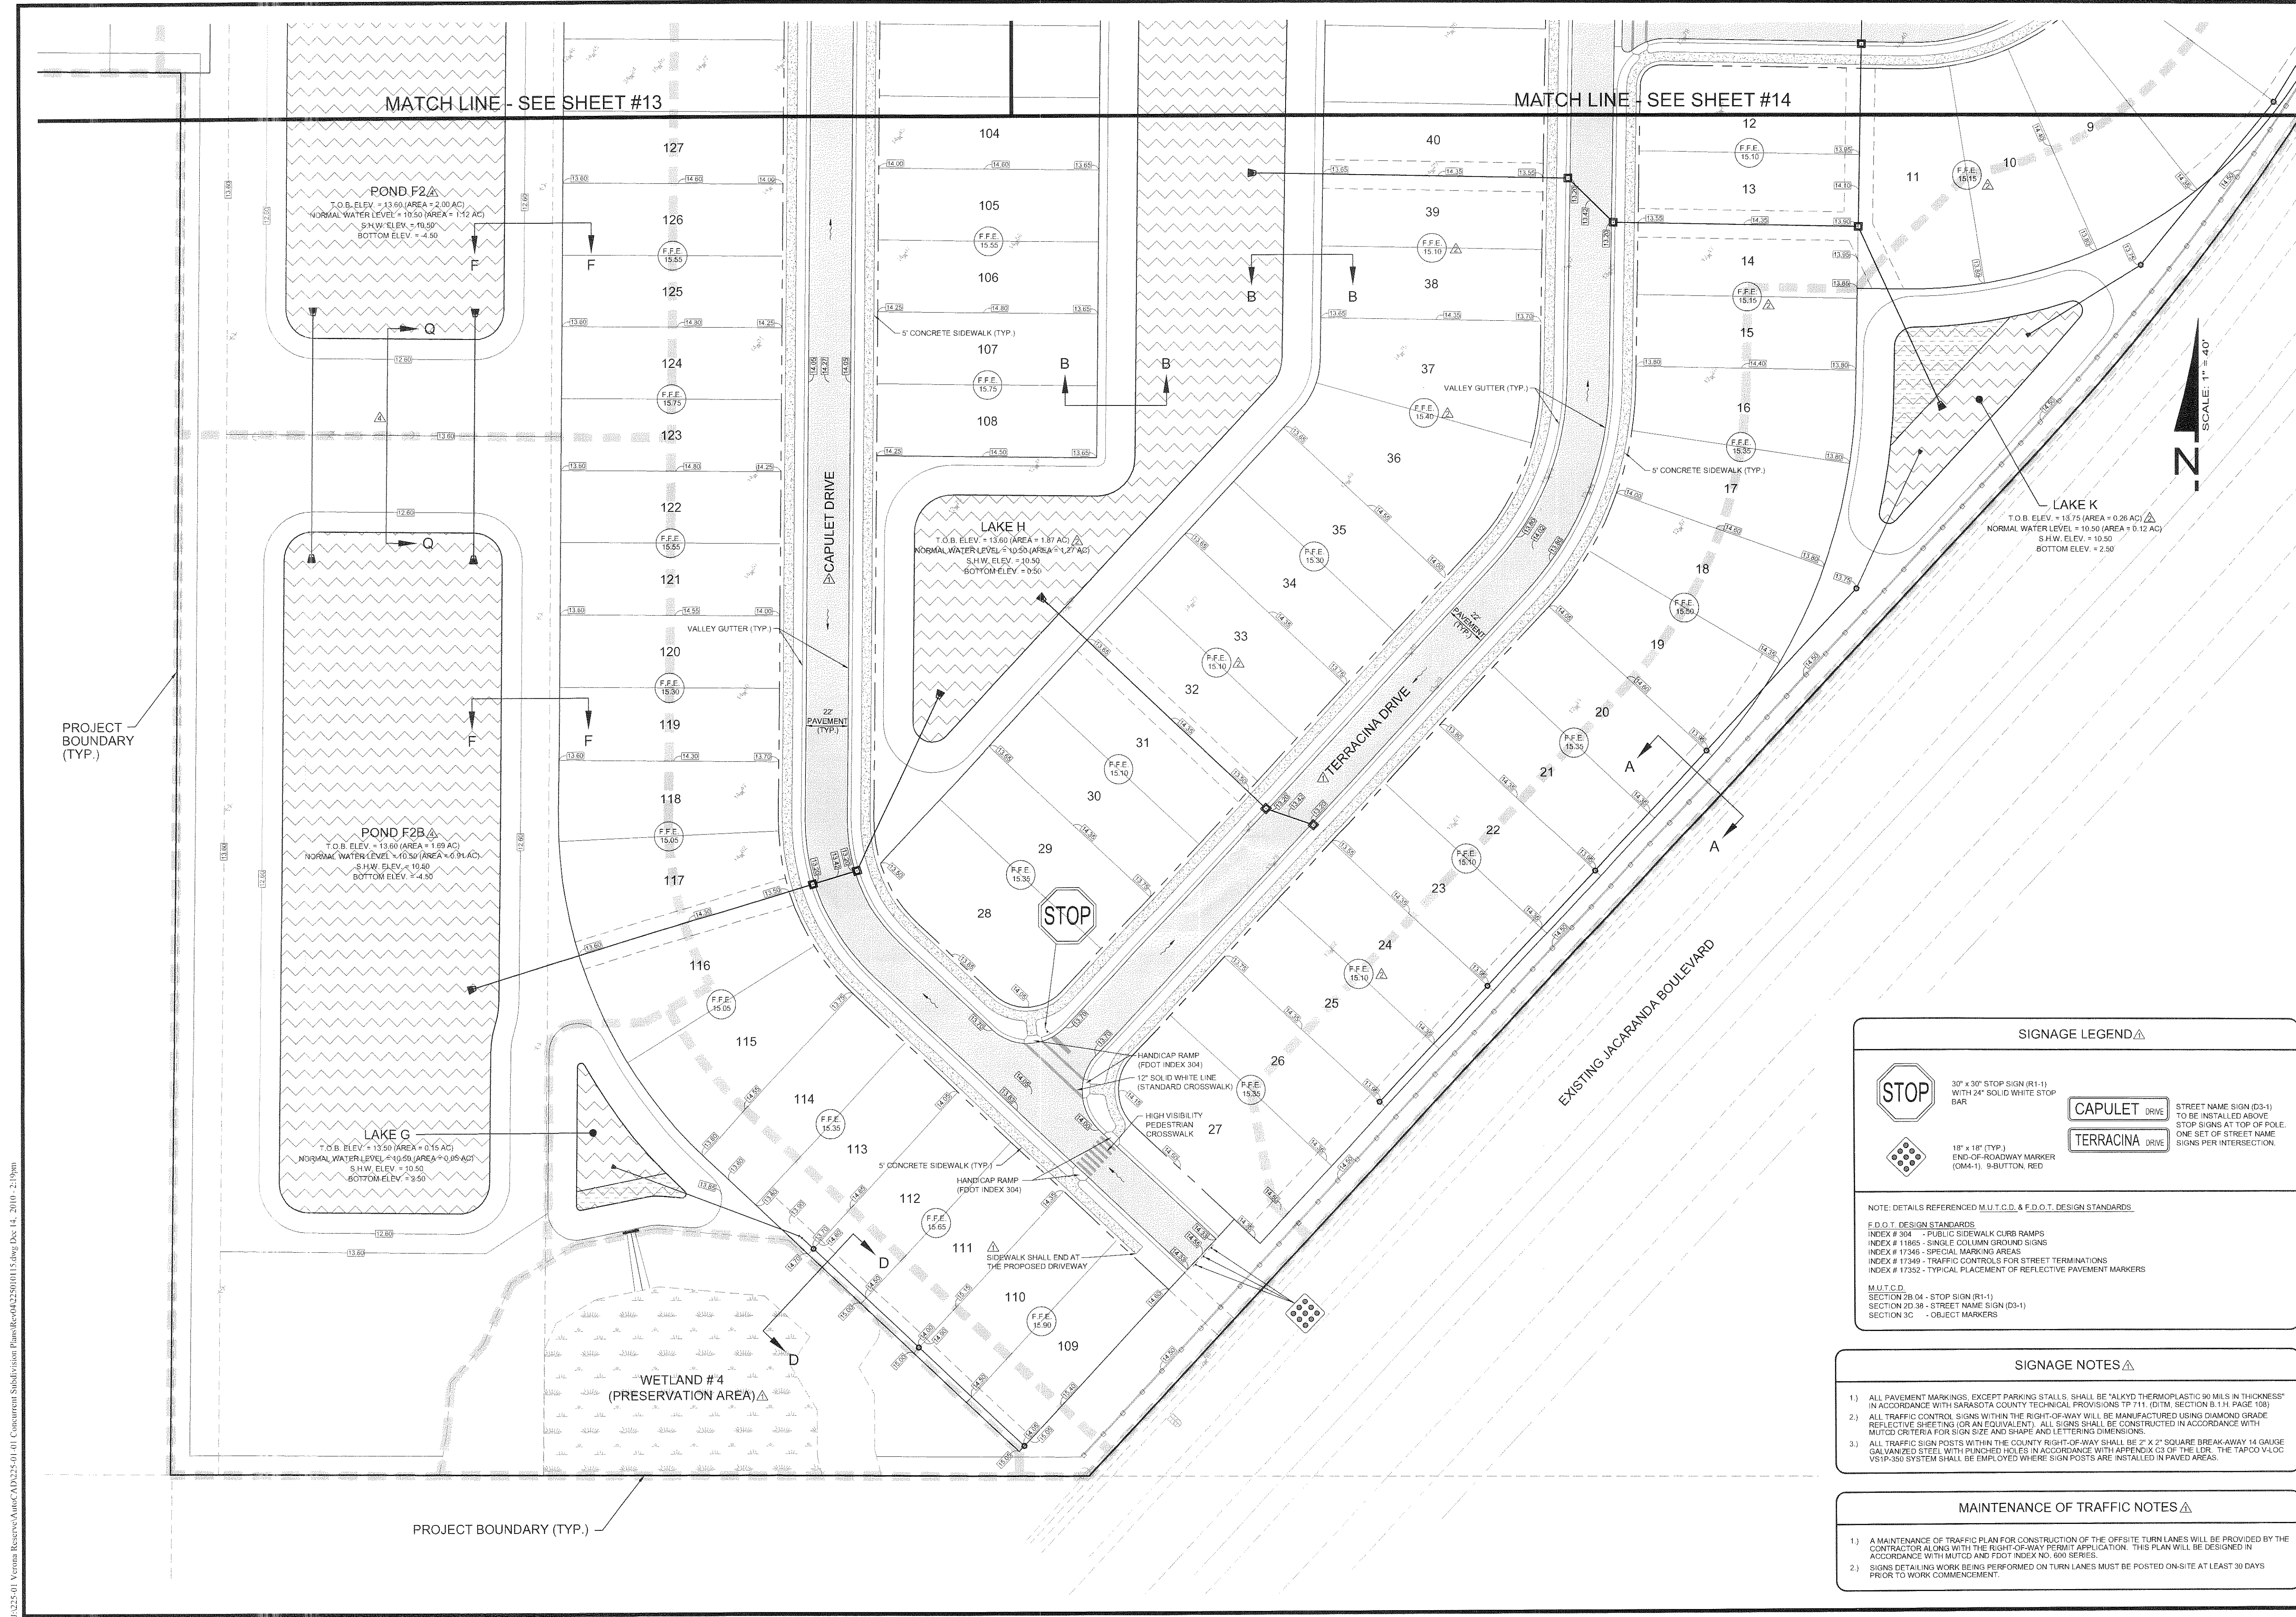

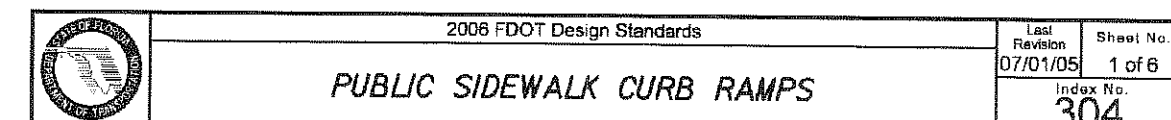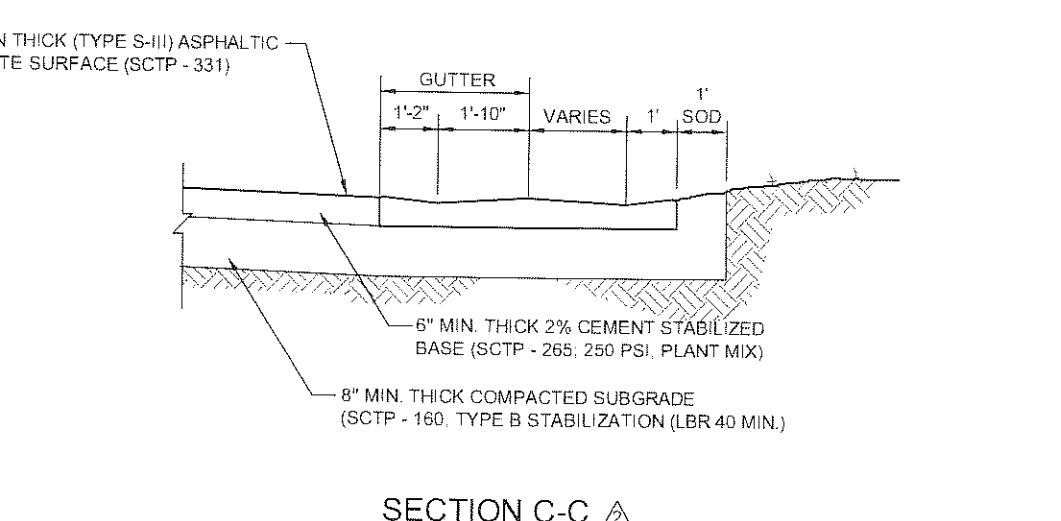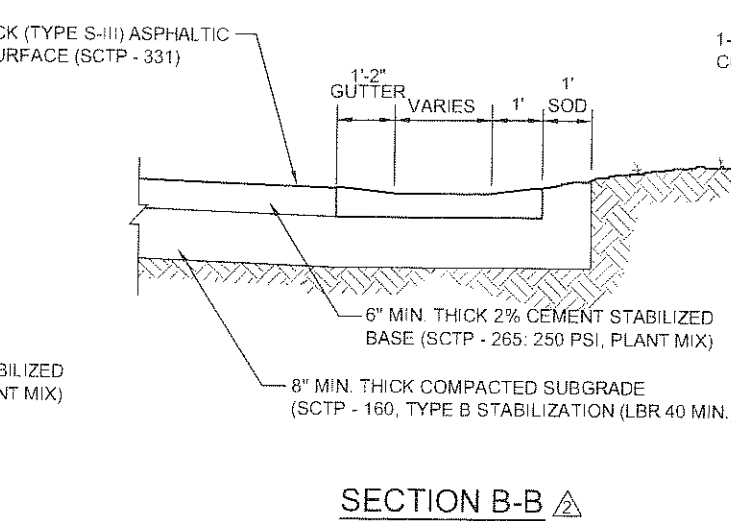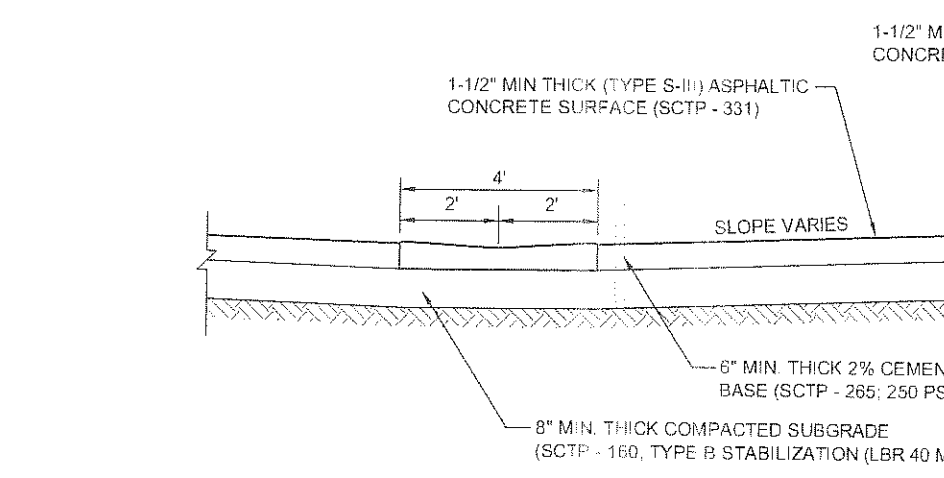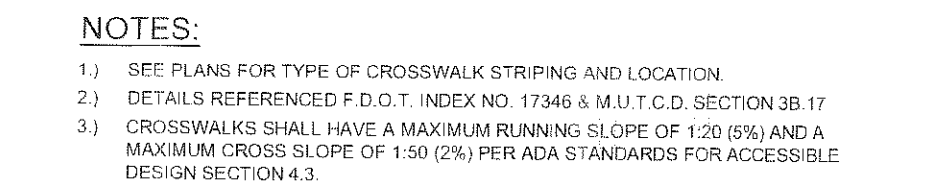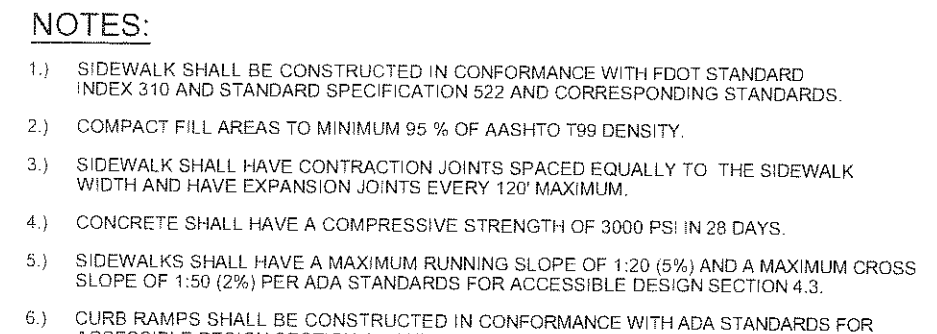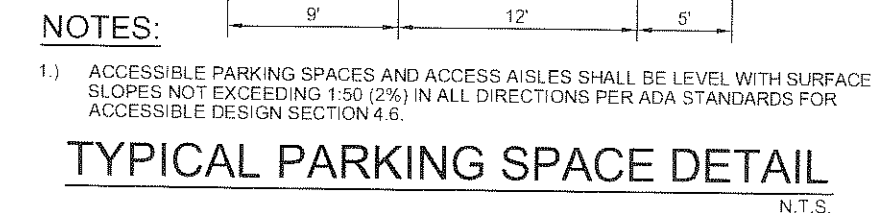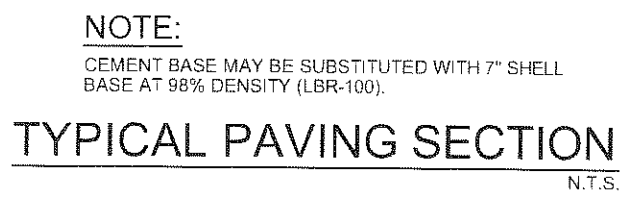


VERONA RESERVE
CLIENT: TAYLOR MORRISON OF FLORIDA, INC.
PAVING DETAILS AND
TEMPORARY MODEL PARKING LOT DETAIL

[illegible]

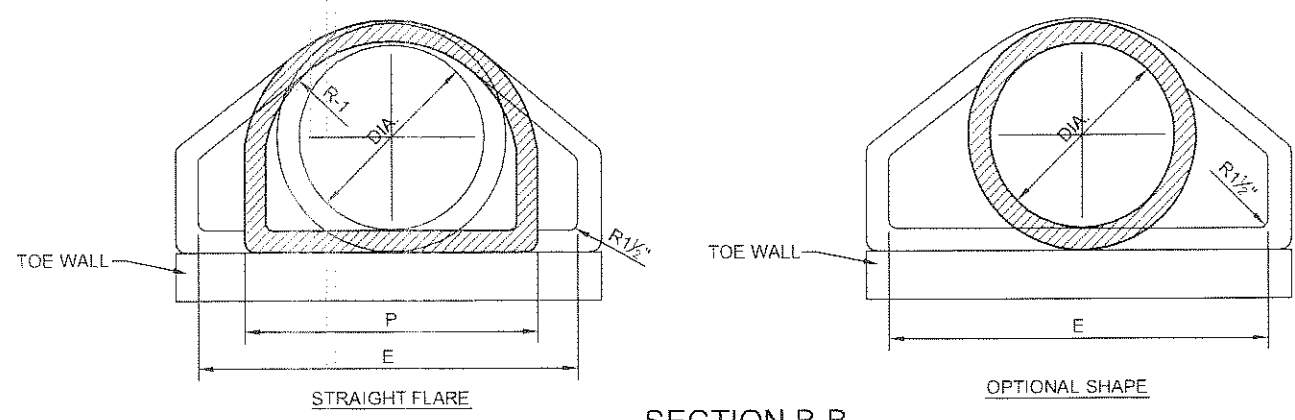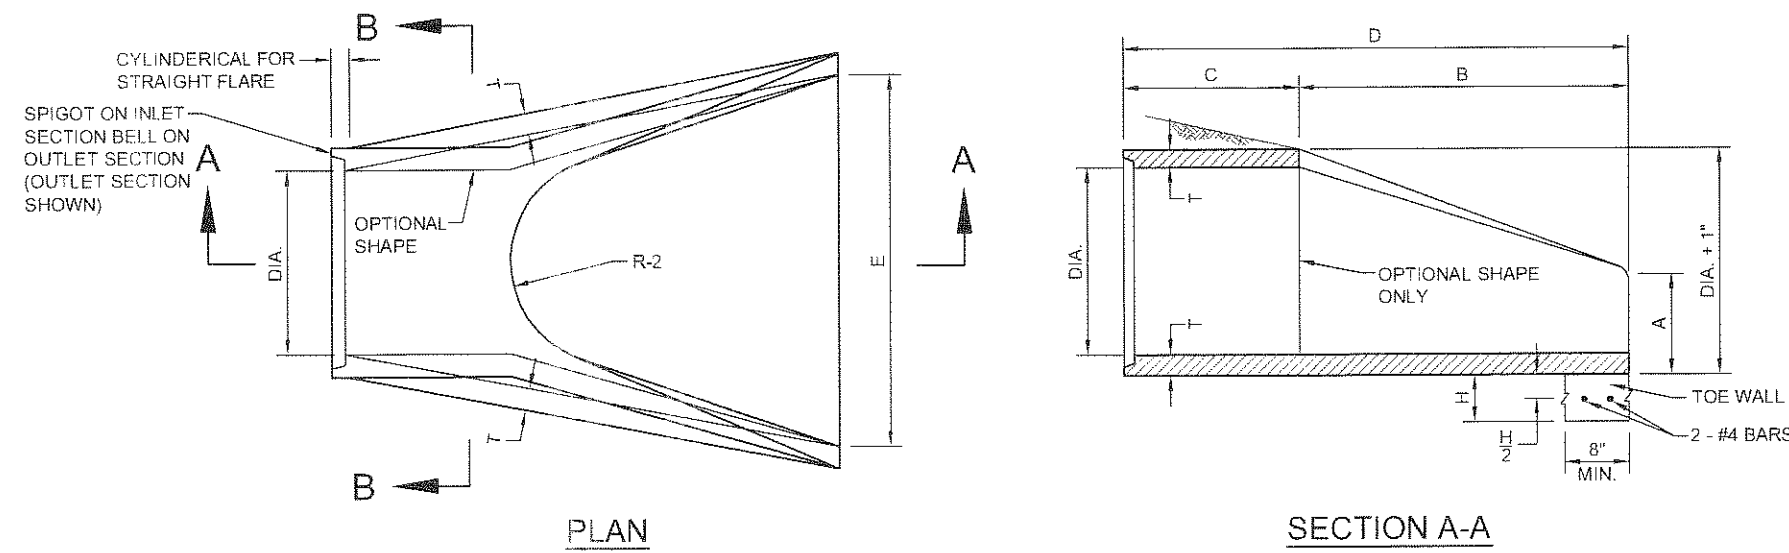

FLARED END SECTION

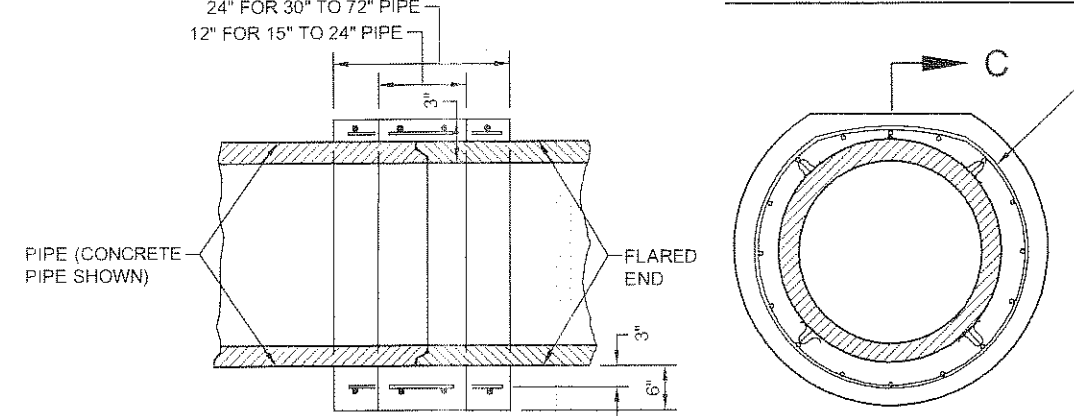

REINFORCED CONCRETE JACKET DETAIL

DESIGN NOTES:

- FLARED END SECTIONS ARE INTENDED FOR USE OUTSIDE THE CLEAR ZONE ON MEDIAN DRAIN AND CROSS DRAIN INSTALLATION, EXCEPT THAT FLARED END SECTIONS FOR PIPE SIZES 12" AND 15" ARE PERMITTED WITHIN THE CLEAR ZONE. WHEN THE SLOPE INTERSECTION PERMITS, THESE FLARED END SECTIONS MAY BE LOCATED WITH THE CULVERT OPENING AS CLOSE AS 8' BEYOND THE OUTSIDE EDGE OF THE SHOULDER.
- FLARED END SECTIONS ARE NOT INTENDED FOR SIDE DRAIN INSTALLATIONS.
- REINFORCED CONCRETE JACKETS SHALL BE USED AT ALL LOCATIONS WHERE HIGH VELOCITIES AND/OR HIGHLY ERODIBLE SOILS MAY CAUSE DISJOINTING. THESE LOCATIONS ARE TO BE SHOWN ON THE PLANS.
- TOE WALLS SHALL BE USED WHENEVER THE ANTICIPATED VELOCITY OF DISCHARGE AND SOIL TYPE ARE SUCH THAT EROSION ACTION WOULD OCCUR. TOE WALLS ARE NOT REQUIRED WHERE DITCH PAVEMENT IS PROVIDED, EXCEPT WHEN DISJOINTING WOULD OCCUR IF THE DITCH PAVEMENT SHOULD FAIL.

FLARED END DETAILS

N.T.S.

DIMENSIONS TABLE														
DIA.	T	REIN. SQ IN/FT	BELL SPIGOT	A	B	C	D	E	P	R-1	R-2	FLAT	WEIGHT (LBS.)	H
12"	2"	0.070	1 1/2"	4"	2'-0"	4'-2 1/2"	6'-1 1/2"	2'-0"	19 1/2"	10 1/2"	9"	3/2"	530	12"
15"	2 1/2"	0.070	2"	6"	2'-3"	3'-10"	6'-1 1/2"	2'-6"	24 1/2"	12 1/2"	11"	3/2"	740	12"
18"	2 1/2"	0.070	2 1/2"	9"	2'-3"	3'-10"	6'-1 1/2"	3'-0"	29"	15 1/2"	12"	4"	990	15"
21"	2 1/2"	0.070	2 1/2"	9"	2'-11"	3'-2"	6'-1 1/2"	3'-6"	31 1/2"	16 1/2"	13"	4"	1280	15"
24"	3"	0.070	2 1/2"	9"	3'-7 1/2"	2'-6"	6'-1 1/2"	4'-0"	33 1/2"	16 1/2"	14"	4 1/2"	1520	18"
27"	3 1/2"	0.148	2 1/2"	10 1/2"	4'-0"	2'-1 1/2"	6'-1 1/2"	4'-6"	36"	18 1/2"	14 1/2"	4 1/2"	1930	18"
30"	3 1/2"	0.148	3"	1'-0"	4'-6"	1'-1 1/2"	6'-1 1/2"	5'-0"	39"	18 1/2"	15"	5"	2180	21"
36"	4"	0.148	3 1/2"	1'-3"	5'-0"	2'-10 1/2"	6'-1 1/2"	6'-0"	47 1/2"	24 1/2"	20"	6"	4100	21"
42"	4 1/2"	0.148	3 1/2"	1'-9"	5'-3"	2'-11"	6'-2"	6'-6"	53 1/2"	27 1/2"	22"	5 1/2"	5380	24"
48"	5"	0.148	4"	2'-0"	6'-0"	2'-2"	6'-2"	7'-0"	56 1/2"	28 1/2"	22"	5 1/2"	6550	24"
54"	5 1/2"	0.174	4 1/2"	2'-3"	5'-6"	2'-11"	6'-4"	7'-6"	65 1/2"	33 1/2"	24"	6"	8040	24"
60"	6"	0.174	5"	2'-6"	5'-9"	3'-3"	6'-3"	8'-0"	72 1/2"	36 1/2"	24"	6"	8750	24"
66"	6 1/2"	0.174	5 1/2"	2'-9"	6'-6"	1'-0"	6'-3"	8'-3"	80"	38 1/2"	24"	7 1/2"	10630	24"
72"	7"	0.174	6"	2'-9"	6'-6"	1'-0"	6'-3"	9'-0"	77 1/2"	38 1/2"	24"	7 1/2"	12520	24"

GENERAL NOTES:

- FLARED END SECTIONS SHALL CONFORM TO THE REQUIREMENTS OF ASTM C-75 WITH THE EXCEPTION THAT DIMENSIONS AND REINFORCEMENT SHALL BE AS PRESCRIBED IN THE TABLE ABOVE. CIRCUMFERENTIAL REINFORCEMENT MAY CONSIST OF EITHER ONE CAGE OR TWO CAGES OF STEEL. COMPRESSIVE STRENGTH OF CONCRETE SHALL BE 4000 PSI. SHOP DRAWINGS FOR FLARED END SECTIONS HAVING DIMENSIONS OTHER THAN ABOVE MUST BE SUBMITTED FOR APPROVAL TO THE STATE DRAINAGE ENGINEER.
- CONNECTIONS BETWEEN THE FLARED END SECTION AND THE PIPE CULVERT MAY BE ANY OF THE FOLLOWING TYPES UNLESS OTHERWISE SHOWN ON THE PLANS.
 - JOINTS MEETING THE REQUIREMENTS OF SECTION 941-1.5 OF THE STANDARD SPECIFICATIONS (O-RING GASKET). FLARED END SECTION JOINT DIMENSIONS AND TOLERANCES SHALL BE IDENTICAL OR COMPATIBLE TO THOSE USED IN THE PIPE CULVERT JOINT. WHEN PIPE CULVERT AND FLARED END SECTION MANUFACTURERS ARE DIFFERENT, THE COMPATIBILITY OF JOINT DESIGNS SHALL BE CERTIFIED TO BY THE MANUFACTURER OF THE FLARED END SECTIONS.
 - JOINTS SEALED WITH PREFORMED PLASTIC GASKETS. THE GASKETS SHALL MEET THE REQUIREMENTS OF SECTION 942.2 OF THE STANDARD SPECIFICATIONS AND THE MINIMUM SIZES FOR GASKETS SHALL BE AS THAT SPECIFIED FOR EQUIVALENT SIZES OF ELLIPTICAL PIPE.
 - REINFORCED CONCRETE JACKETS, AS DETAILED ON THIS DRAWING. COST OF THE REINFORCED CONCRETE JACKET TO BE INCLUDED IN THE CONTRACT UNIT PRICE FOR THE FLARED END SECTION. WHEN NON-GASKETED CORRUGATED METAL PIPE IS CALLED FOR IN THE PLANS, THE PIPE SHALL BE BITUMINOUS COATED IN THE JACKETED AREA AS SPECIFIED ON INDEX NO. 280. BITUMINOUS COATINGS TO BE INCLUDED IN THE CONTRACT UNIT PRICE FOR THE PIPE CULVERT.
- TOE WALLS SHALL BE CONSTRUCTED WHEN SHOWN ON THE PLANS OR AT LOCATIONS DESIGNATED BY THE ENGINEER. TOE WALLS ARE TO BE CAST-IN-PLACE WITH CLASS - CONCRETE AND PAID FOR UNDER THE CONTRACT UNIT PRICE FOR CLASS - CONCRETE (MISCELLANEOUS) OR REINFORCED STEEL TO BE INCLUDED IN COST OF TOE WALL.
- ON SKEWED PIPE CULVERTS THE FLARED END SECTIONS SHALL BE PLACED IN LINE WITH THE PIPE CULVERT. SIDE SLOPES SHALL BE WARPED AS REQUIRED TO FIT THE FLARED END SECTIONS.
- FLARED END SECTION TO BE PAID FOR UNDER THE CONTRACT UNIT PRICE FOR FLARED END SECTION (CONCRETE). EACH SODDING SHALL BE IN ACCORDANCE WITH INDEX NO. 281, AND PAID FOR UNDER THE CONTRACT UNIT PRICE FOR SODDING, 5%.

MINIMUM DIMENSIONS FOR DRAINAGE STRUCTURES

PIPE SIZE	MINIMUM STRUCTURE WIDTH
15"	3.0 FT
18"	3.0 FT
24"	3.5 FT
30"	4.0 FT
36"	4.5 FT
42"	5.0 FT
48"	5.5 FT
54"	6.0 FT

DRAINAGE STRUCTURE TABLE


TYPE OF STRUCTURE	REFERENCE
GRATE INLET	SEE DETAIL
VALLEY GUTTER INLET	SEE DETAIL
JUNCTION BOX	FDOT INDEX 200, 201
TYPE "B" CURB INLET	FDOT INDEX 200, 214

GENERAL STRUCTURE DESIGN NOTES:

- ALL REINFORCING STEEL SHALL HAVE A MINIMUM TWO INCHES OF COVER.
- ALL CONCRETE SHALL HAVE COMPRESSIVE STRENGTH OF 3,000 PSI @ 28 DAYS.


GENERAL NOTE

- ALL STRUCTURES REQUIRE FIELD POURED CONCRETE INVERT TO ELIMINATE STANDING WATER.

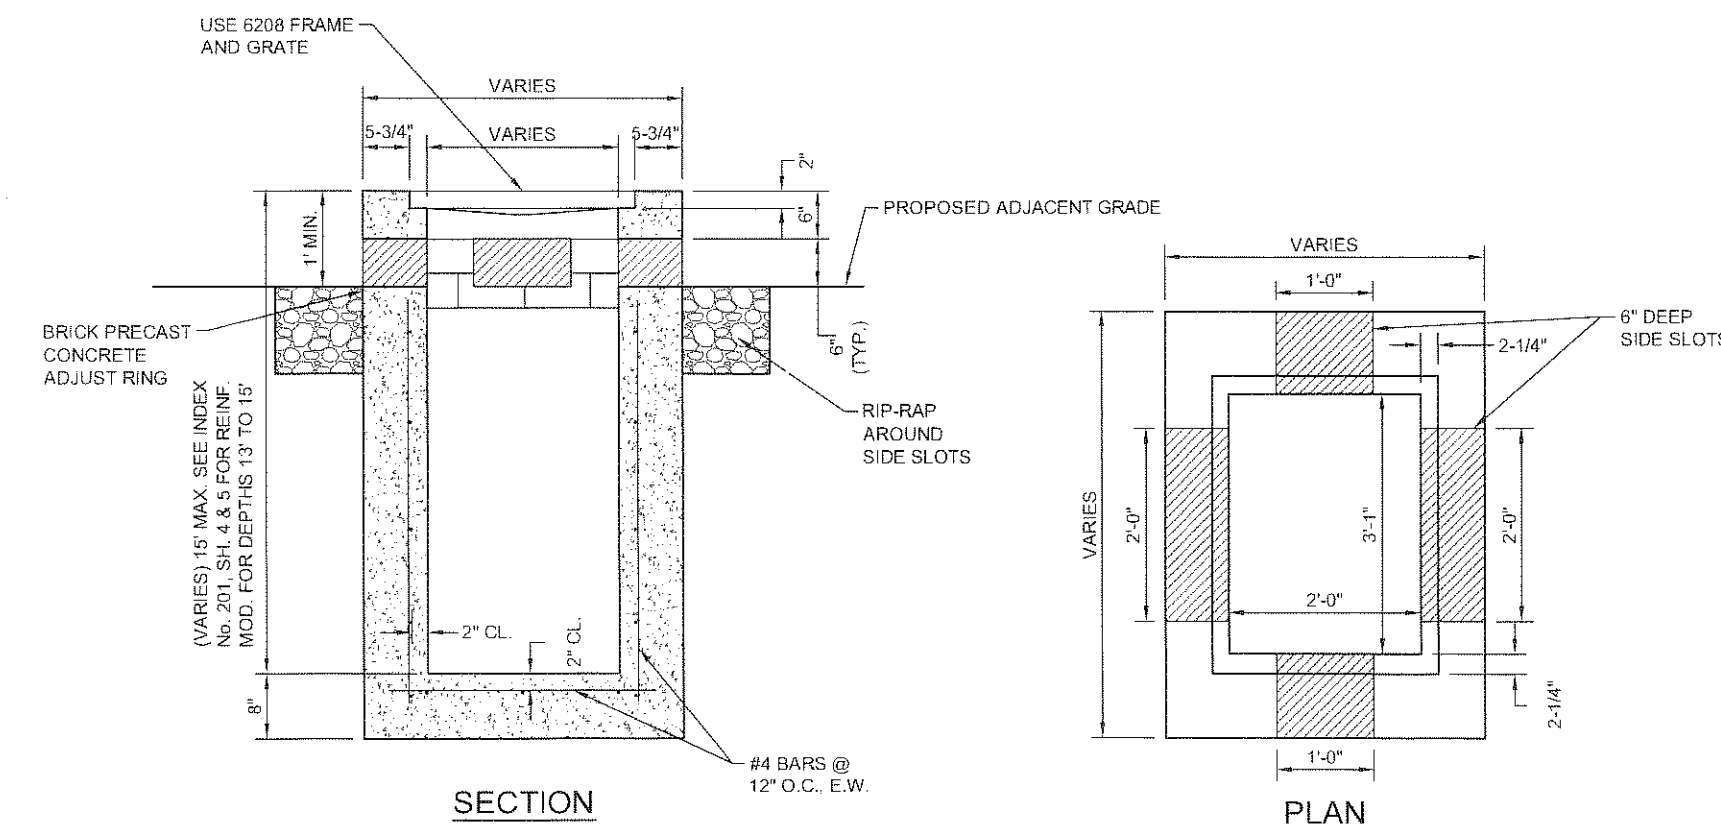


MODIFIED GRATE INLET WITH SIDE SLOTS

N.T.S.

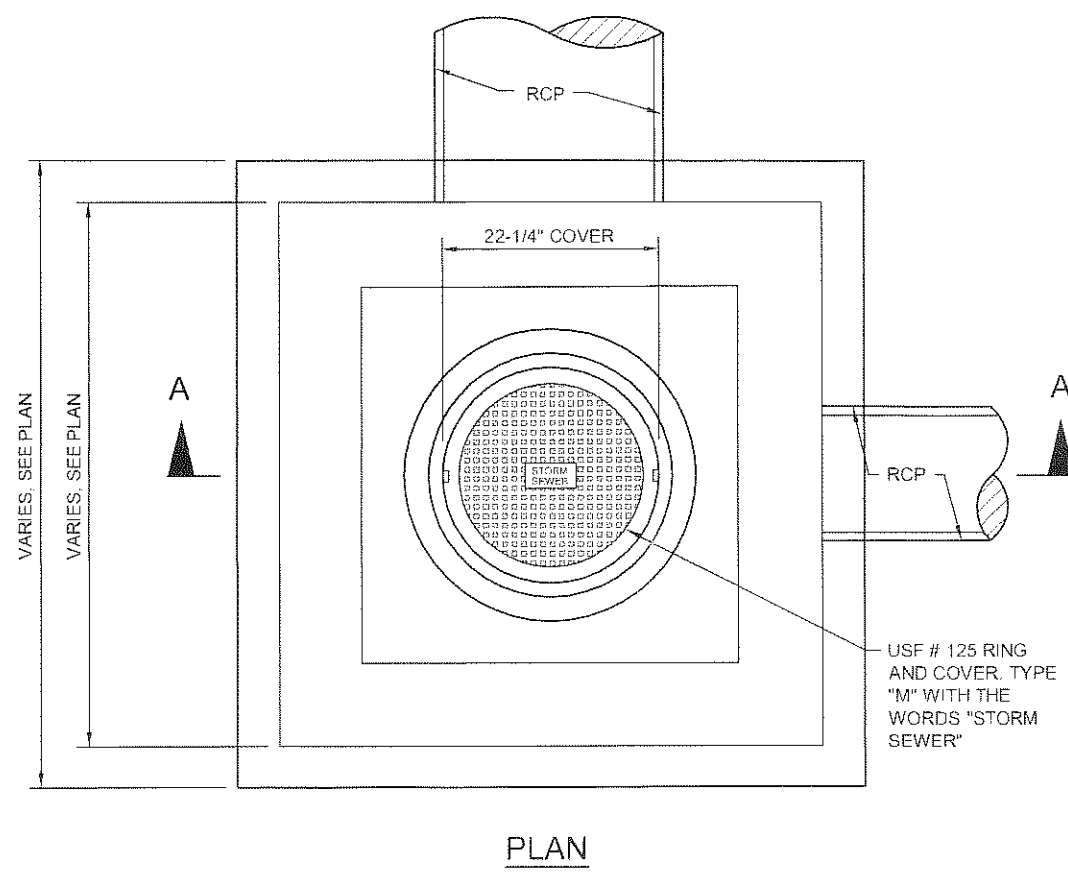


JUNCTION BOX DETAIL

N.T.S.

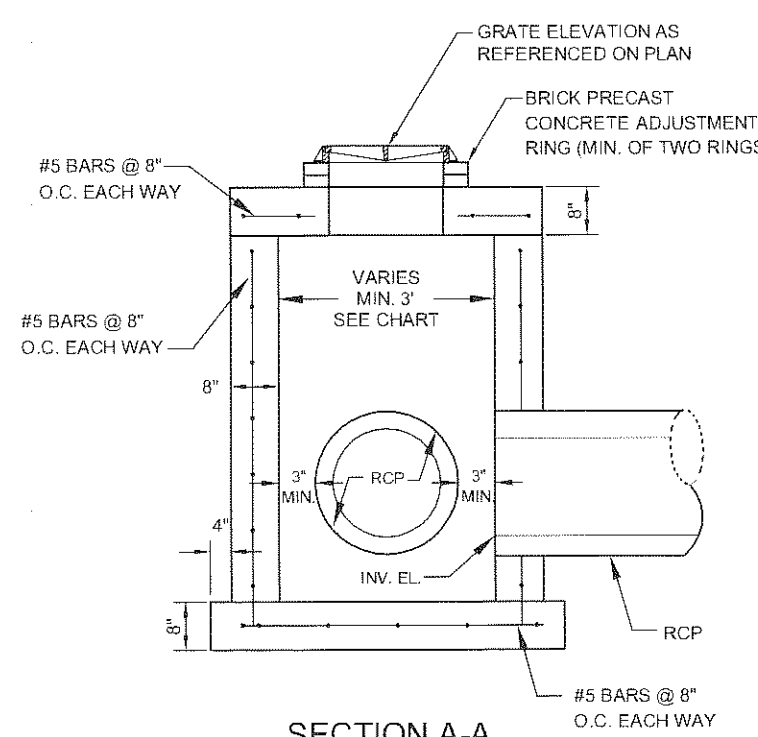

SECTION A-A

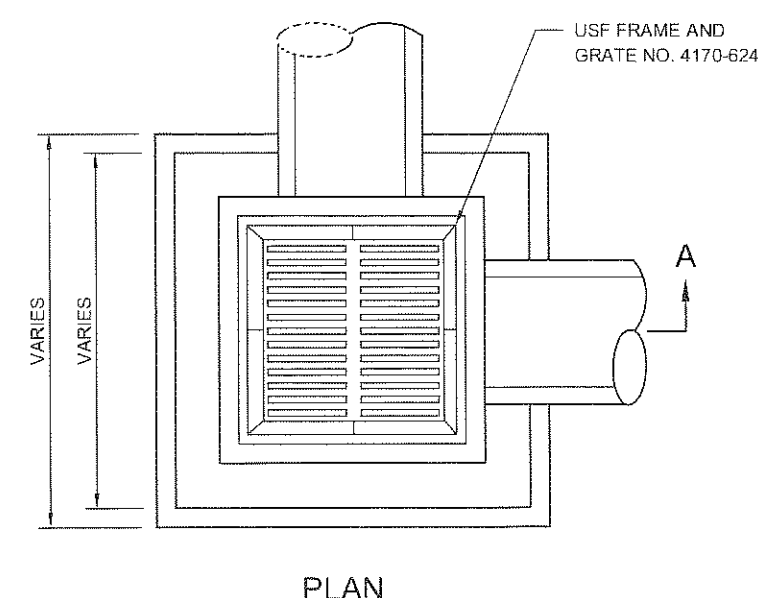


PLAN

- ALL REINFORCING STEEL SHALL HAVE A MINIMUM TWO INCHES OF COVER.
- ALL CONCRETE SHALL HAVE COMPRESSIVE STRENGTH OF 3,000 PSI @ 28 DAYS.

TYPE "C" GRATE INLET DETAIL

(REF. FDOT NO. 232)


N.T.S.

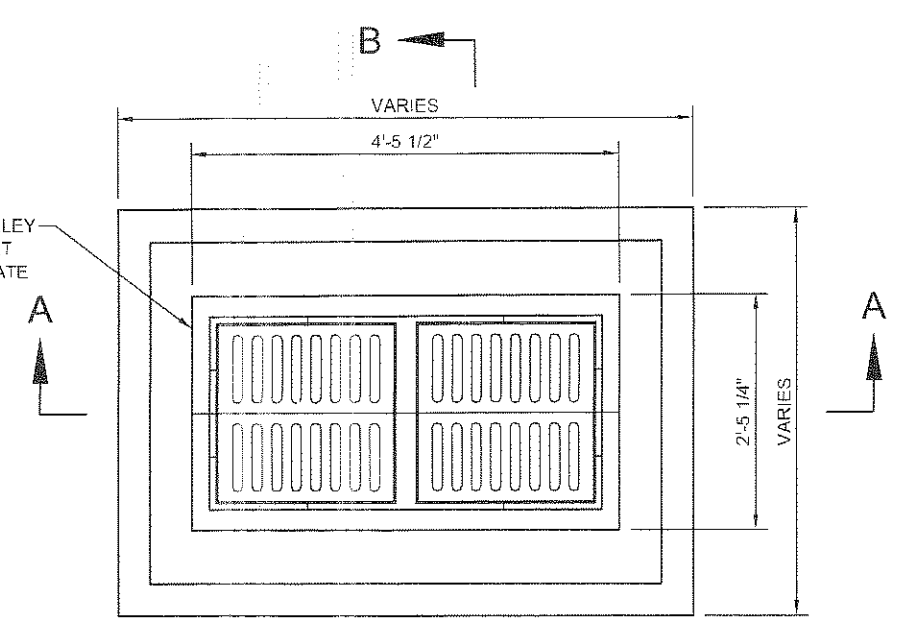

SECTION A-A


TYPICAL VALLEY GUTTER INLET DETAIL

N.T.S.

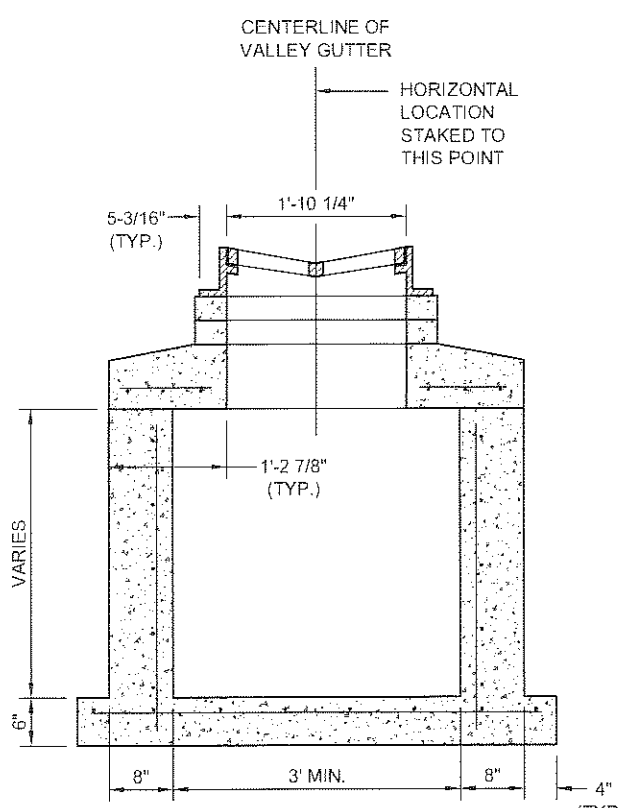

SECTION B-B

WALDROP ENGINEERING

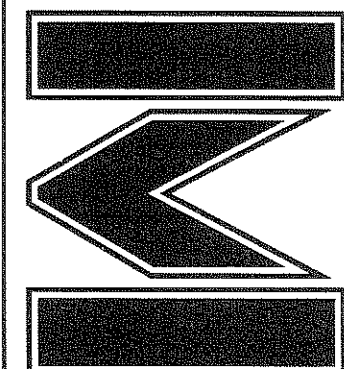

CIVIL ENGINEERING &
LAND DEVELOPMENT CONSULTANTS

25100 BONITA GRANDE DRIVE, SUITE 305, BONITA SPRINGS, FL 33435
P: 239-405-7777 F: 239-405-7899 EMAIL: info@waldropeng.com

VERONA RESERVE
CLIENT: TAYLOR MORRISON OF FLORIDA, INC.

DRAINAGE DETAILS (A)

PLAN REVISIONS

NO.	DATE	REVISION
1	07/20/10	REVISED PER SARASOTA COUNTY COMMENTS

FLORIDA CERTIFICATE OF AUTHORIZATION 00036

NICHOLAS B. SPACCI, P.E.
No 70207
12/15/10
FL CERTIFICATION 7007

SET NUMBER: 225-01-01
SHEET: 17



Diagram illustrating the plan view of a rectangular sump structure. The diagram shows concentric rectangular lines representing the sump walls. A central outlet is shown with a trapezoidal shape. Labels include:

- TOP OF BANK = A
- TOE OF SLOPE
- BOTTOM OF SUMP
- ALUMINUM BAPPLE (SEE DETAIL THIS SHEET)
- RIP RAP


A section line A-A is indicated with arrows pointing to the right.


SUMP AND WEIR DETAIL 

PIPE SIZE	MINIMUM STRUCTURE WIDTH
15"	3.0 FT
18"	3.0 FT
24"	3.5 FT
30"	4.0 FT
36"	4.5 FT
42"	5.0 FT
48"	5.5 FT
54"	6.0 FT


- 1.) ALL REINFORCING STEEL SHALL HAVE A MINIMUM TWO INCHES OF COVER.
- 2.) ALL CONCRETE SHALL HAVE COMPRESSIVE STRENGTH OF 3,000 PSI @ 28 DAYS.

1.) ALL STRUCTURES REQUIRE FIELD POURED CONCRETE INVERT TO ELIMINATE STANDING WATER.

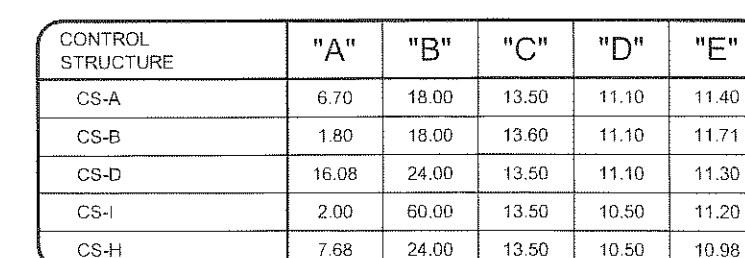
[illegible]

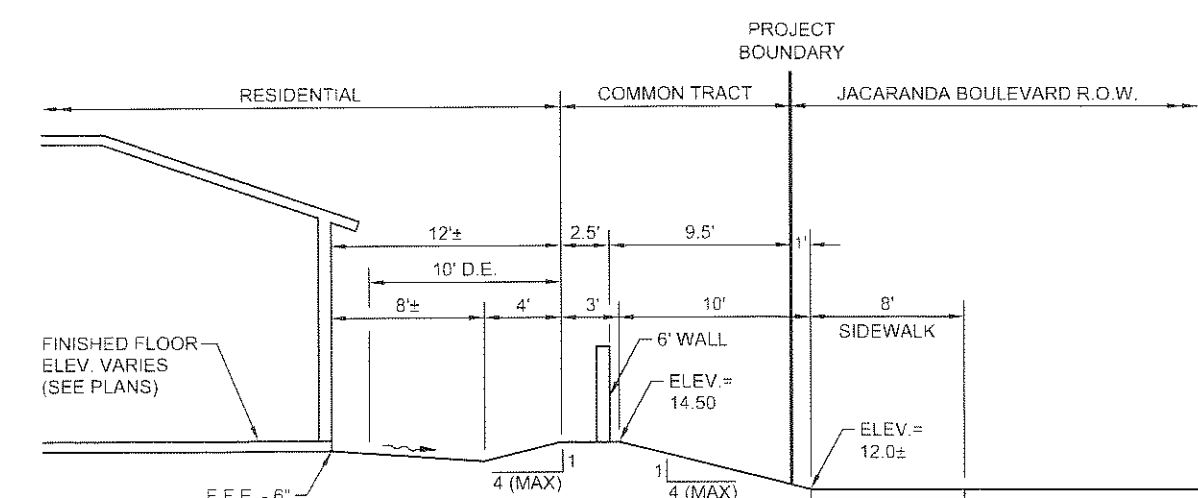


SECTION A-A
N.T.S.

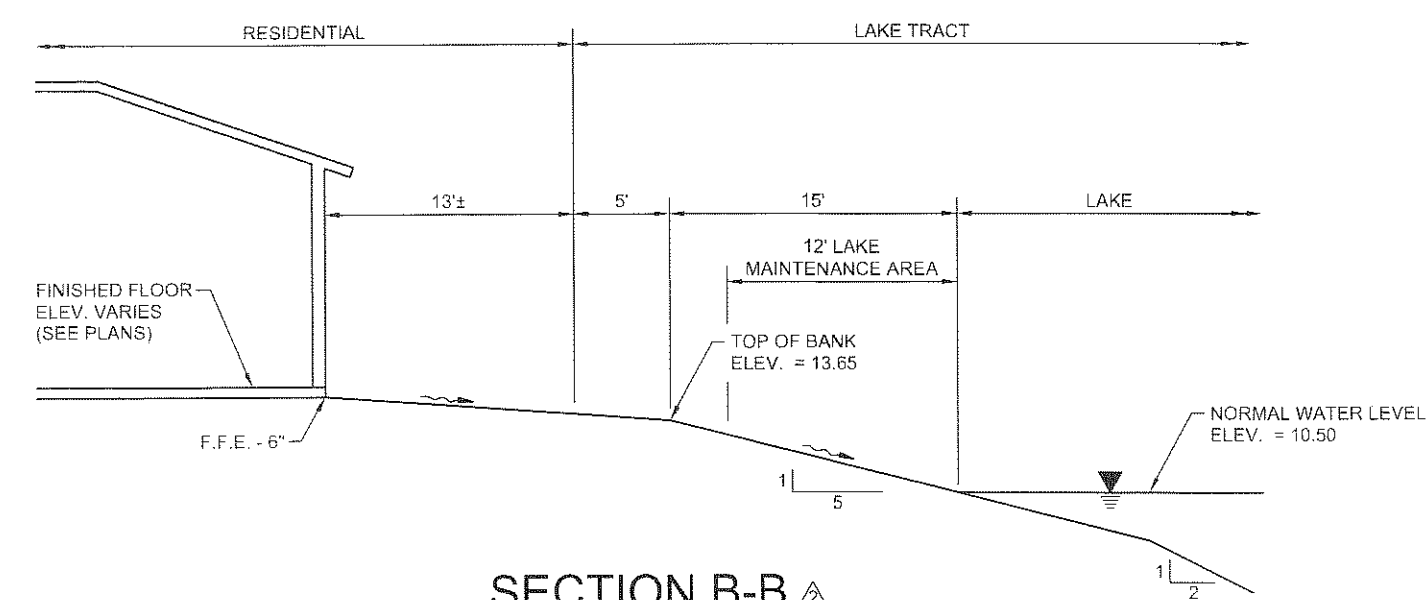


SECTION B-B 
N.T.S.

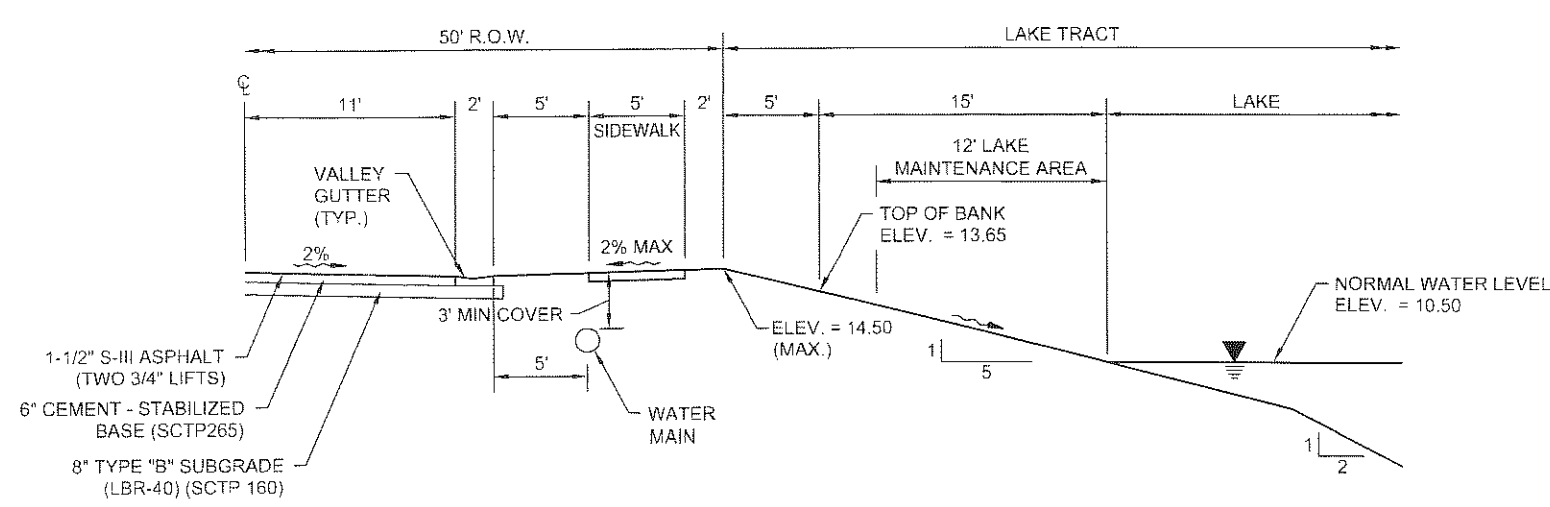


SECTION C-C 
N.T.S.

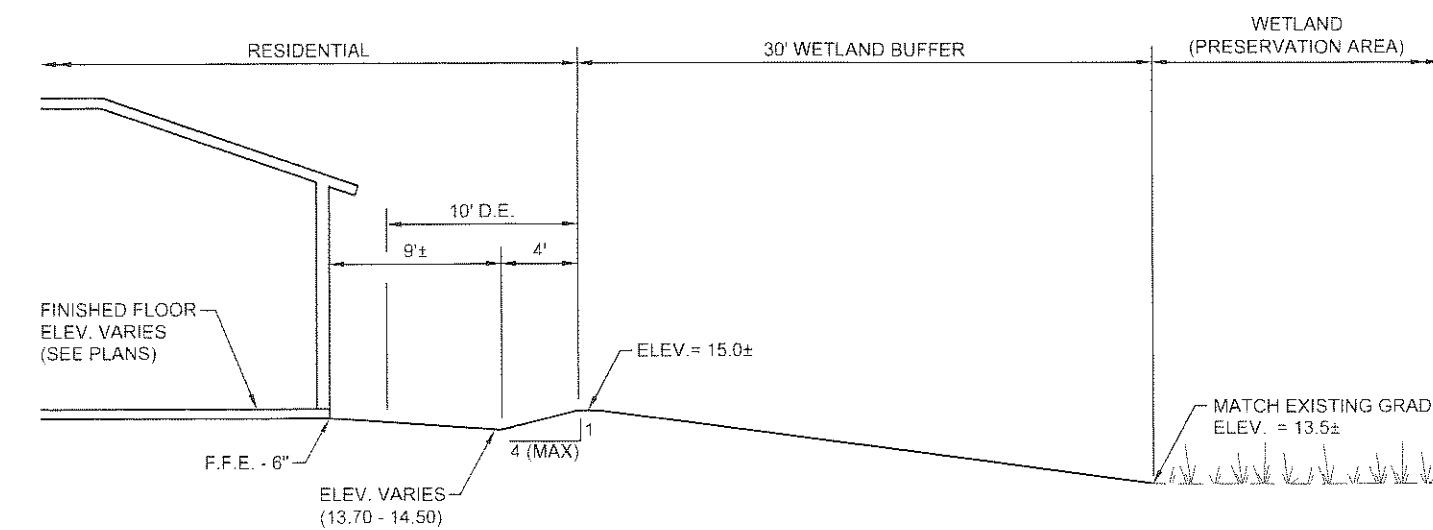


SECTION D-D  
N.T.S.

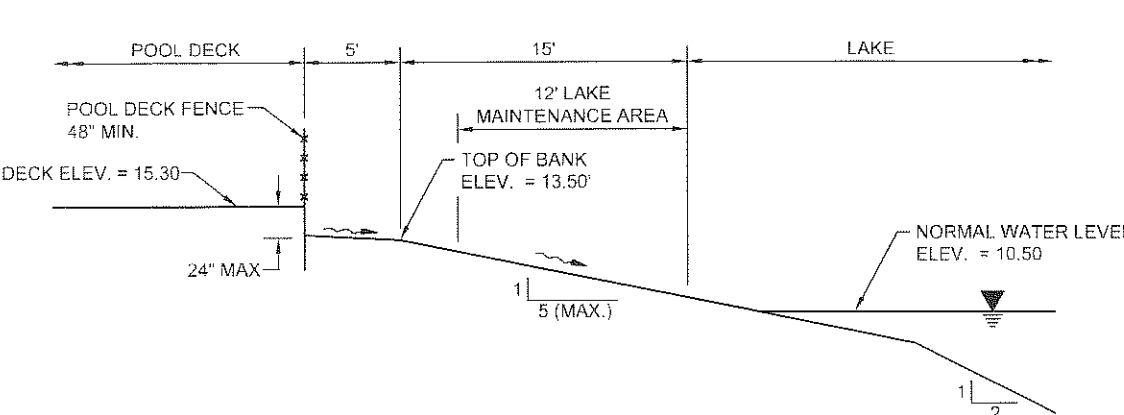


SECTION E-E
N.T.S.

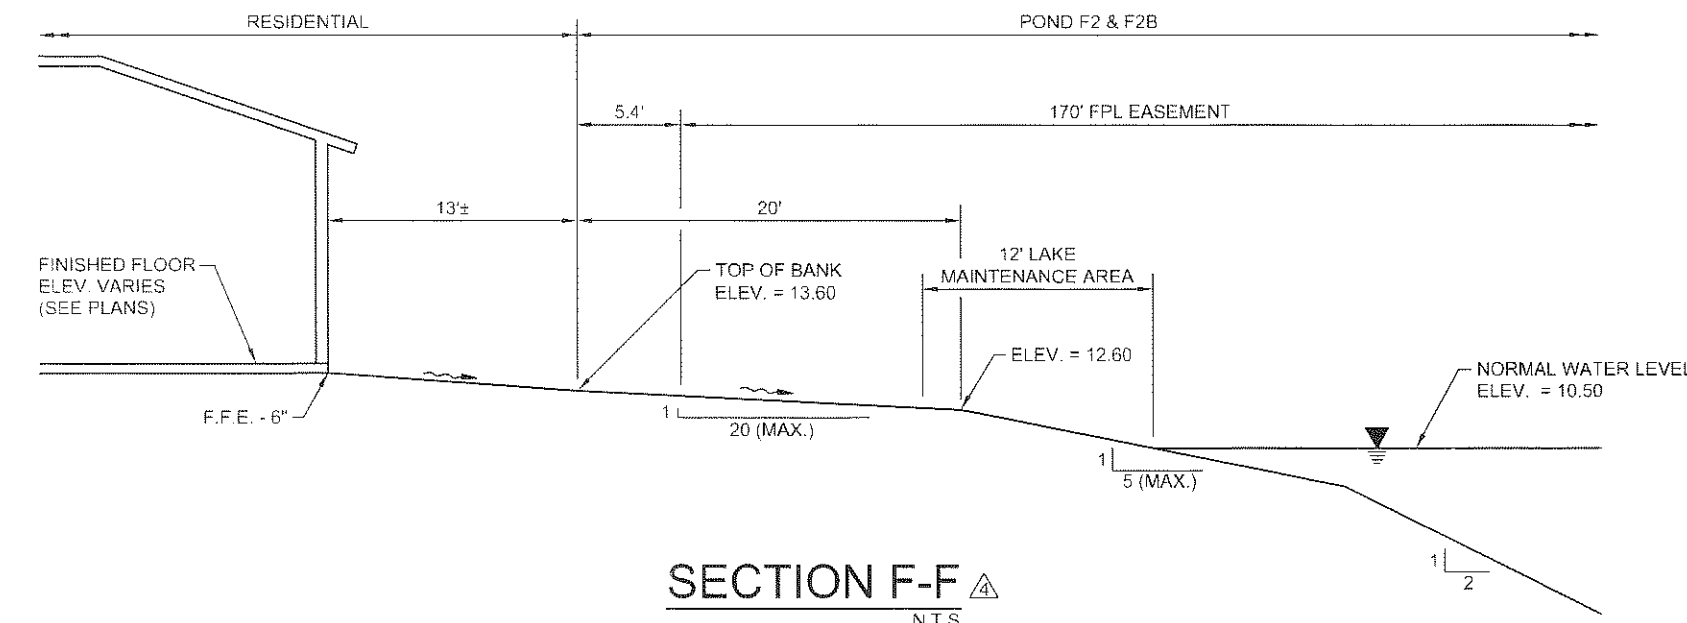


SECTION F-F
N.T.S.

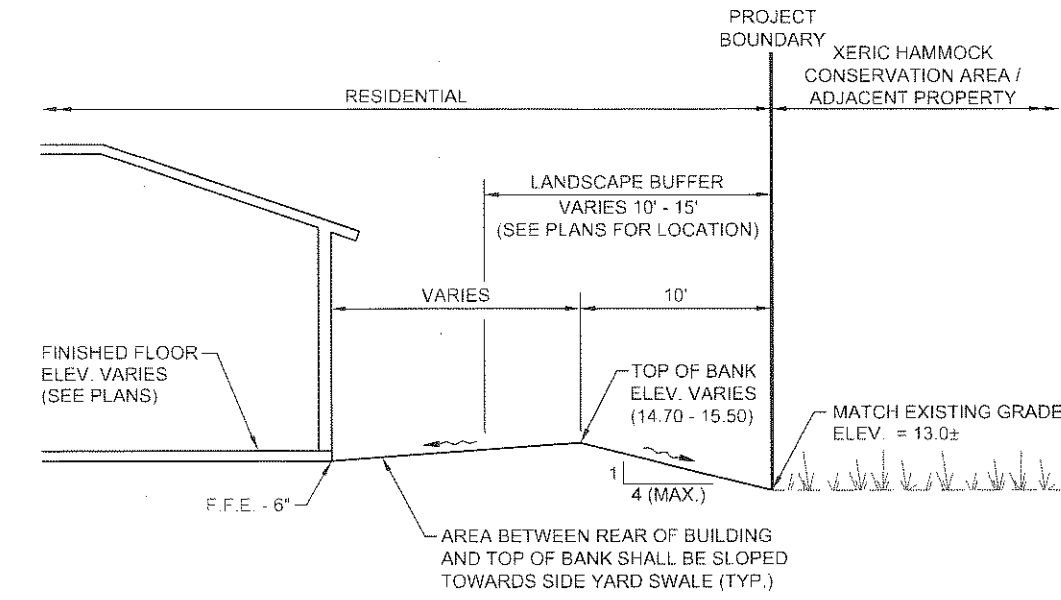


SECTION G-G 
N.T.S.

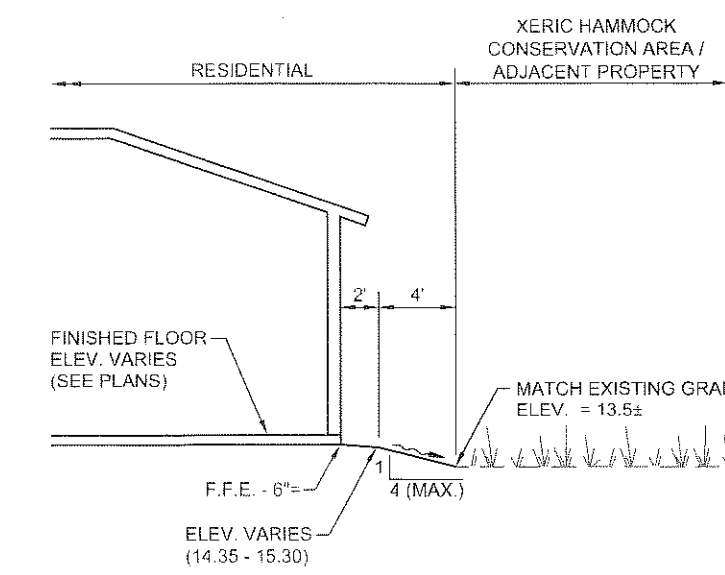

SECTION H-H 
N.T.S.









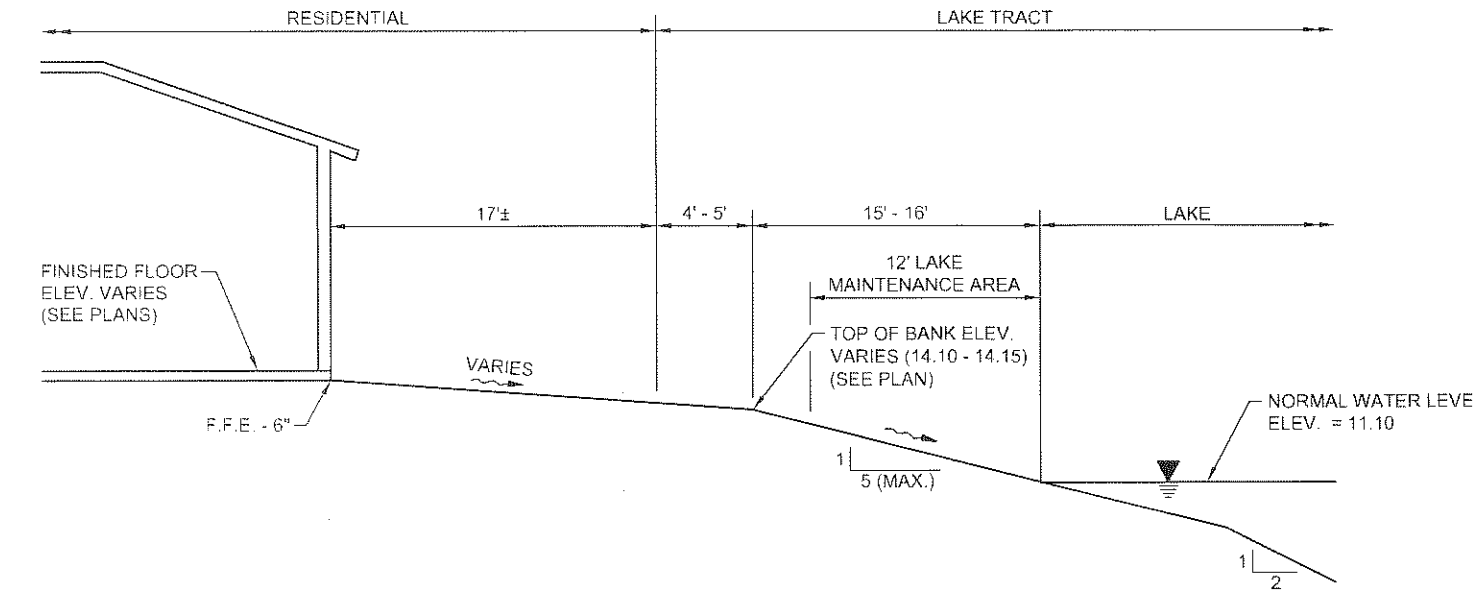


SECTION I-I 
N.T.S.

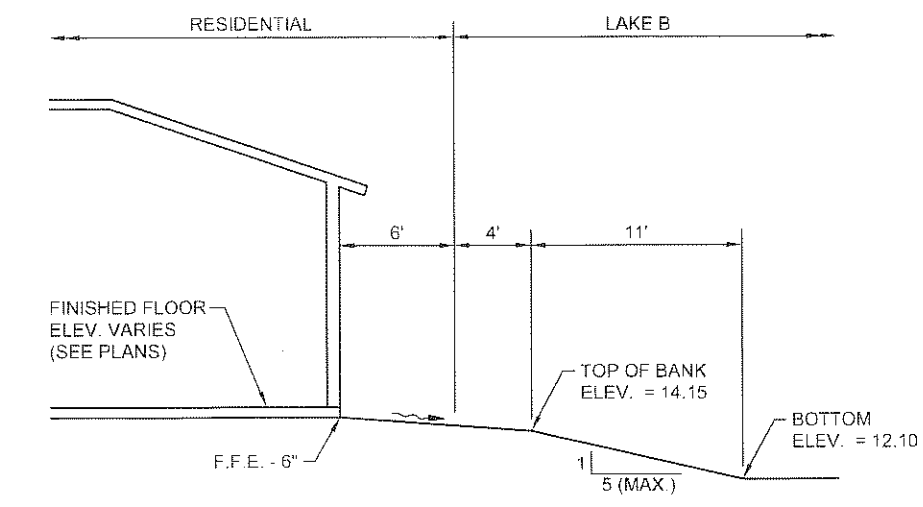

SECTION J-J
N.T.S.

[illegible]

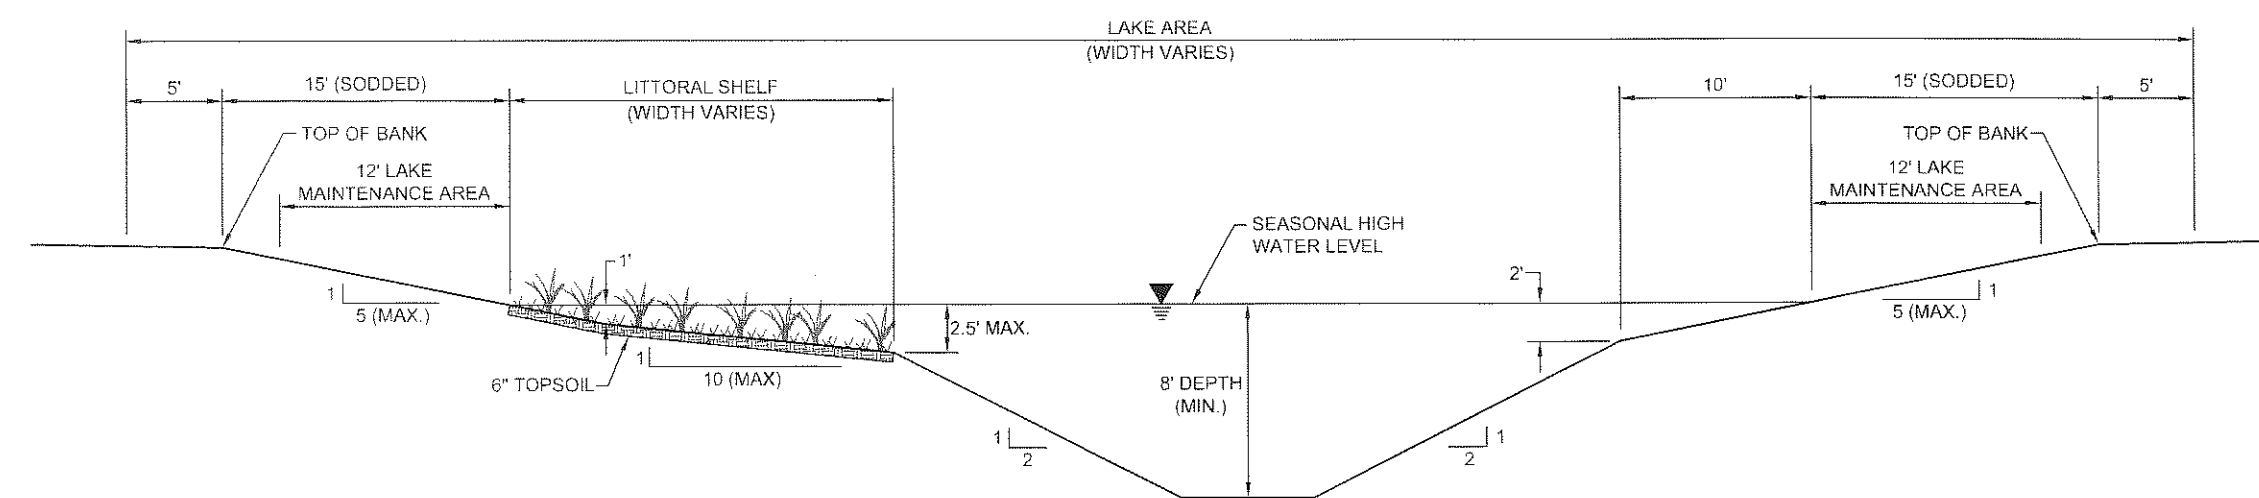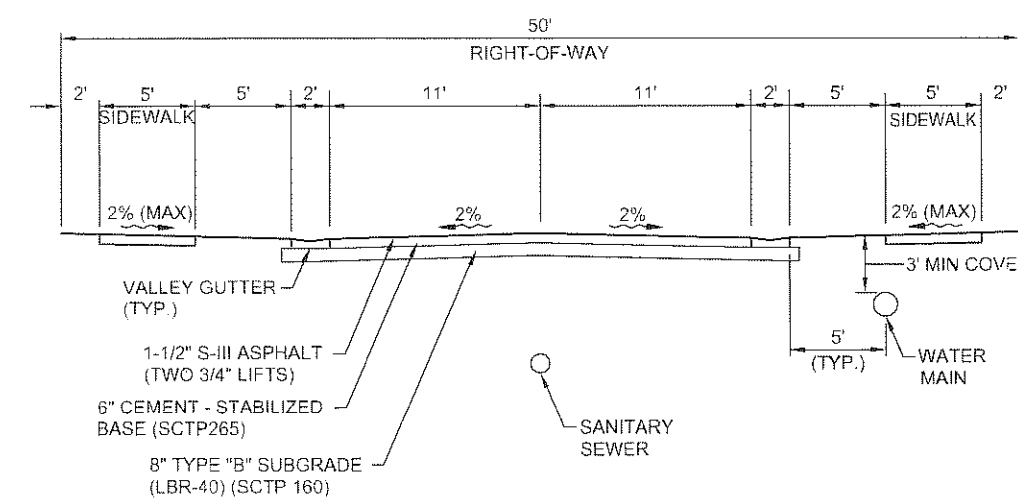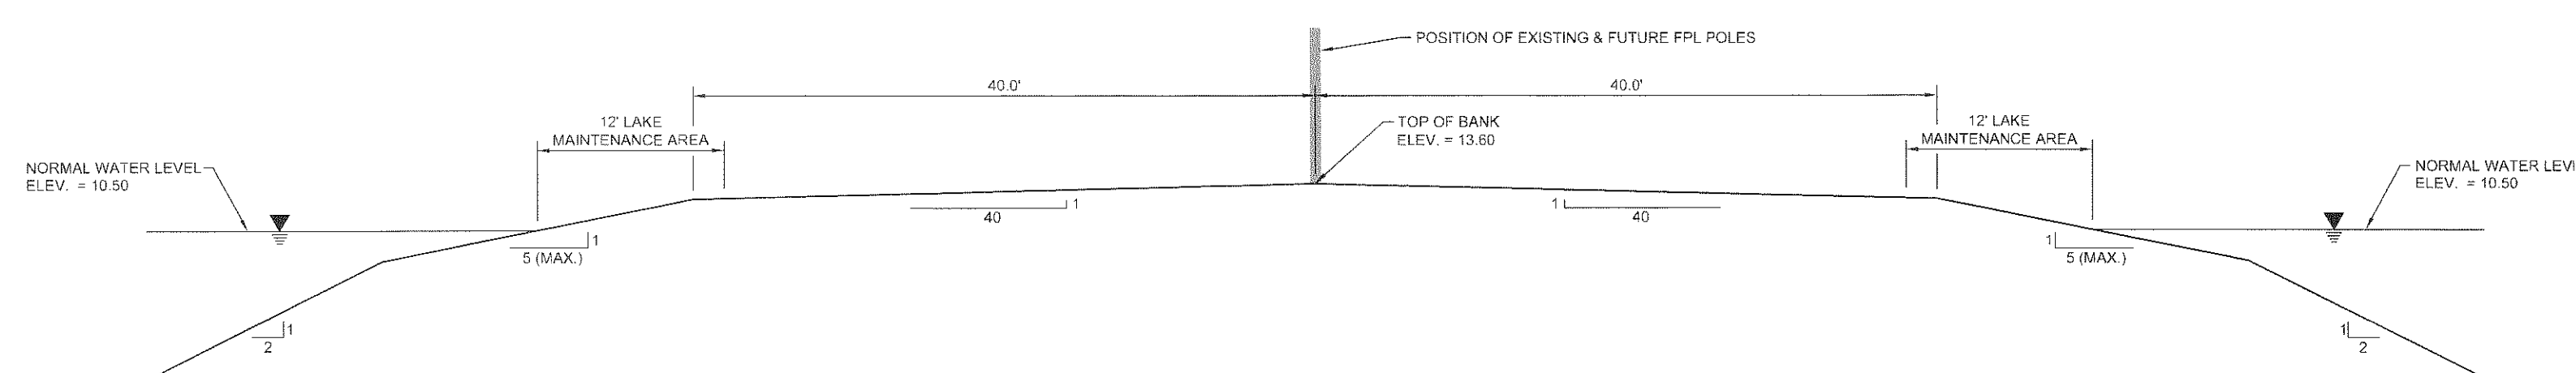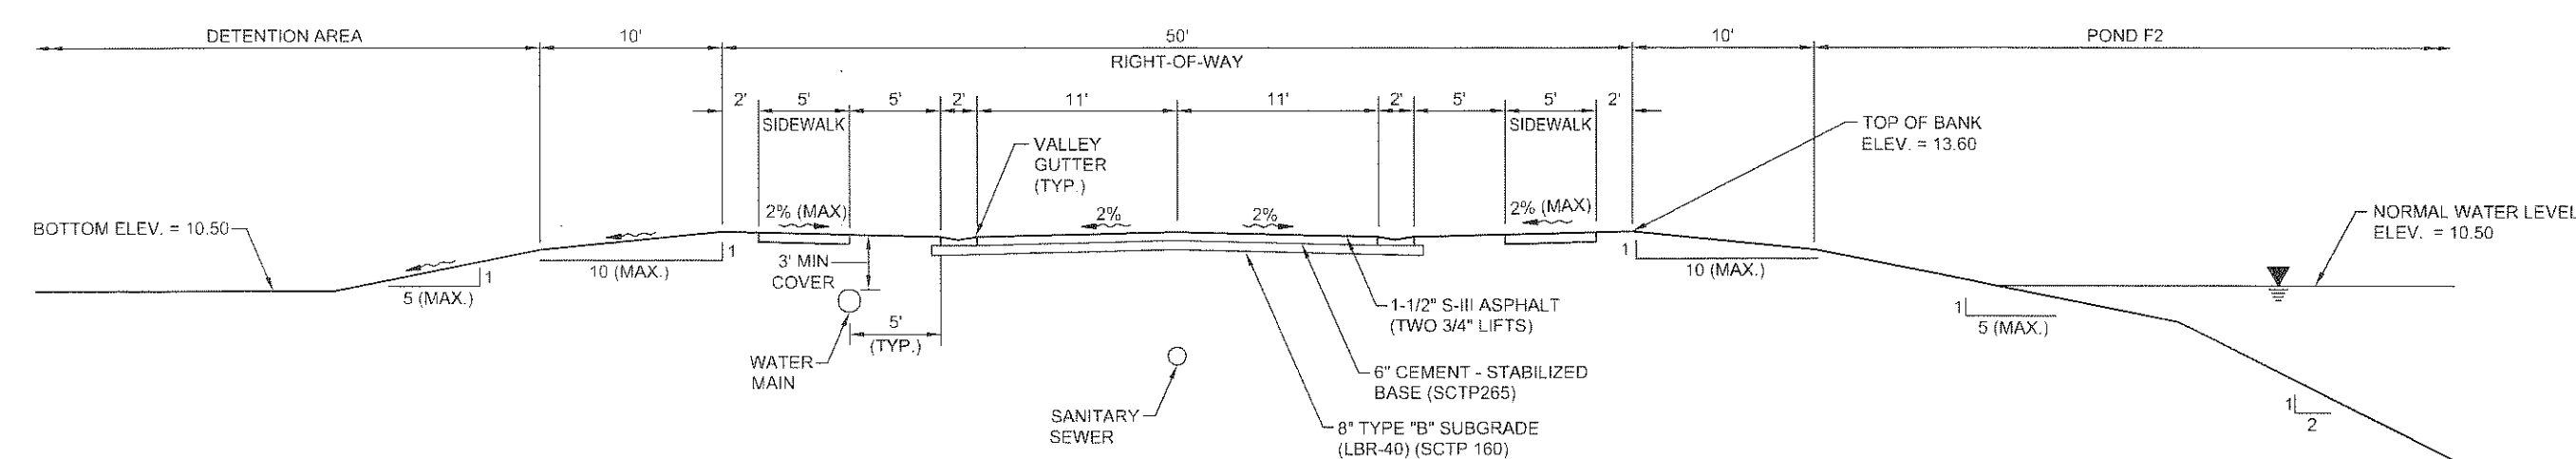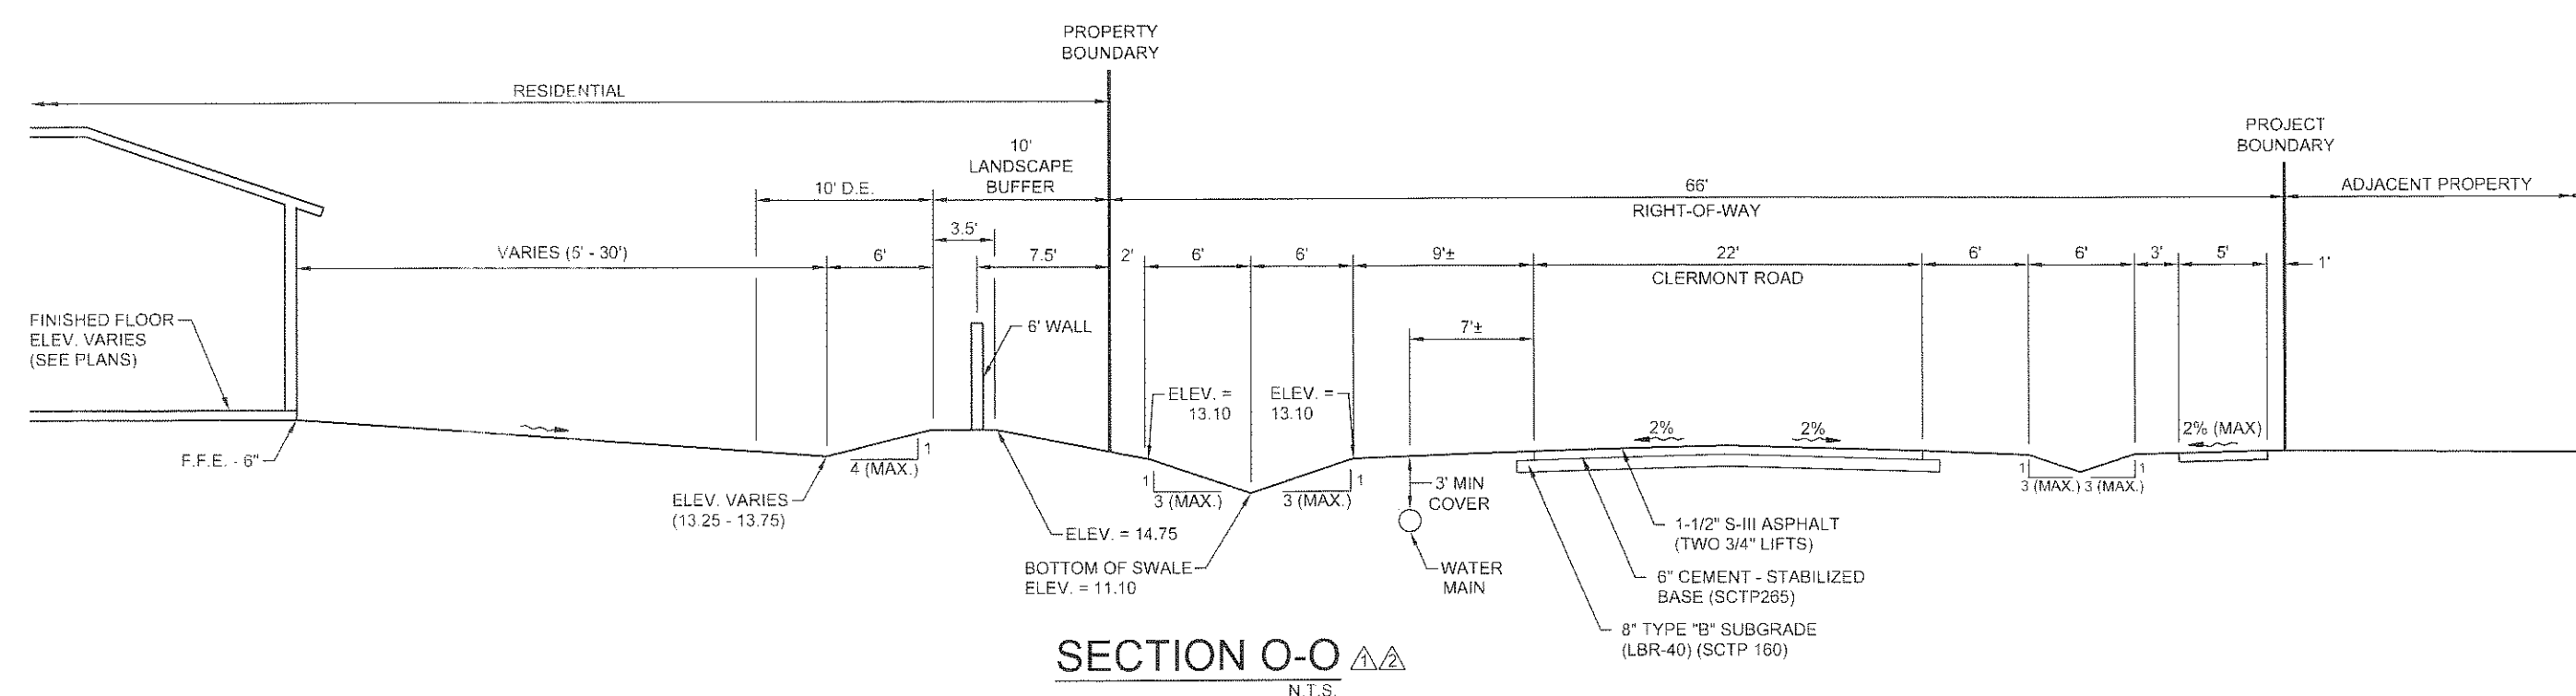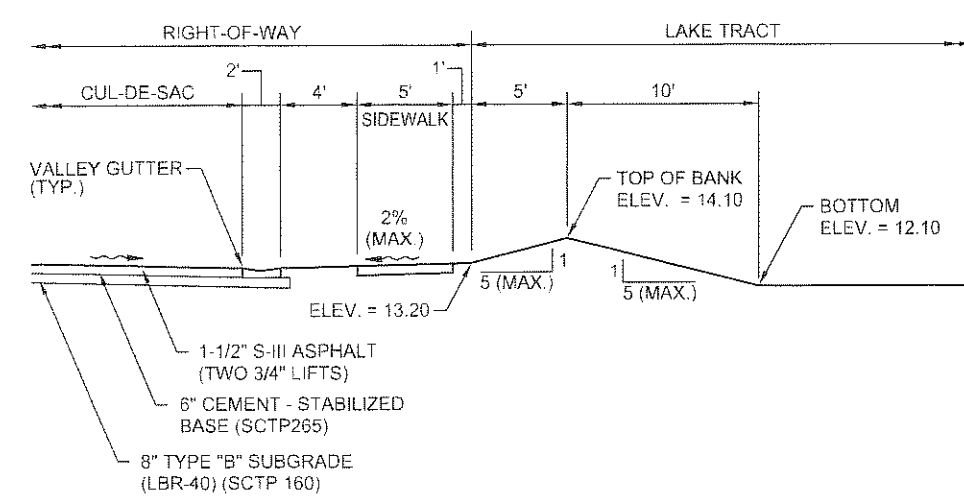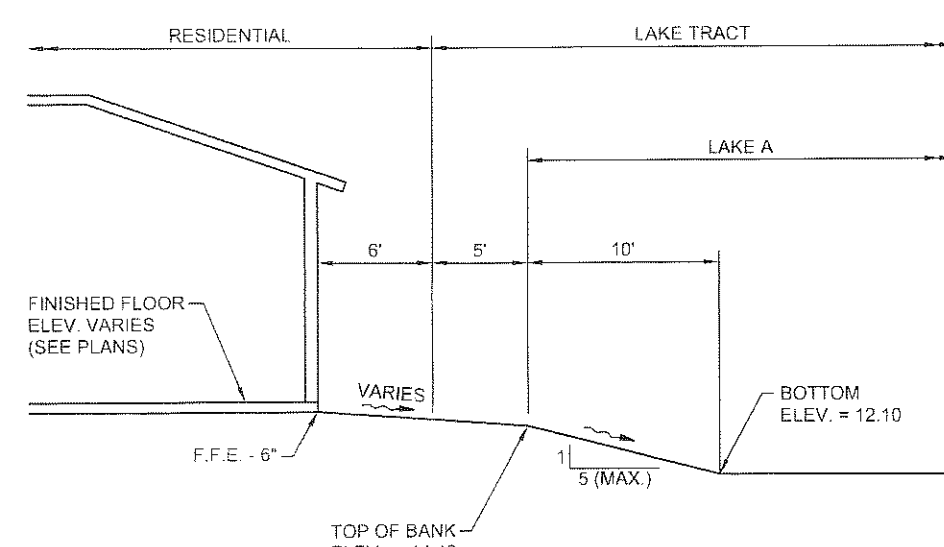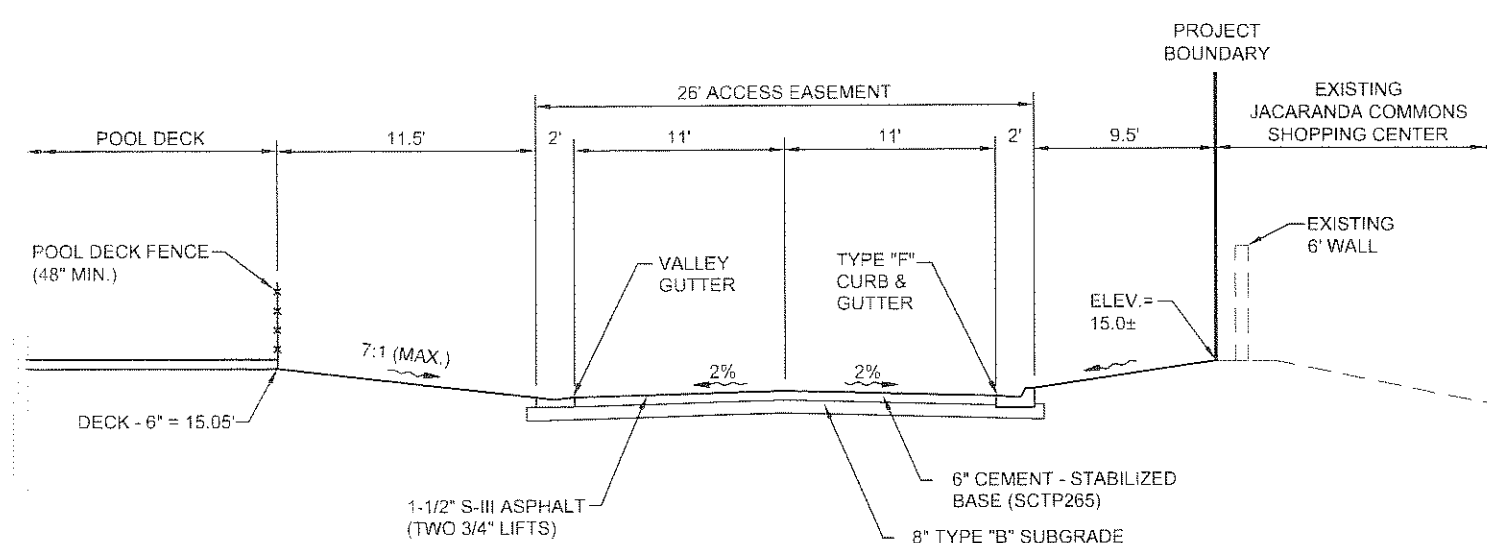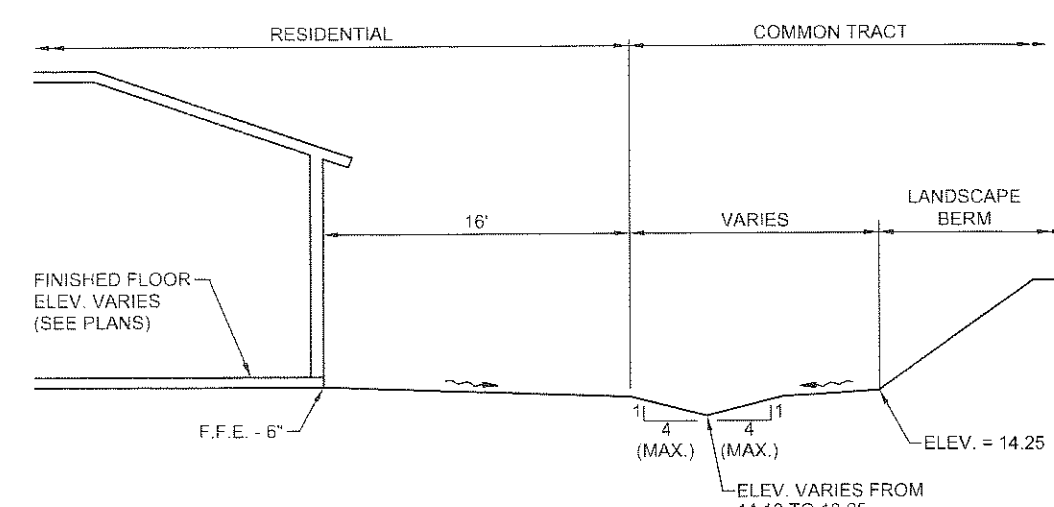

TYPICAL LAKE AREA NOTES

LITTORAL SHELF

SHELF SHALL BE VEGETATED WITH DIVERSE EMERGENT PLANTS INCLUDING SUCH SPECIES AS ARROWWEED, PICKERELWEED, BLUE FLAG, BLUE SPARGANNA, AND SPARGANNA. SOYBEAN, SOUTHERN LOTS, AND NORMAL WATER SURFACE AS REQUIRED FOR STORMWATER TREATMENT OF EACH INDIVIDUAL DETENTION AREA. ALL PLANTS TO BE NURSERY GROWN.

LITTORAL ZONE PLANTING AND MONITORING PLAN

EACH OF THE PROPOSED STORMWATER MANAGEMENT LAKES WILL EXHIBIT A LITTORAL ZONE EQUAL TO AT LEAST 30% OF THE SURFACE AREA OF THE LAKE (AT NORMAL WATER LEVEL). THE AREA OF THE LITTORAL ZONES ARE SHOWN ON THE SITE PLAN AND THE LITTORAL ZONE PLANTING SCHEDULE. THE LITTORAL ZONE IS ALSO SHOWN. THE RECOMMENDED SPECIES TO BE PLANTED WITH EACH LITTORAL ZONE ARE LISTED BELOW

1. BLUE FLAG, IRIS, GOLDEN CANN, SOFT RUSH AND ARROWHEAD (A DEPTH OF 0'-12")

2. WATER LILY, PICKERELWEED, SPIKE RUSH AND BLUE RUSH (A DEPTH OF 0'-24")


THE PLANTS WILL BE PURCHASED FROM A NURSERY AND THE PLANTINGS WILL BE MADE AT THREE FEET ON CENTER.

PLANTING SCHEDULE

LITTORAL ZONES SHOULD BE PLANTED DURING THE MONTHS OF APRIL THROUGH SEPTEMBER. LITTORAL ZONES IN LAKES EXCAVATED DURING THESE MONTHS SHALL BE PLANTED WITHIN THIRTY (30) DAYS FOLLOWING EXCAVATION. PROVIDED THAT THE LITTORAL ZONES IN LAKES EXCAVATED DURING THE MONTHS OF OCTOBER THROUGH MARCH SHALL BE PLANTED BY APRIL 30. THE JOINT RESOURCE PROTECTION SERVICES SHALL BE NOTIFIED BY THE CITY OF GARCIA OF THE PLANTING SCHEDULE. THE CITY OF GARCIA SHALL BE RESPONSIBLE FOR THE PLANTING OF THE PROPERTY OWNER. A MONITORING AND MAINTENANCE BOND WILL BE SUBMITTED TO GARCASOTA COUNTY RESOURCE PROTECTION SERVICES FOR THE LITTORAL ZONES. THE BOND SHALL BE FOR THE MAINTENANCE AND REPLANTING OF THE LITTORAL ZONES PRIOR TO EXCAVATION PURSUANT TO THE LDR ENVIRONMENTAL TECHNICAL MANUAL, SECTION A.10. THIS BOND SHALL REMAIN IN EFFECT FOR THE LITTORAL ZONES.


[illegible]

1/23/25-01 Verona Reserve/AlterCAD/25-01-01 Concurrent Subdivision Plans/250101.dwg Dec 14, 2010 2:19pm

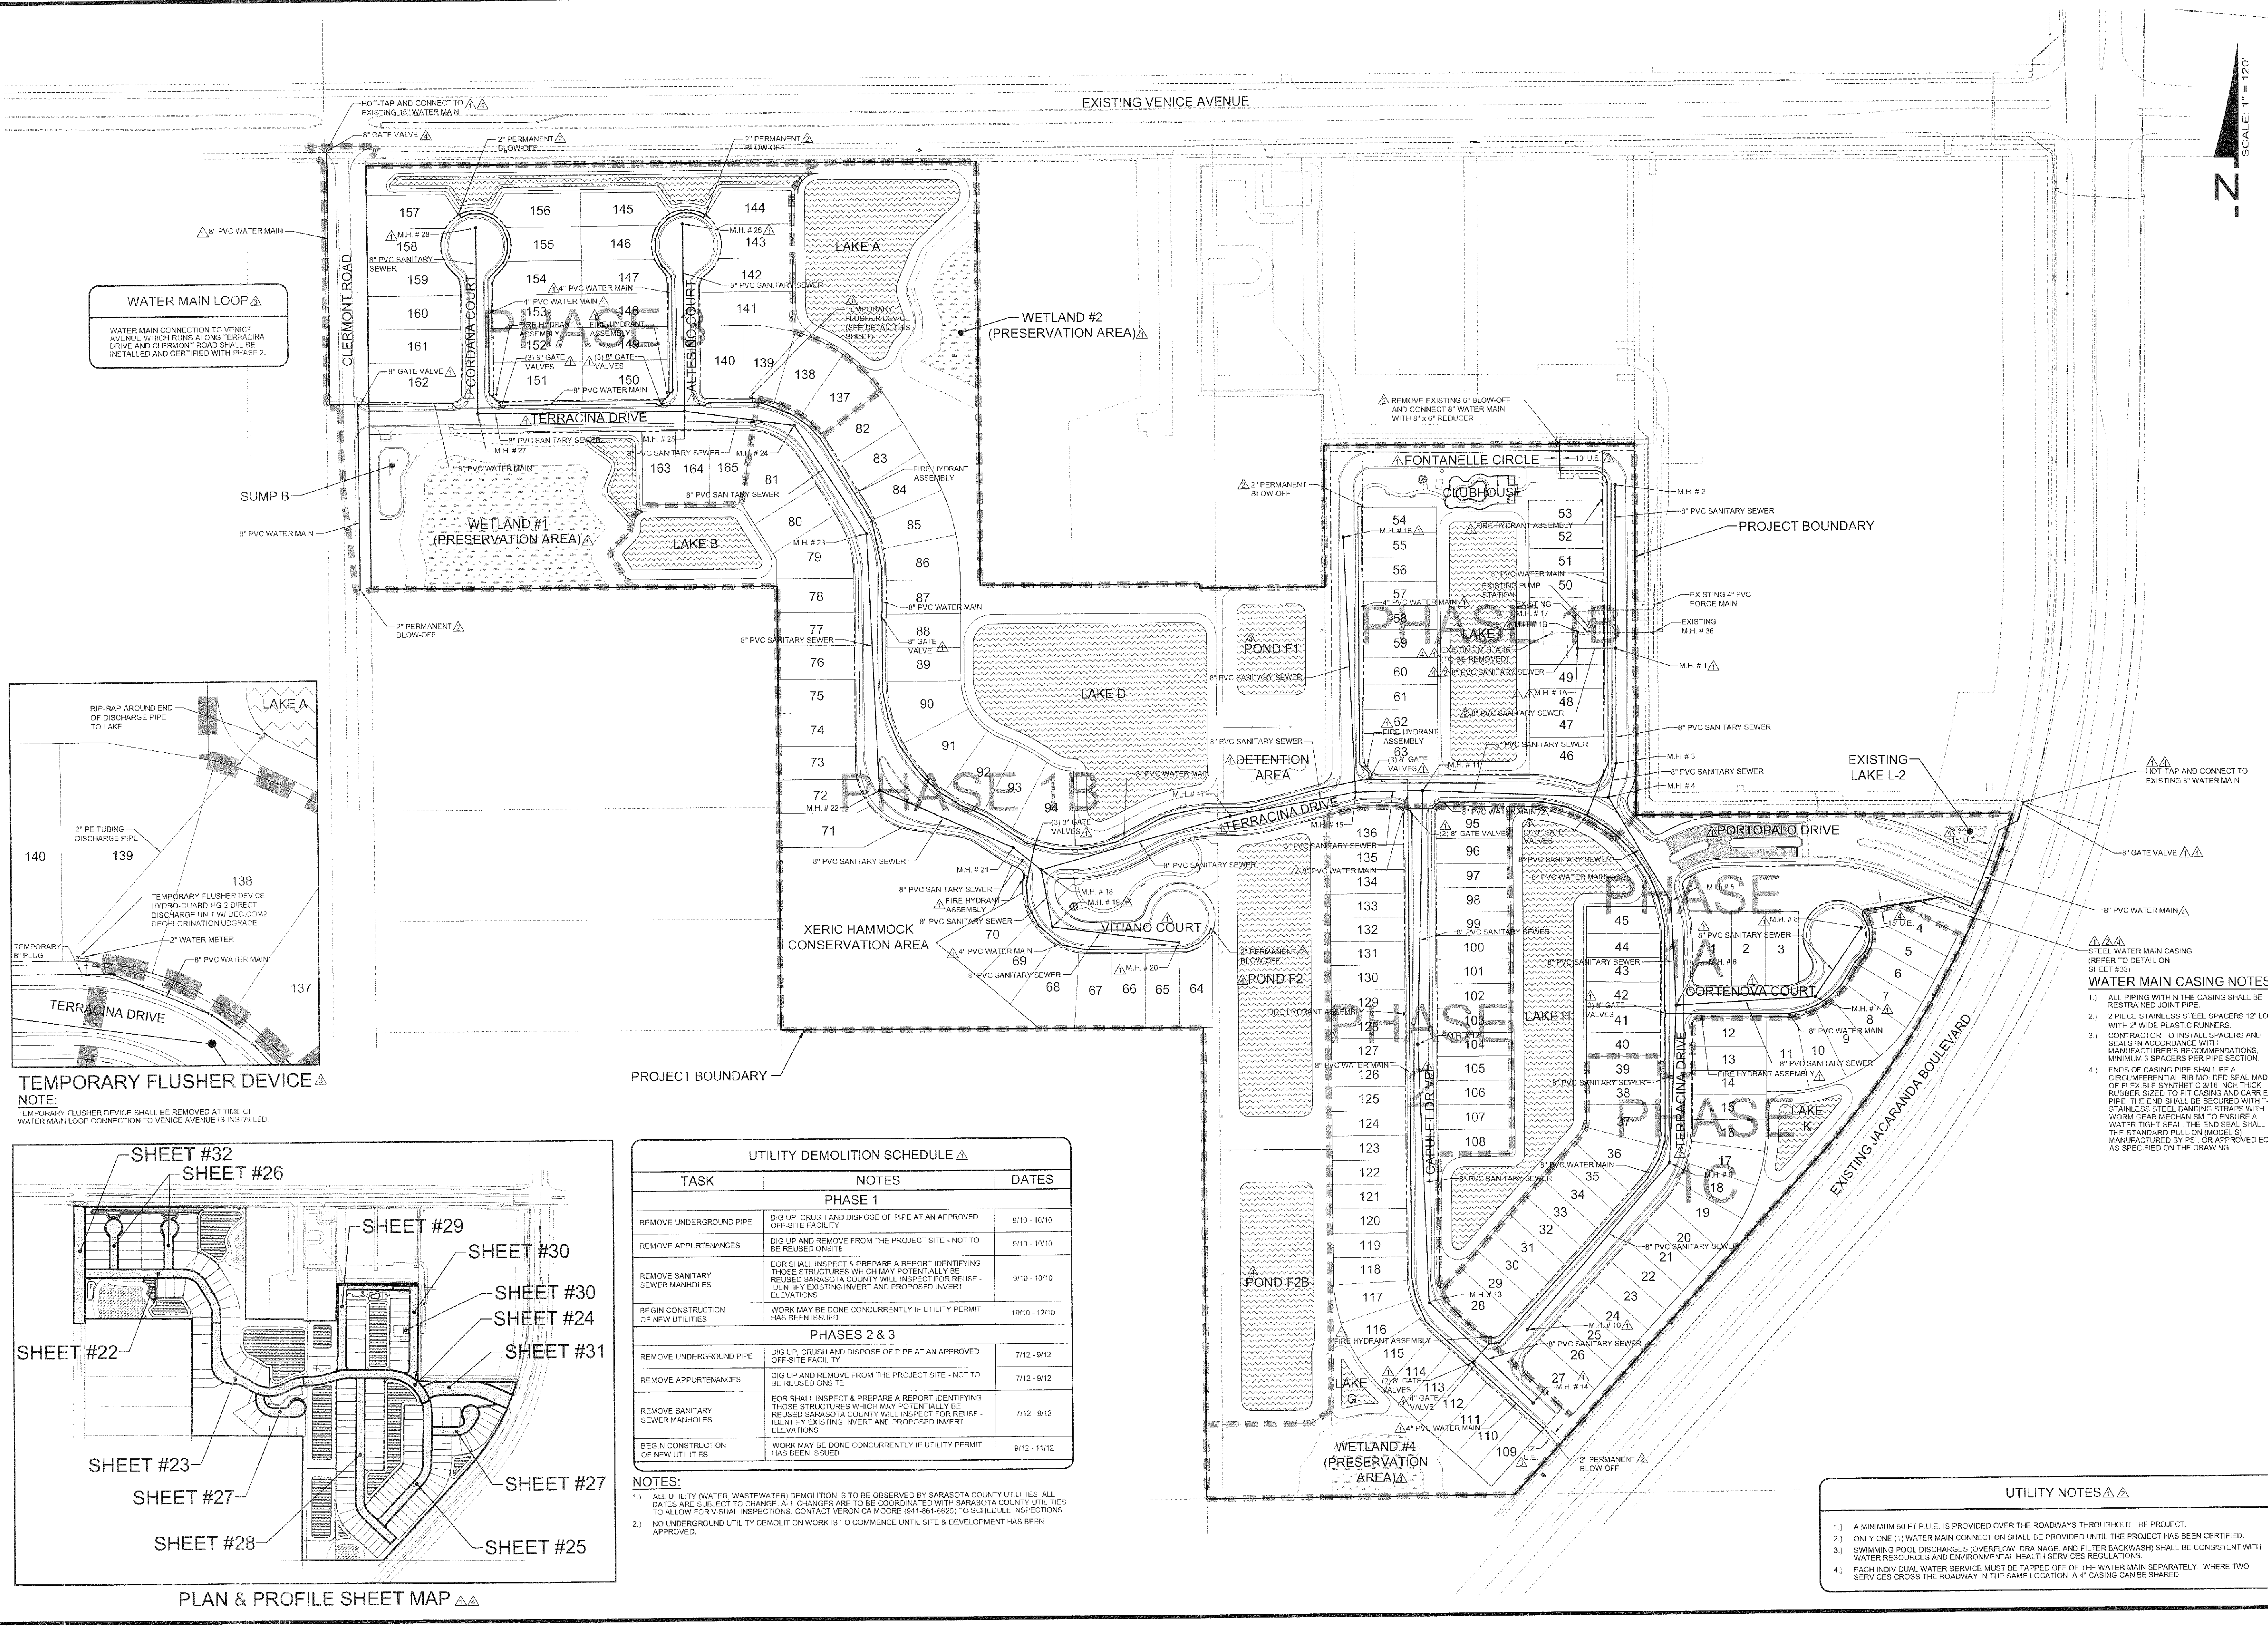


WATER MAIN LOOP

WATER MAIN CONNECTION TO VENICE AVENUE WHICH RUNS ALONG TERRACINA DRIVE AND CLERMONT ROAD SHALL BE INSTALLED AND CERTIFIED WITH PHASE 2.

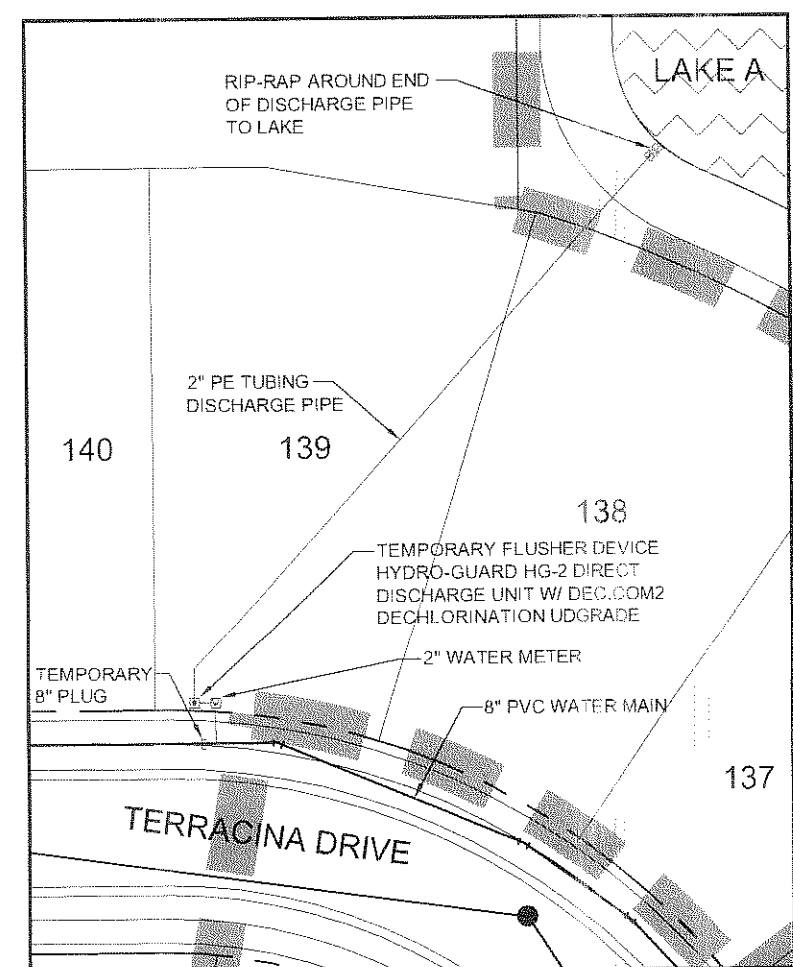

TEMPORARY FLUSHER DEVICE

NOTE:
TEMPORARY FLUSHER DEVICE SHALL BE REMOVED AT TIME OF WATER MAIN LOOP CONNECTION TO VENICE AVENUE IS INSTALLED.

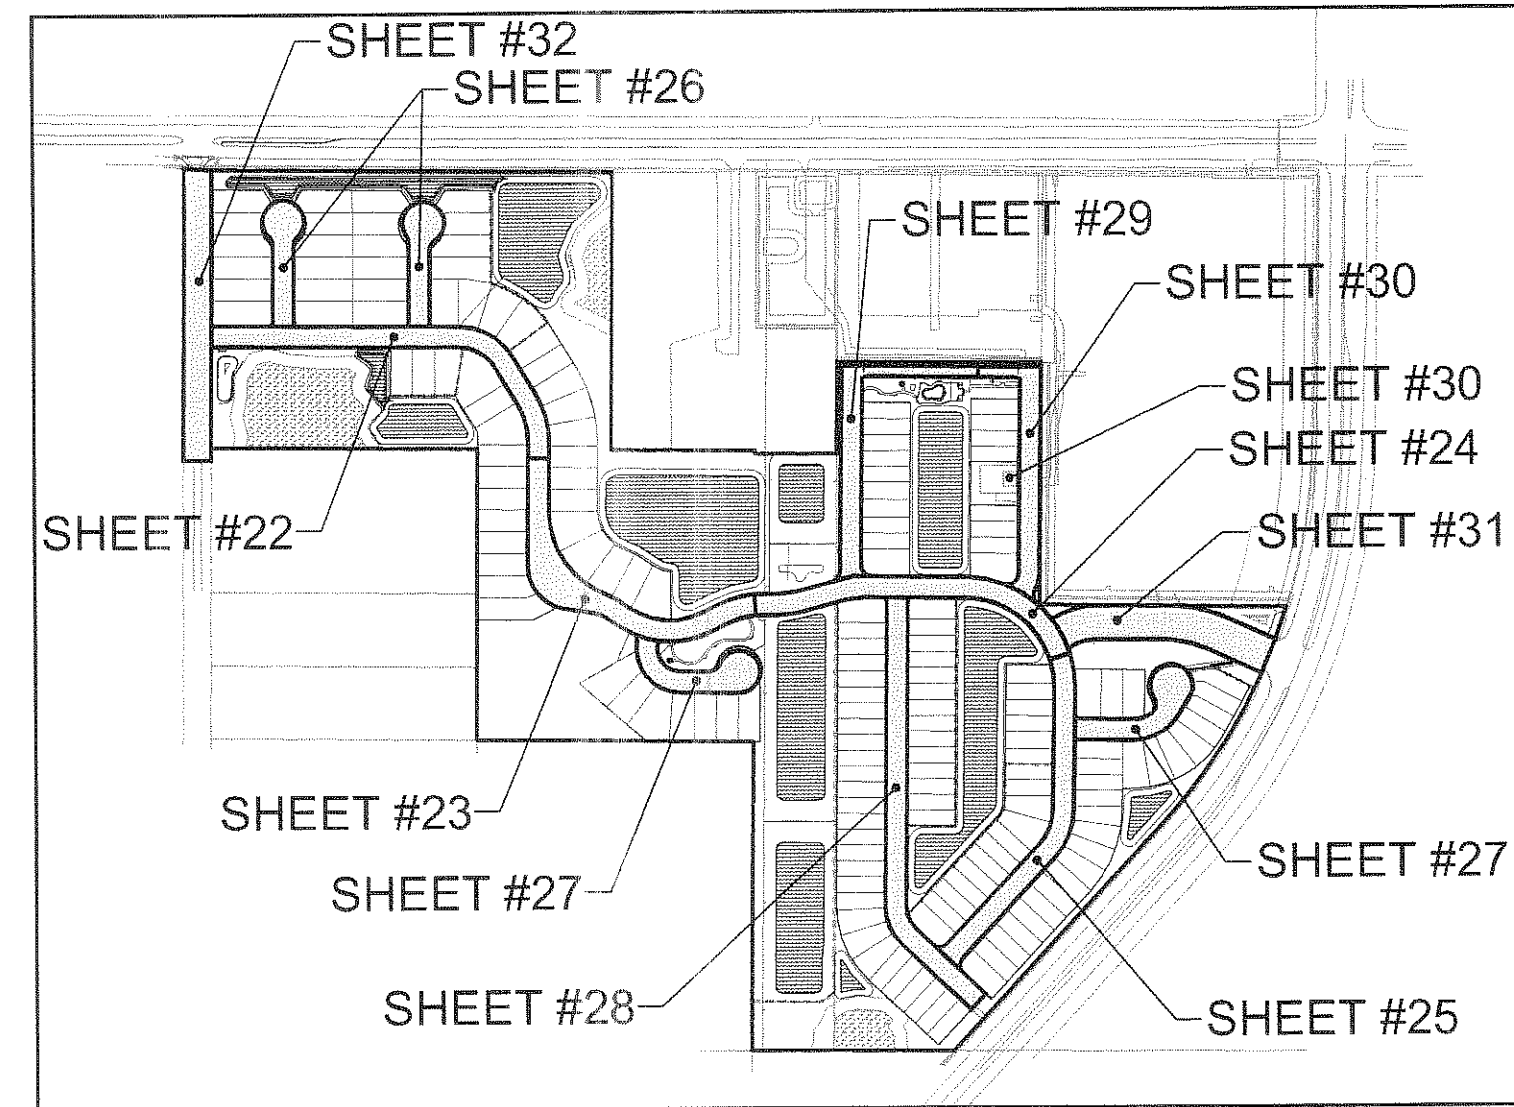

PLAN & PROFILE SHEET MAP

UTILITY DEMOLITION SCHEDULE		
TASK	NOTES	DATES
PHASE 1		
REMOVE UNDERGROUND PIPE	DIG UP, CRUSH AND DISPOSE OF PIPE AT AN APPROVED OFF-SITE FACILITY	9/10 - 10/10
REMOVE APPURTENANCES	DIG UP AND REMOVE FROM THE PROJECT SITE - NOT TO BE REUSED ON-SITE	9/10 - 10/10
REMOVE SANITARY SEWER MANHOLES	EOR SHALL INSPECT & PREPARE A REPORT IDENTIFYING THOSE STRUCTURES WHICH MAY POTENTIALLY BE REUSED. SARASOTA COUNTY WILL INSPECT FOR REUSE. IDENTIFY EXISTING INVERT AND PROPOSED INVERT ELEVATIONS	9/10 - 10/10
BEGIN CONSTRUCTION OF NEW UTILITIES	WORK MAY BE DONE CONCURRENTLY IF UTILITY PERMIT HAS BEEN ISSUED	10/10 - 12/10
PHASES 2 & 3		
REMOVE UNDERGROUND PIPE	DIG UP, CRUSH AND DISPOSE OF PIPE AT AN APPROVED OFF-SITE FACILITY	7/12 - 9/12
REMOVE APPURTENANCES	DIG UP AND REMOVE FROM THE PROJECT SITE - NOT TO BE REUSED ON-SITE	7/12 - 9/12
REMOVE SANITARY SEWER MANHOLES	EOR SHALL INSPECT & PREPARE A REPORT IDENTIFYING THOSE STRUCTURES WHICH MAY POTENTIALLY BE REUSED. SARASOTA COUNTY WILL INSPECT FOR REUSE. IDENTIFY EXISTING INVERT AND PROPOSED INVERT ELEVATIONS	7/12 - 9/12
BEGIN CONSTRUCTION OF NEW UTILITIES	WORK MAY BE DONE CONCURRENTLY IF UTILITY PERMIT HAS BEEN ISSUED	9/12 - 11/12

NOTES:

1.) ALL UTILITY (WATER, WASTEWATER) DEMOLITION IS TO BE OBSERVED BY SARASOTA COUNTY UTILITIES. ALL DATES ARE SUBJECT TO CHANGE. ALL CHANGES ARE TO BE COORDINATED WITH SARASOTA COUNTY UTILITIES TO ALLOW FOR VISUAL INSPECTIONS. CONTACT VERONICA MOORE (941-861-6925) TO SCHEDULE INSPECTIONS.

2.) NO UNDERGROUND UTILITY DEMOLITION WORK IS TO COMMENCE UNTIL SITE & DEVELOPMENT HAS BEEN APPROVED.

WATER MAIN CASING NOTES:

1.) ALL PIPING WITHIN THE CASING SHALL BE RESTRAINED JOINT PIPE.

2.) 2 PICES STAINLESS STEEL SPACERS 12" LONG WITH 2" WIDE PLASTIC RUNNERS.

3.) CONTRACTOR TO INSTALL SPACERS AND SEALS IN ACCORDANCE WITH MANUFACTURER'S RECOMMENDATIONS. MINIMUM 3 SPACERS PER PIPE SECTION.

4.) ENDS OF CASING PIPE SHALL BE A CIRCUMFERENTIAL RIB MOLDED SEAL MADE OF FLEXIBLE SYNTHETIC 3/16 INCH THICK RUBBER SIZED TO FIT CASING AND CARRIER PIPE. THE END SHALL BE SECURED WITH 1/4" STAINLESS STEEL BANDING STRAPS WITH WORM GEAR MECHANISM TO ENSURE A WATER TIGHT SEAL. THE END SEAL SHALL BE THE STANDARD PULL-ON (MODEL S) MANUFACTURED BY PSI, OR APPROVED EQUAL AS SPECIFIED ON THE DRAWINGS.

UTILITY NOTES

1.) A MINIMUM 50 FT P.U.E. IS PROVIDED OVER THE ROADWAYS THROUGHOUT THE PROJECT.

2.) ONLY ONE (1) WATER MAIN CONNECTION SHALL BE PROVIDED UNTIL THE PROJECT HAS BEEN CERTIFIED.

3.) SWIMMING POOL DISCHARGES (OVERFLOW, DRAINAGE, AND FILTER BACKWASH) SHALL BE CONSISTENT WITH WATER RESOURCES AND ENVIRONMENTAL HEALTH SERVICES REGULATIONS.

4.) EACH INDIVIDUAL WATER SERVICE MUST BE TAPPED OFF OF THE WATER MAIN SEPARATELY, WHERE TWO SERVICES CROSS THE ROADWAY IN THE SAME LOCATION A 4" CASING CAN BE SHARED.

WALDROP ENGINEERING

Civil Engineering & Land Development Consultants
26100 BONITA GRANDE DRIVE, SUITE 305 BONITA SPRINGS, FL 34135
P: 239-495-7777 F: 239-495-7699 EMAIL: info@waldropengineering.com

VERONA RESERVE

CLIENT: TAYLOR MORRISON OF FLORIDA, INC.




MASTER UTILITY PLAN

PLAN REVISIONS			
07/29/10	REVISED PER SARASOTA COUNTY COMMENTS		
08/14/10	REVISED PER SARASOTA COUNTY COMMENTS		
10/04/10	REVISED PER SARASOTA COUNTY COMMENTS		
12/14/10	REVISED PER CLIENT & S.C.U. COMMENTS & REVISIT FIELD DEVIATION		

NICHOLAS B. SPECKLE
FL CERTIFICATE NO. 70207

SET NUMBER: 225-01-01
SHEET: 21




I:\225-01 Verona Reserve\dwg\225-01.dwg Created: 12/15/10 10:22:00 AM Dec 14, 2010 2:10pm

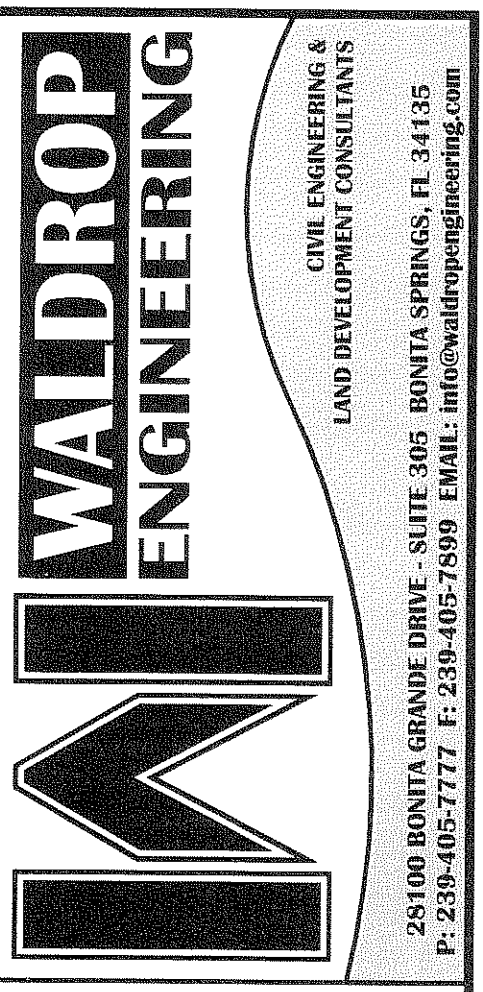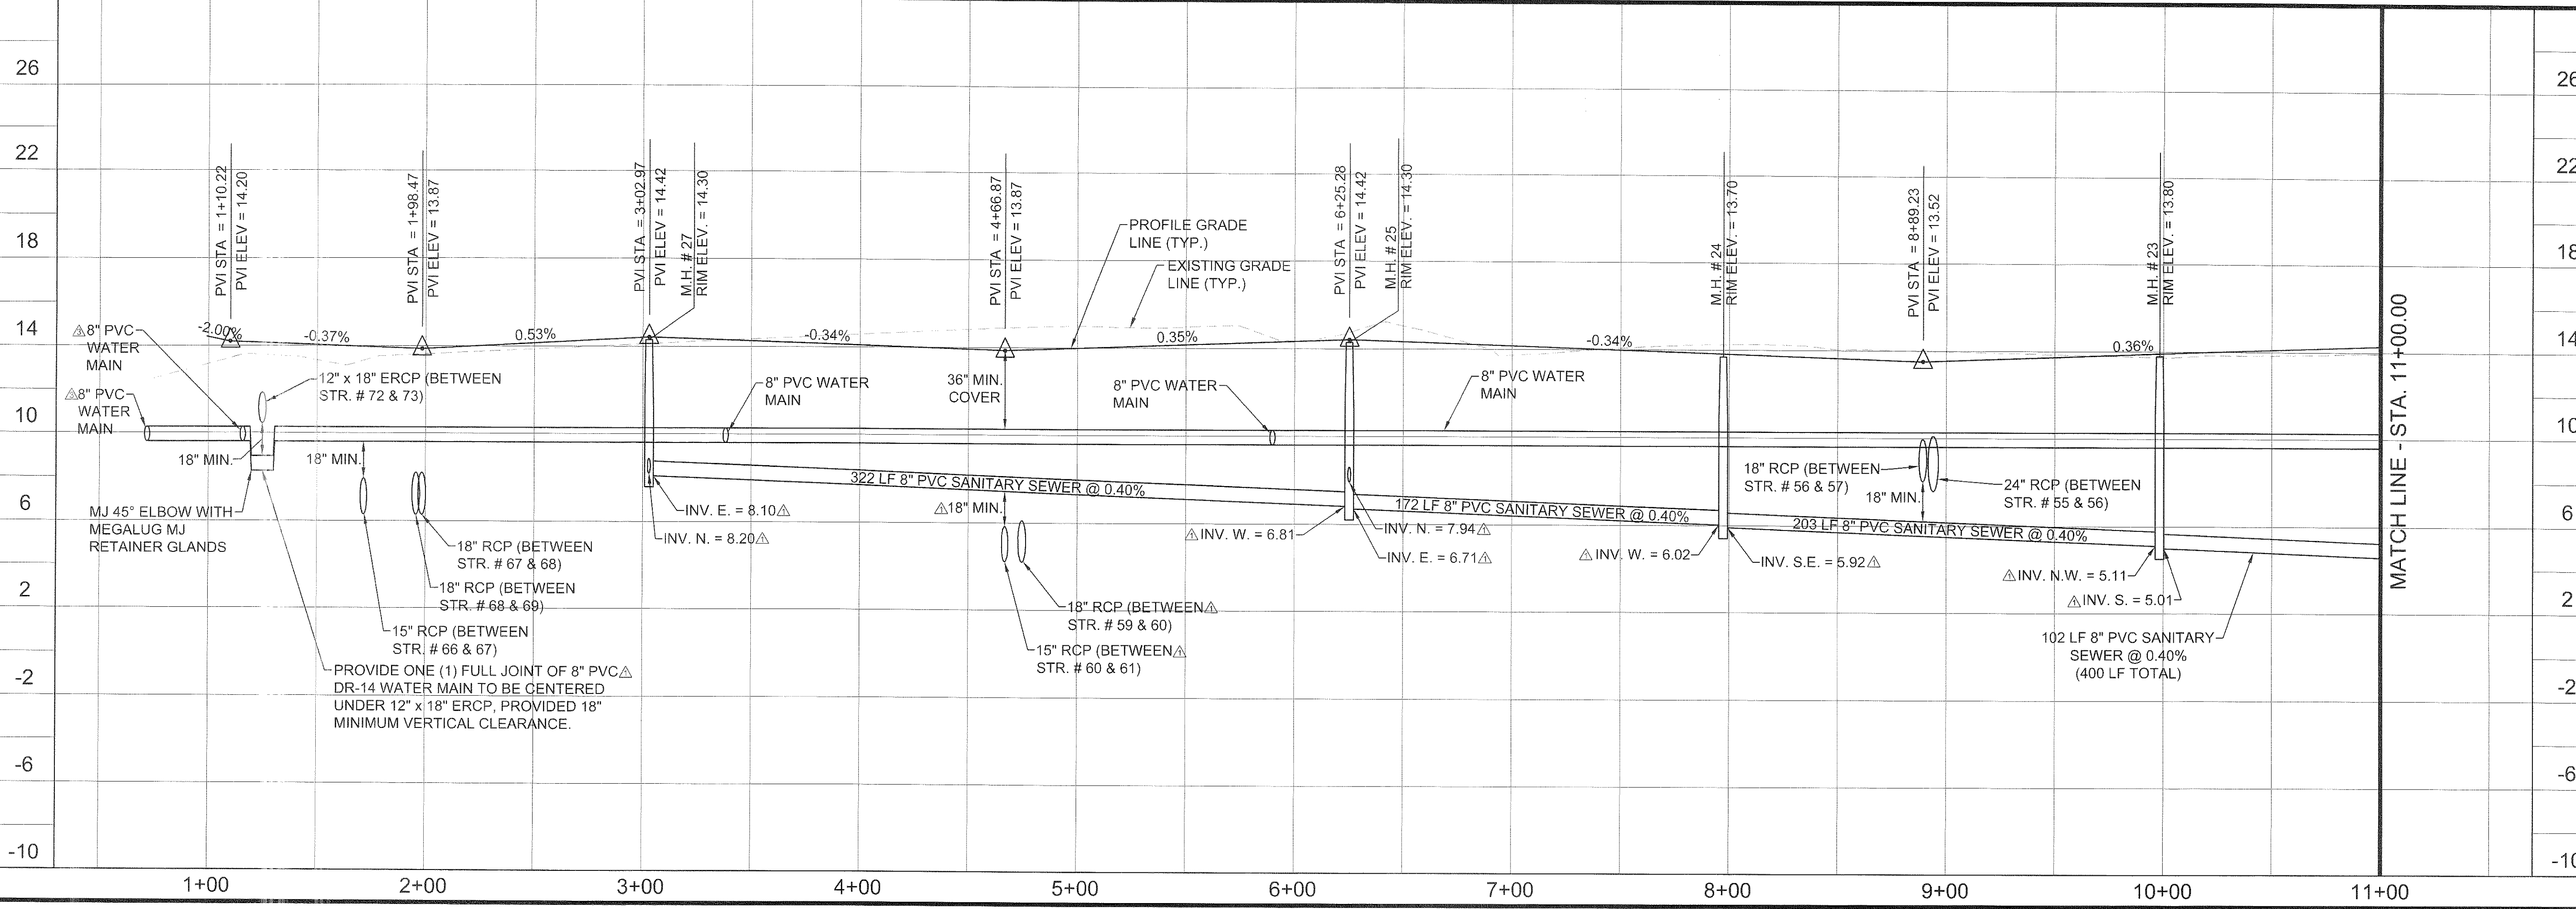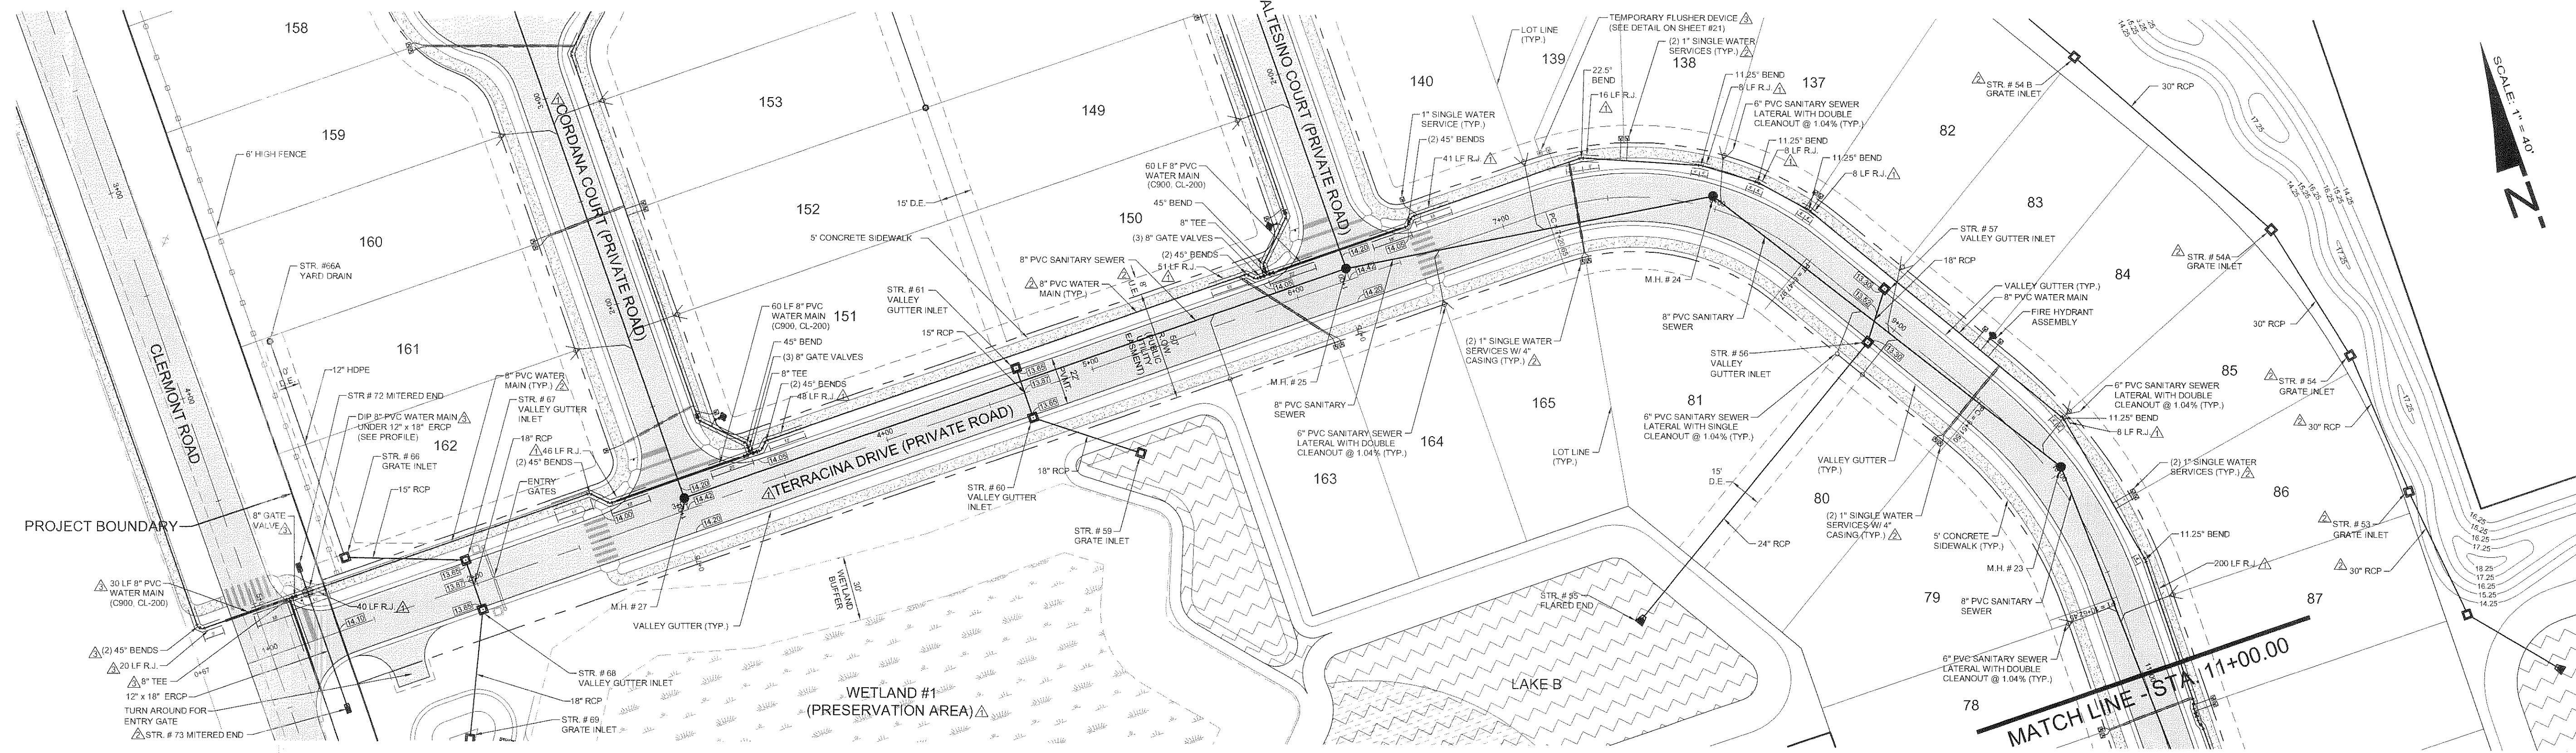

CIVIL ENGINEERING &
LAND DEVELOPMENT CONSULTANTS
25100 BONITA GRANDE DRIVE - SUITE 305 BONITA SPRINGS, FL 34135
P: 239-405-7777 F: 239-405-7999 EMAIL: info@waldropengineering.com

VERONA RESERVE
CLIENT: TAYLOR MORRISON OF FLORIDA, INC.
PLAN AND PROFILE: TERRACINA DRIVE
(STA. 1+00.00 TO STA. 11+00.00)

PLAN REVISIONS	
07/28/10	REVISED PER SARASOTA COUNTY COMMENTS
09/14/10	REVISED PER SARASOTA COUNTY COMMENTS
10/04/10	REVISED PER SARASOTA COUNTY COMMENTS
FLORIDA CERTIFICATE OF AUTHORIZATION #6616	
SHEET NUMBER: 225-01-01	
SHEET: 22	

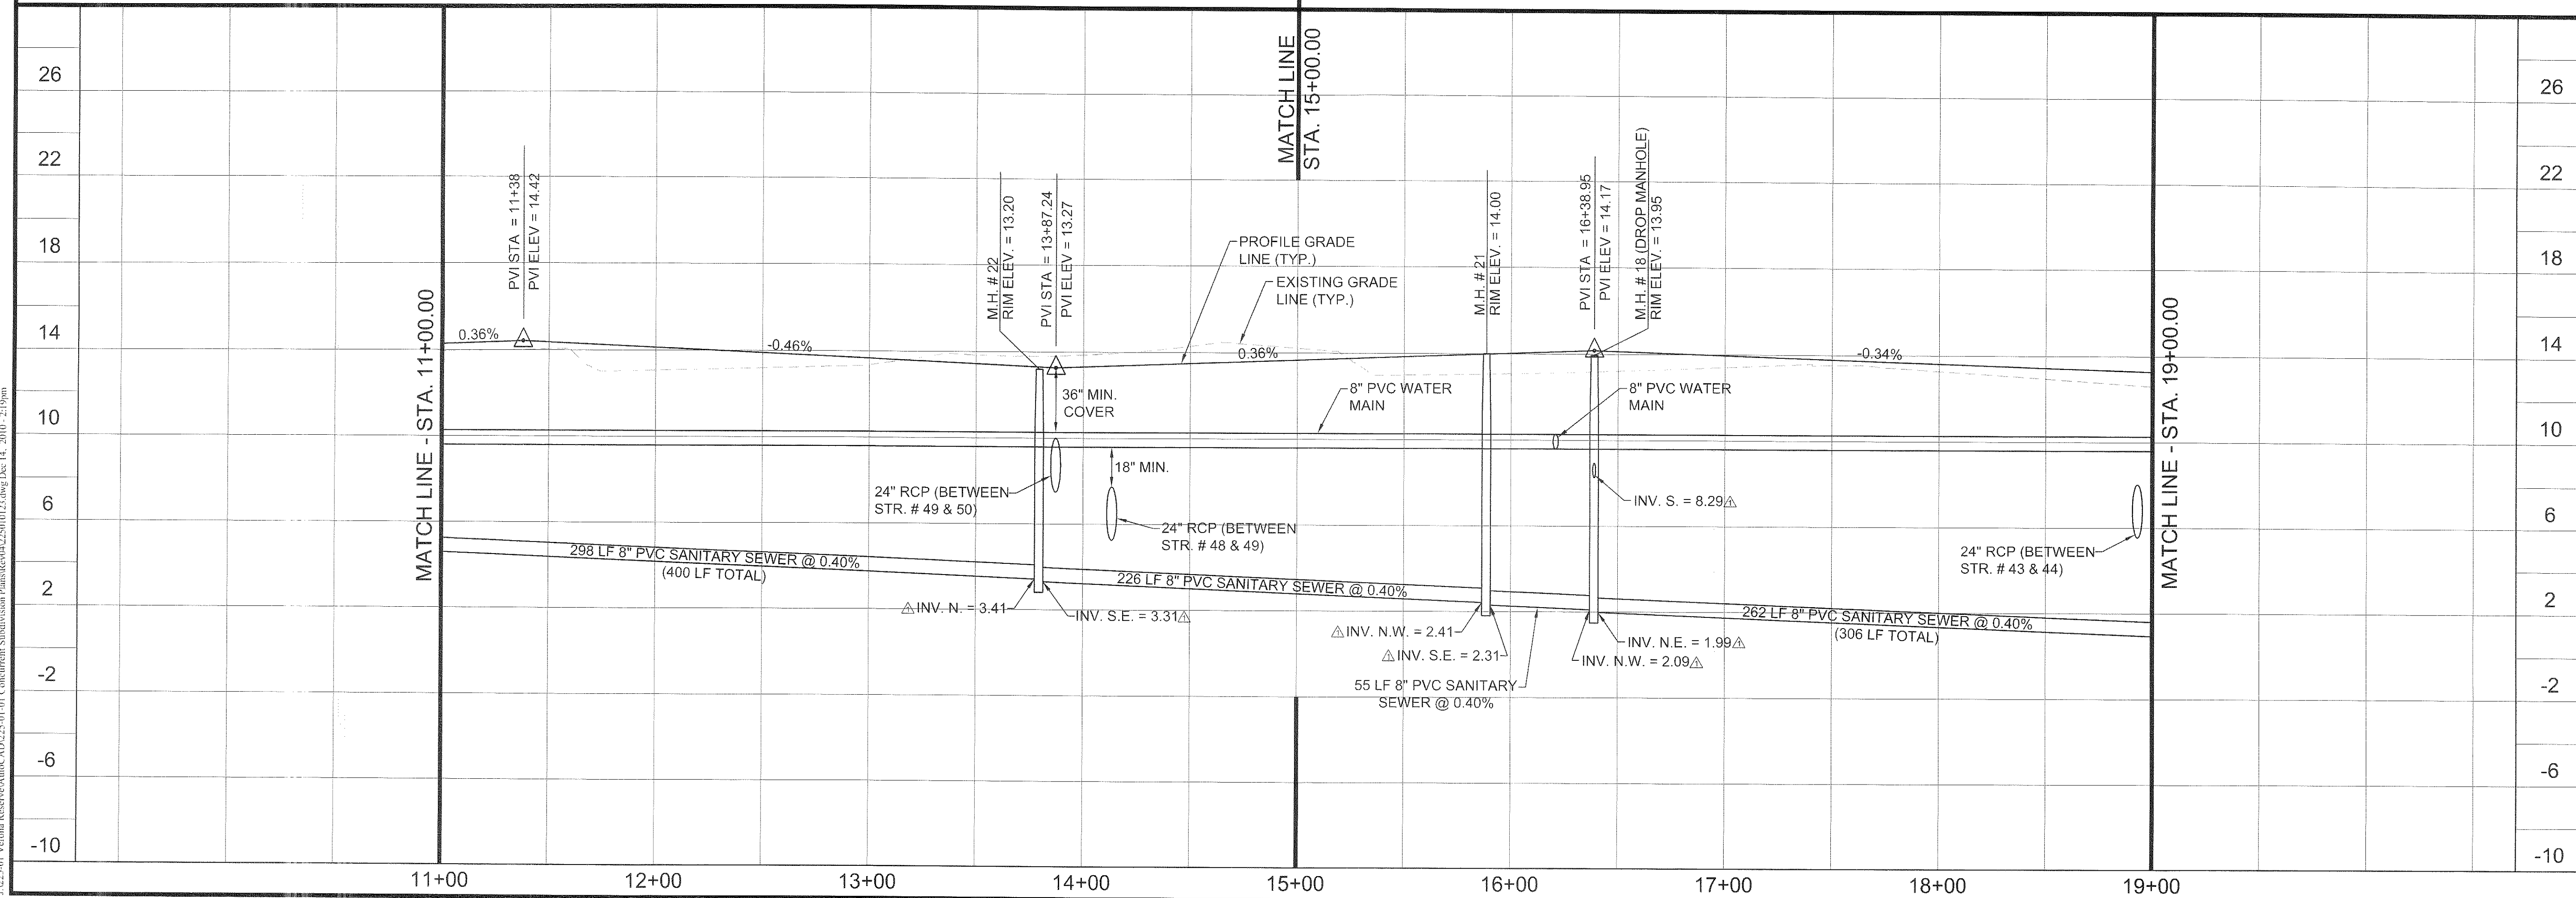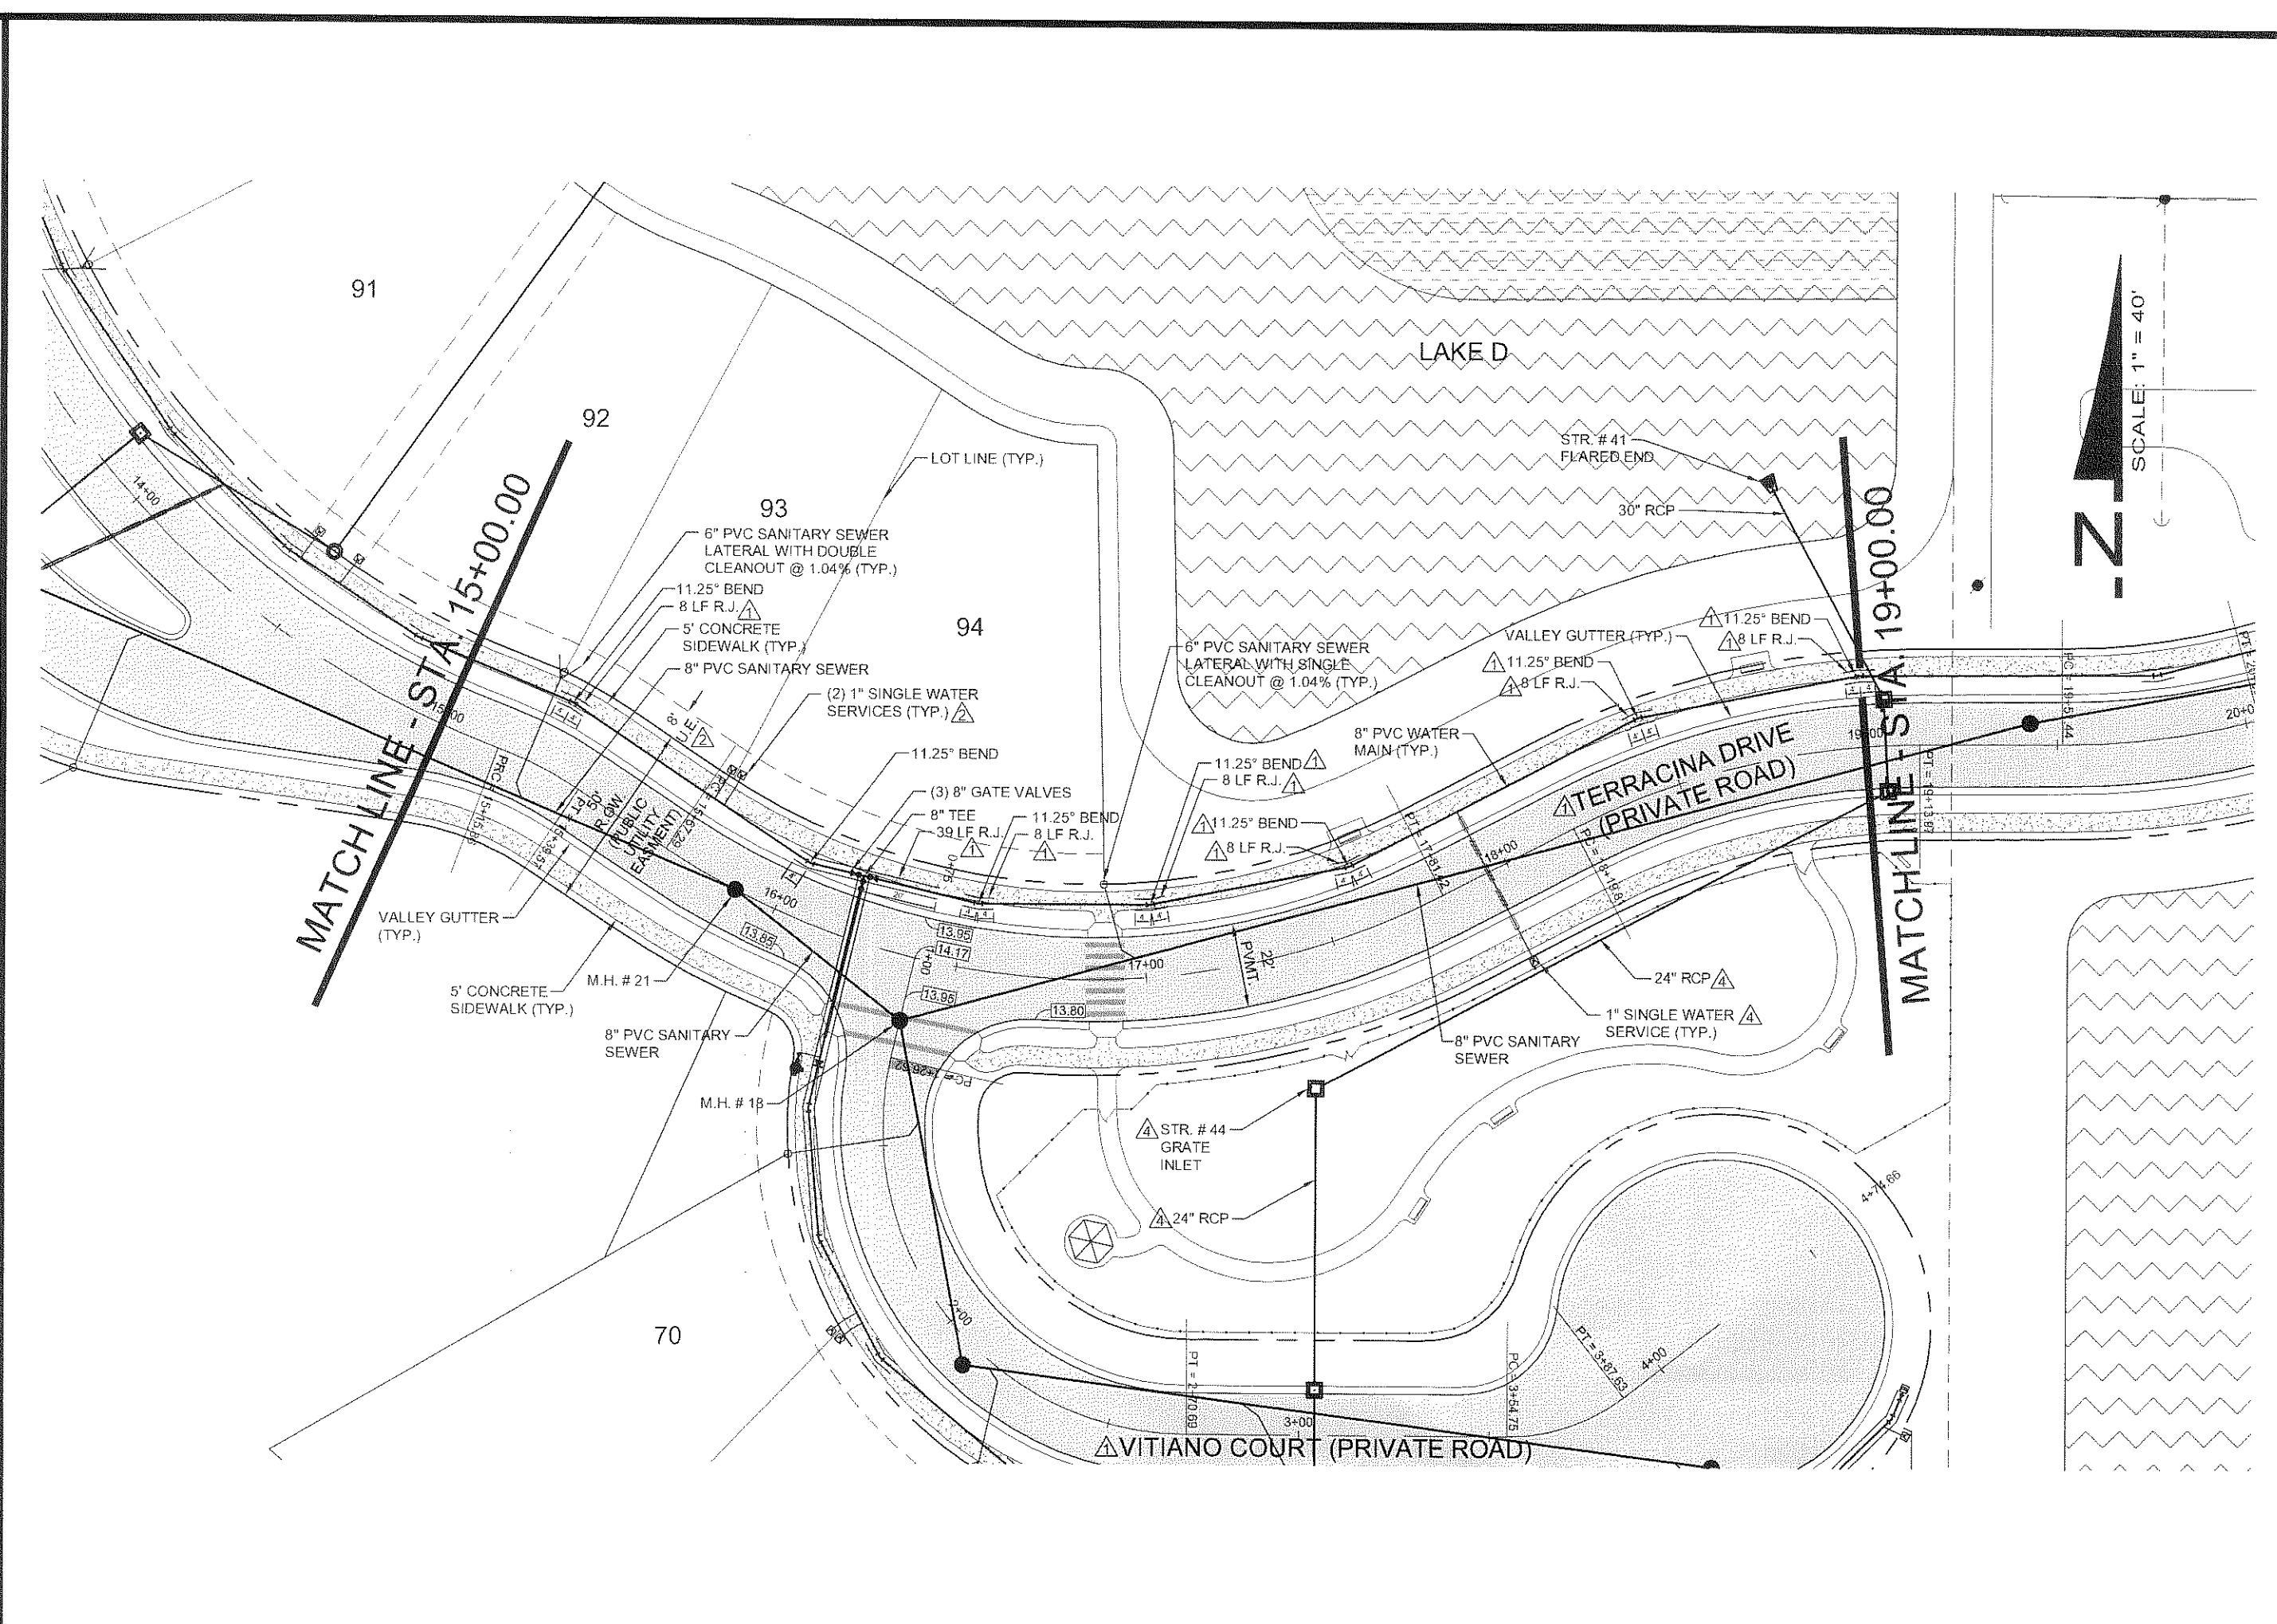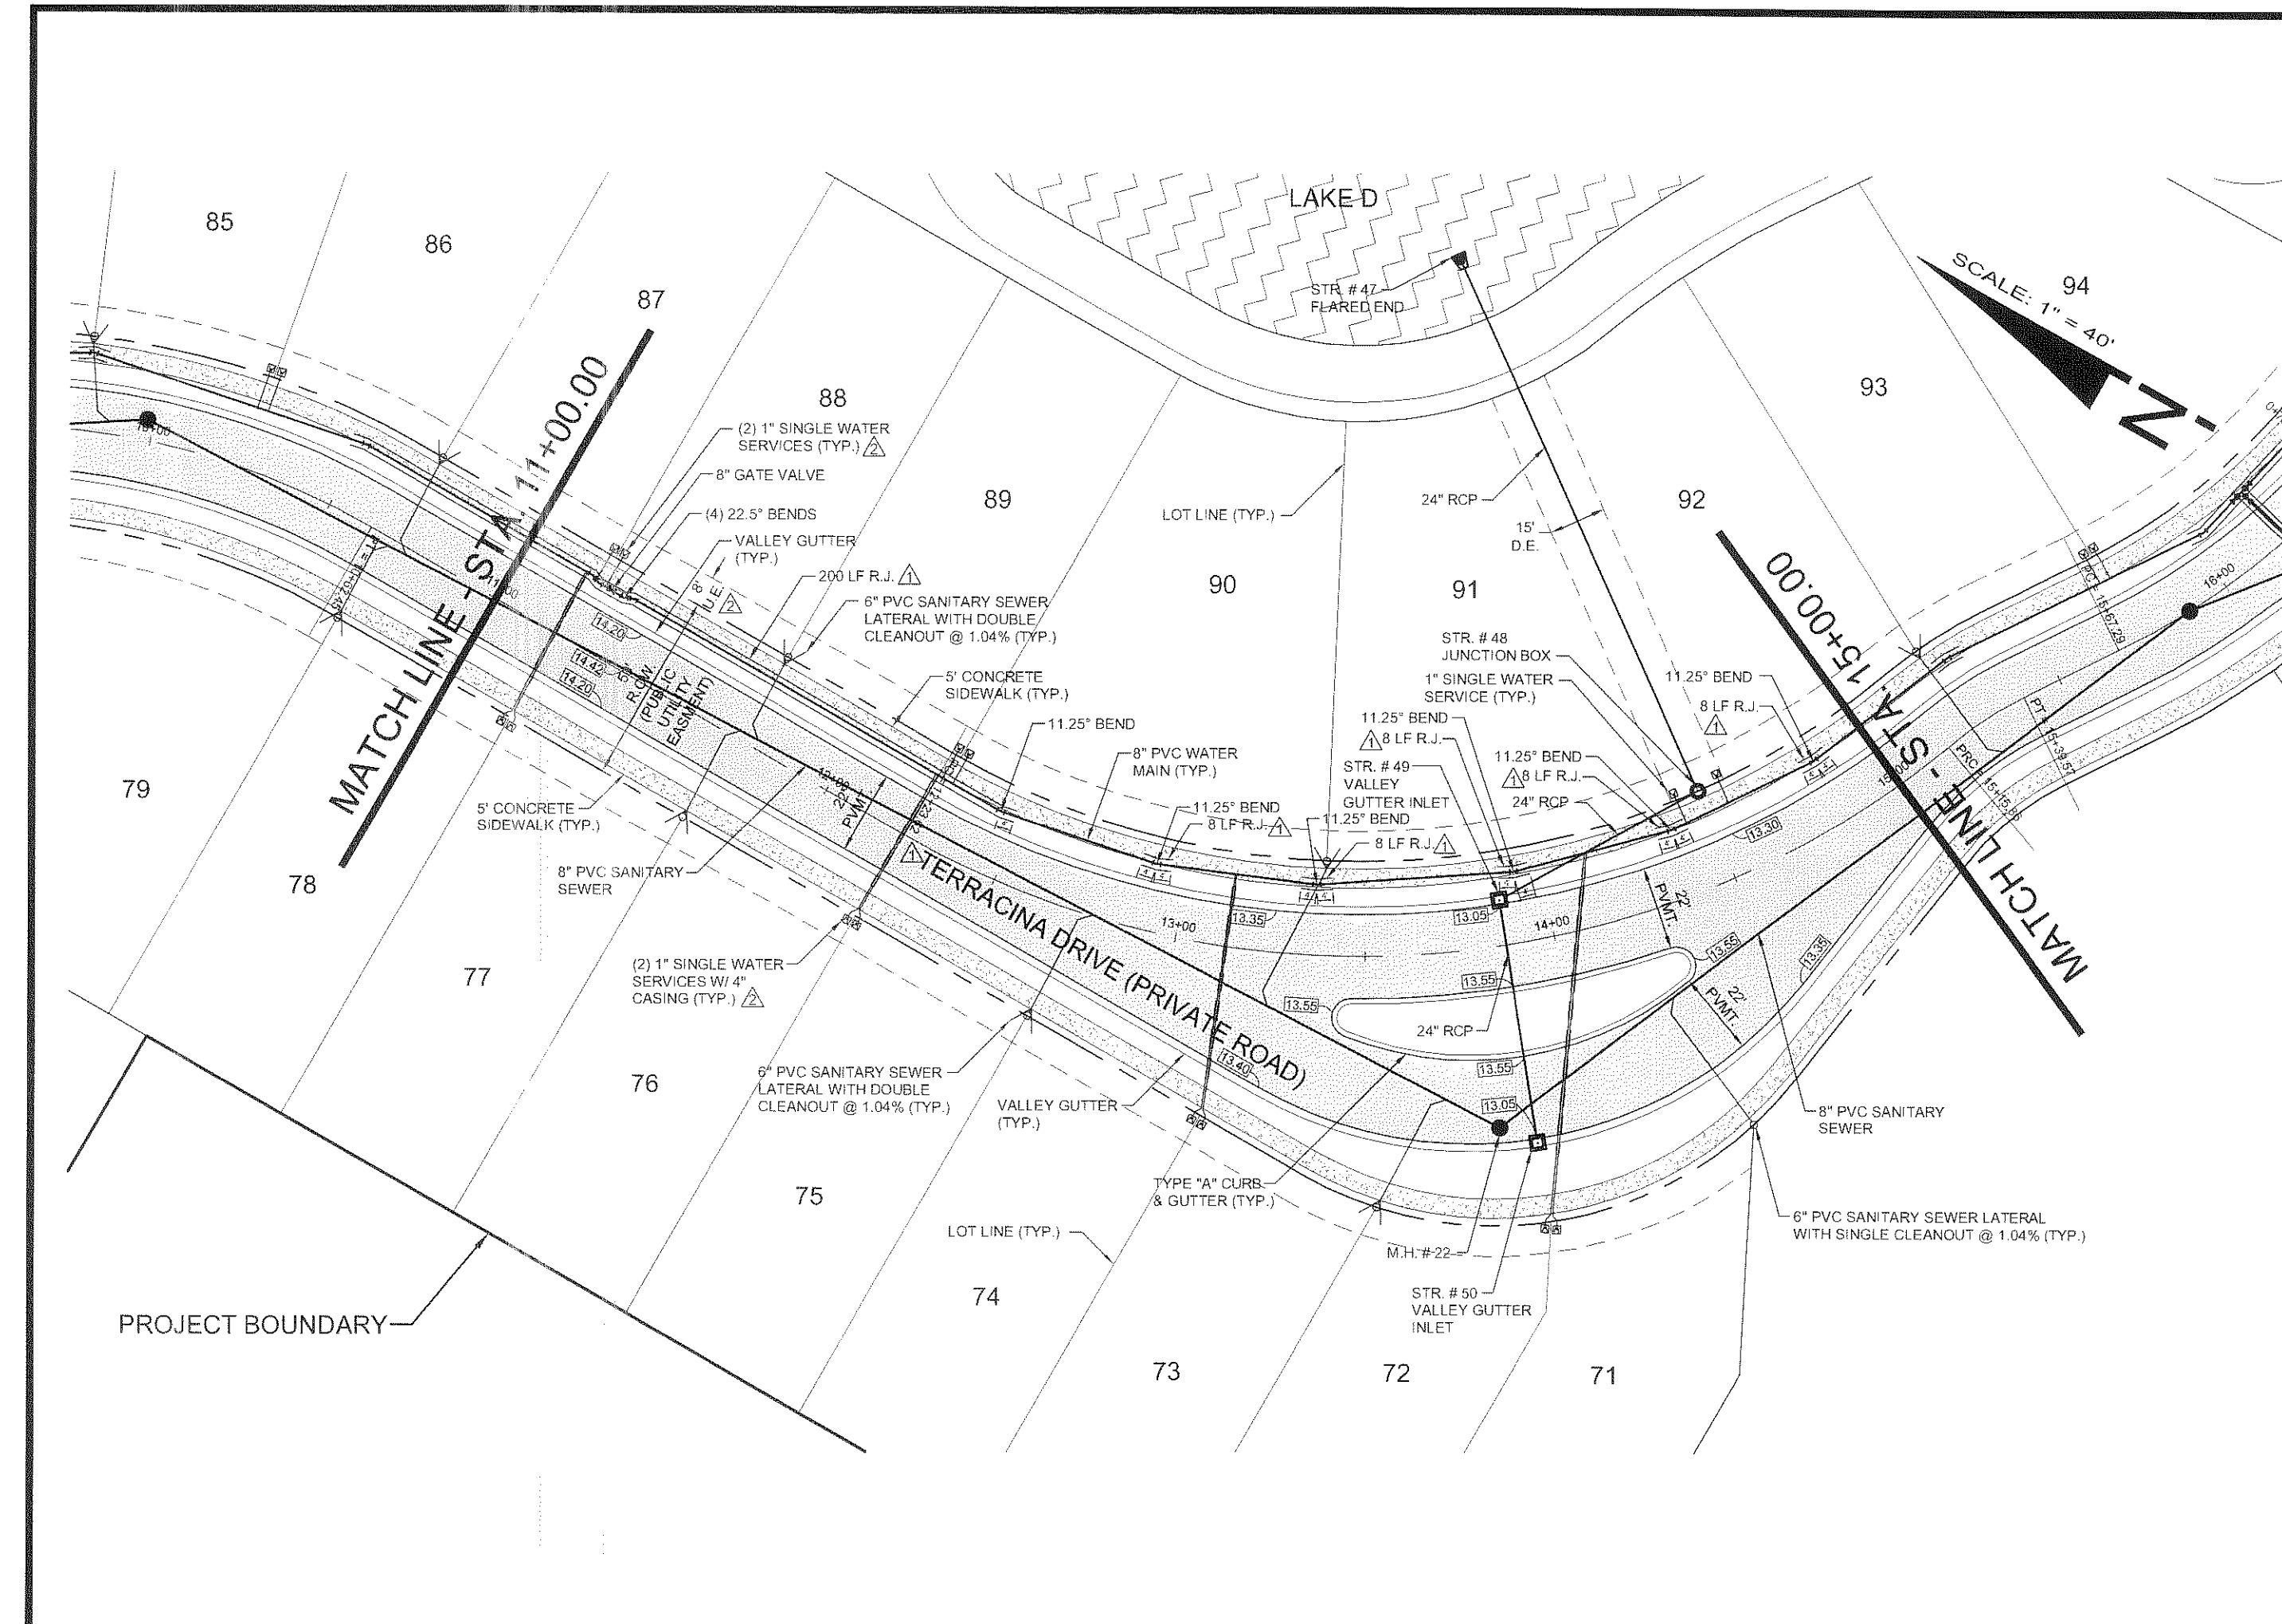

**WALDROP
ENGINEERING**

CIVIL ENGINEERING &
LAND DEVELOPMENT CONSULTANTS



28100 BONITA GRANDE DRIVE - SUITE 305 BONITA SPRINGS, FL 34735
P: 239-405-7777 F: 239-405-7999 EMAIL: info@walthropengineering.com

VERONA RESERVE

CLIENT: TAYLOR MORRISON OF FLORIDA, INC.
PLAN AND PROFILE: TERRACINA DRIVE ▸
(STA. 11+00.00 TO STA. 19+00.00)

[illegible]

1/23/25-01 Verona Reserve.dwg CAD:225-01-01 Content Subdivision Plans/Rev/01/25.dwg Dec 14, 2016 - 2:29pm

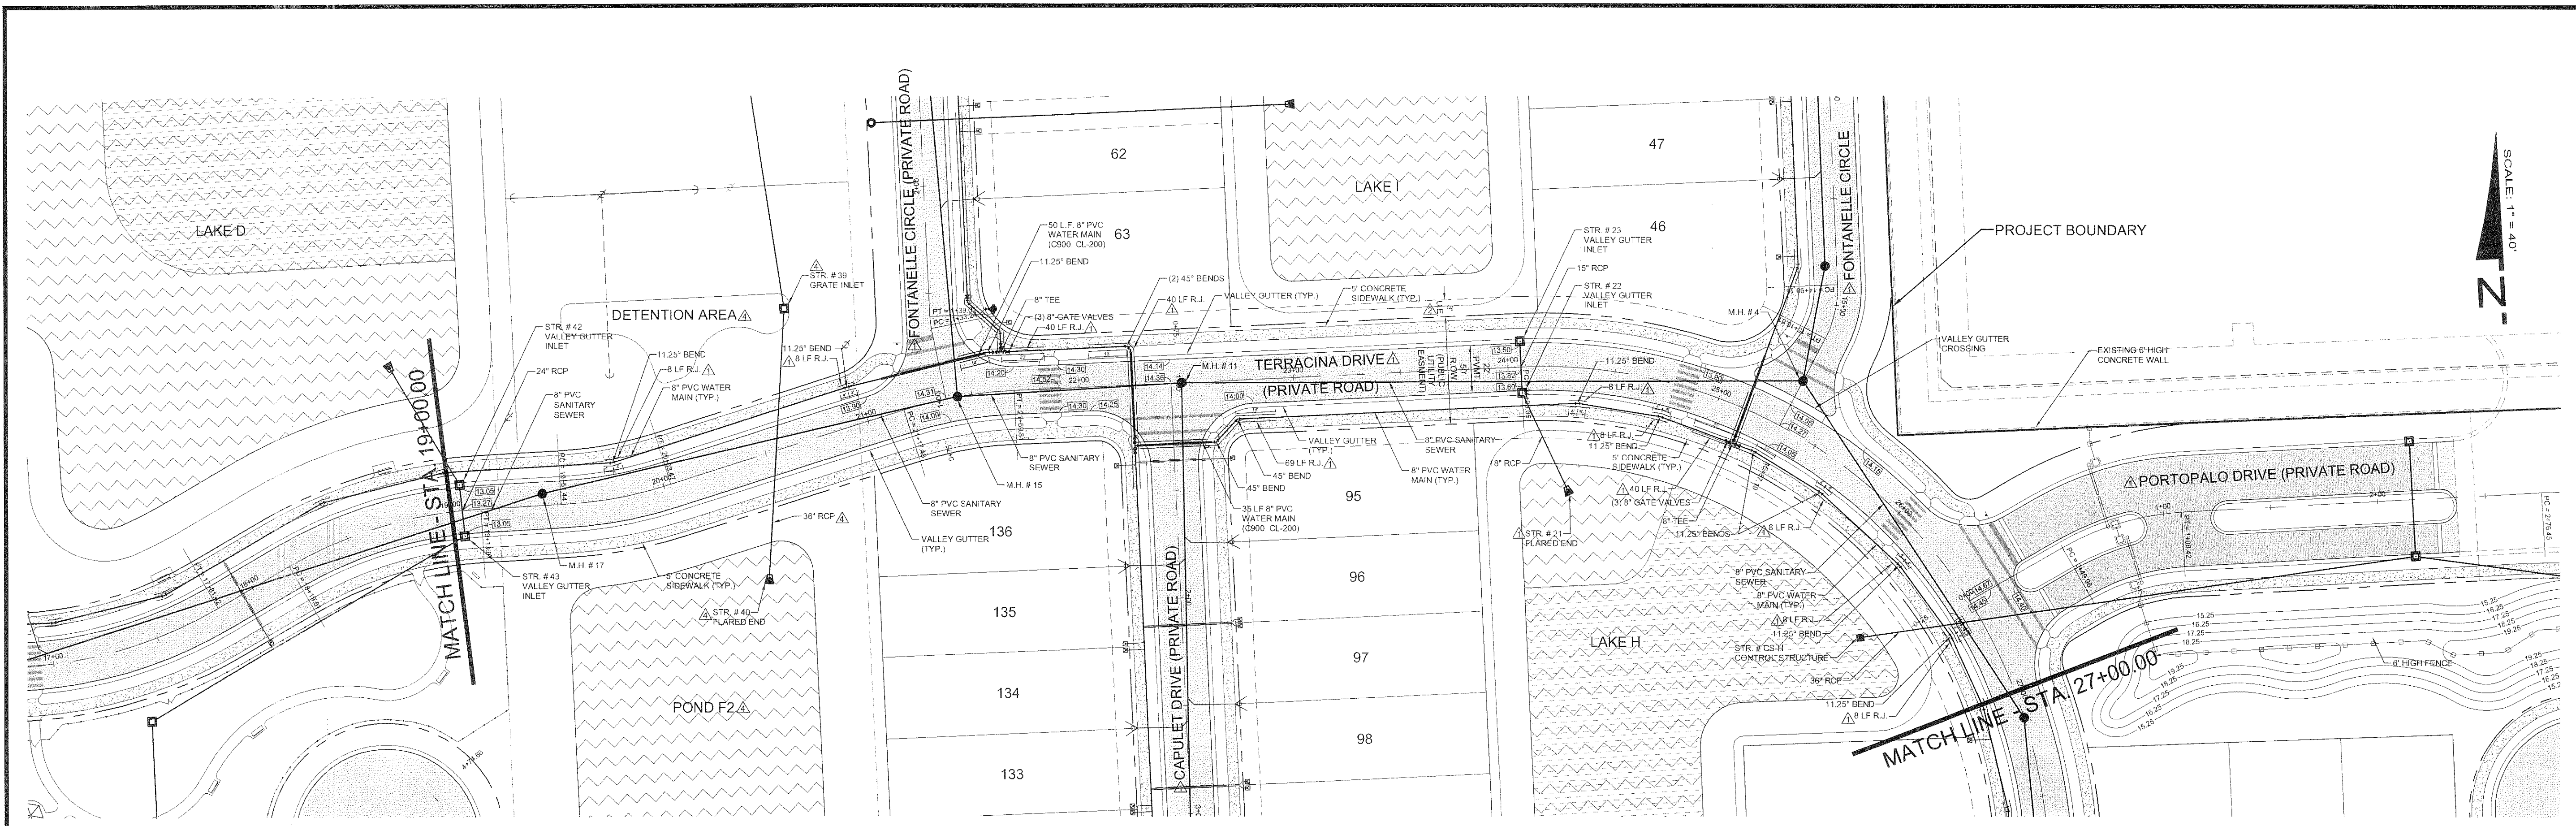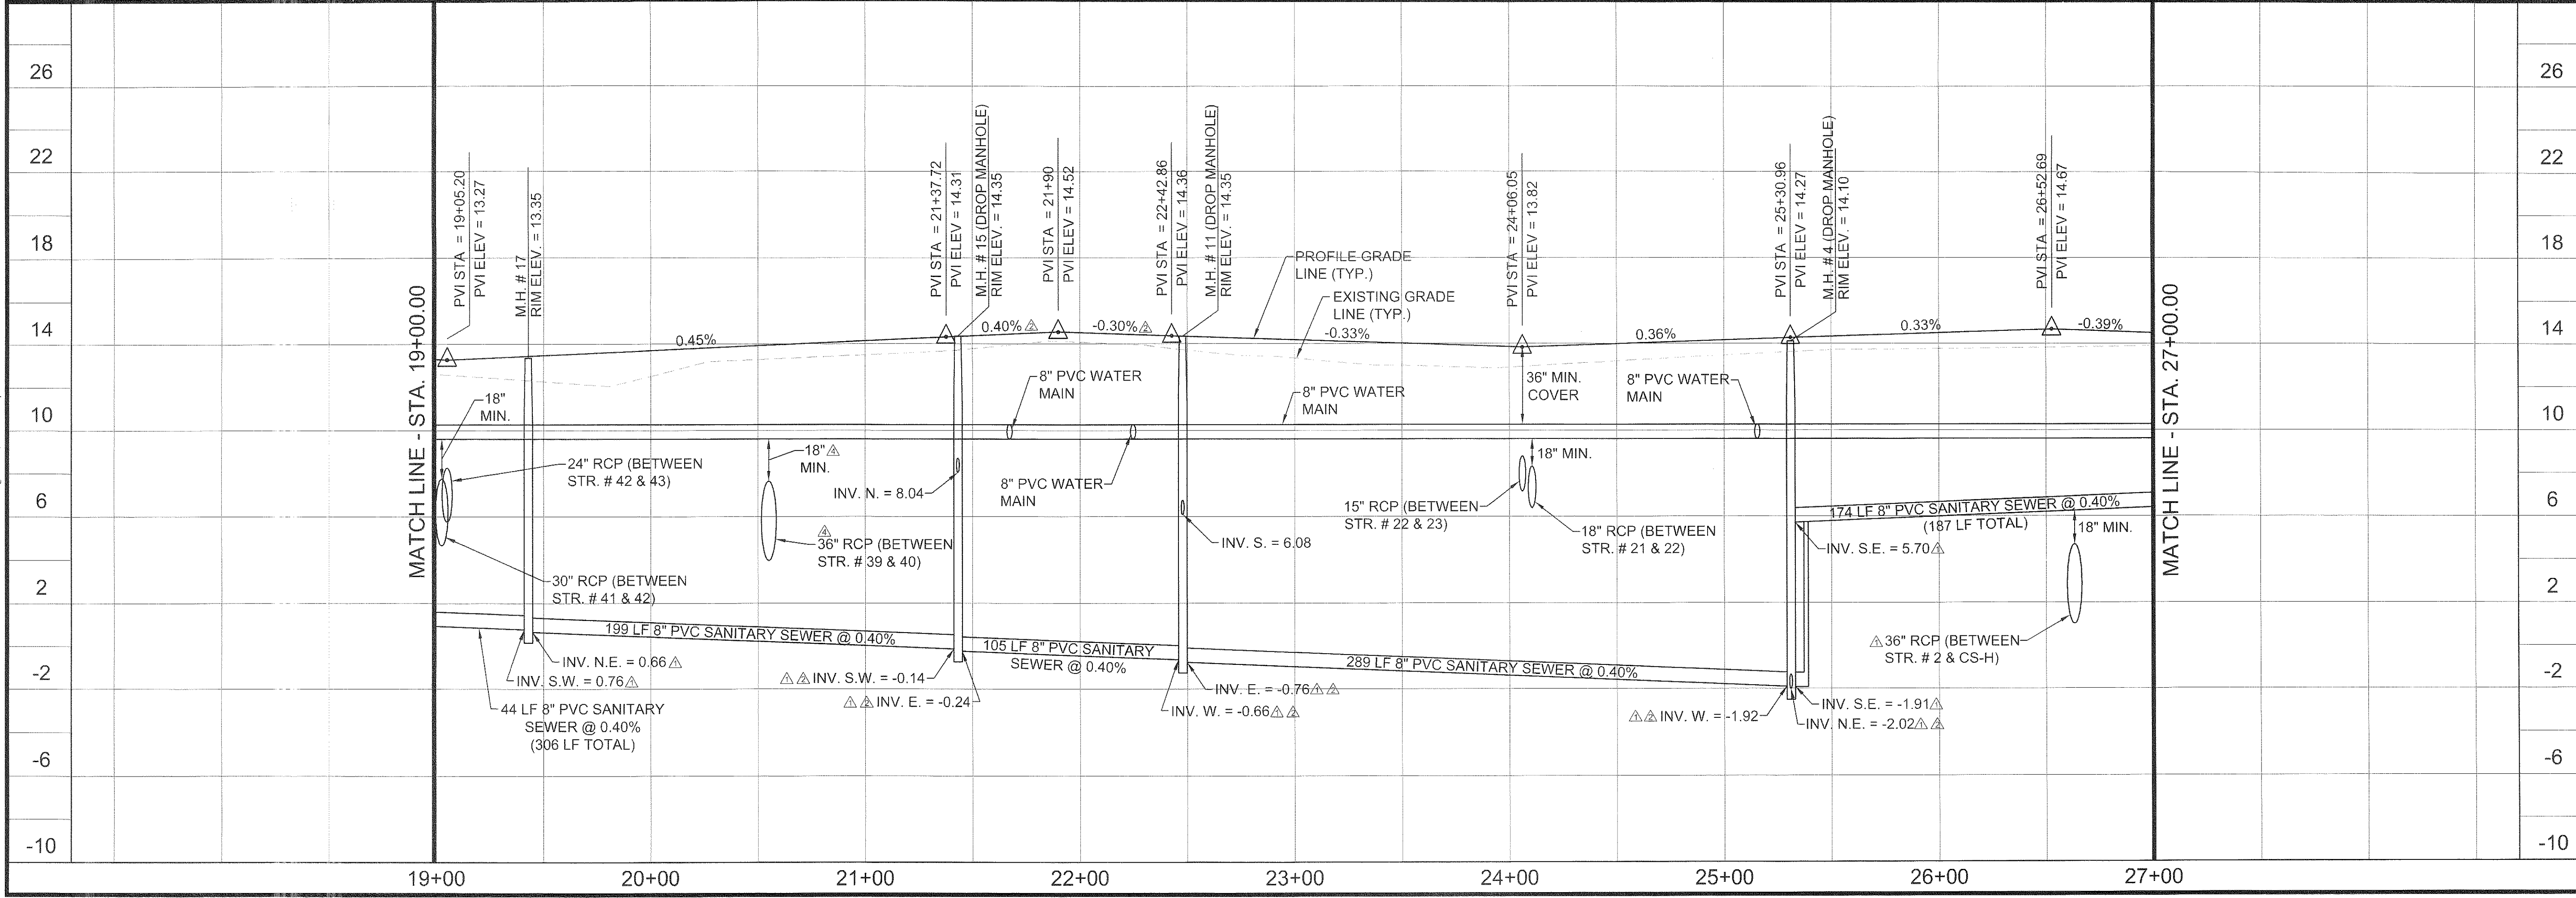

WALDROP
ENGINEERING

CIVIL ENGINEERING &
LAND DEVELOPMENT CONSULTANTS
25100 BONTA GRANDE DRIVE - SUITE 305 BONTA SPRINGS, FL 34135
P: 239-405-7777 F: 239-405-7599 EMAIL: info@waldropengineering.com

VERONA RESERVE

CLIENT: TAYLOR MORRISON OF FLORIDA, INC.
PLAN AND PROFILE: TERRACINA DRIVE
(STA. 19+00.00 TO STA. 27+00.00)



PLAN REVISIONS	
NO.	DESCRIPTION
1	07/24/10 REVISED PER SARASOTA COUNTY COMMENTS
2	08/14/10 REVISED PER SARASOTA COUNTY COMMENTS
3	09/04/10 REVISED PER SARASOTA COUNTY UTILITY COMMENTS
4	12/14/10 REVISED PER CLIENT COMMENTS

FLORIDA CERTIFICATE OF AUTHORIZATION 06066

NICHOLAS B. SPEACHT, P.E.
PL. CERTIFICATE NO. 7007

SET NUMBER: 225-01-01
SHEET: 24

J:\225-01 Verona Reserve\AutoCAD\225-01.dwg, Dec 14, 2010, 2:20pm

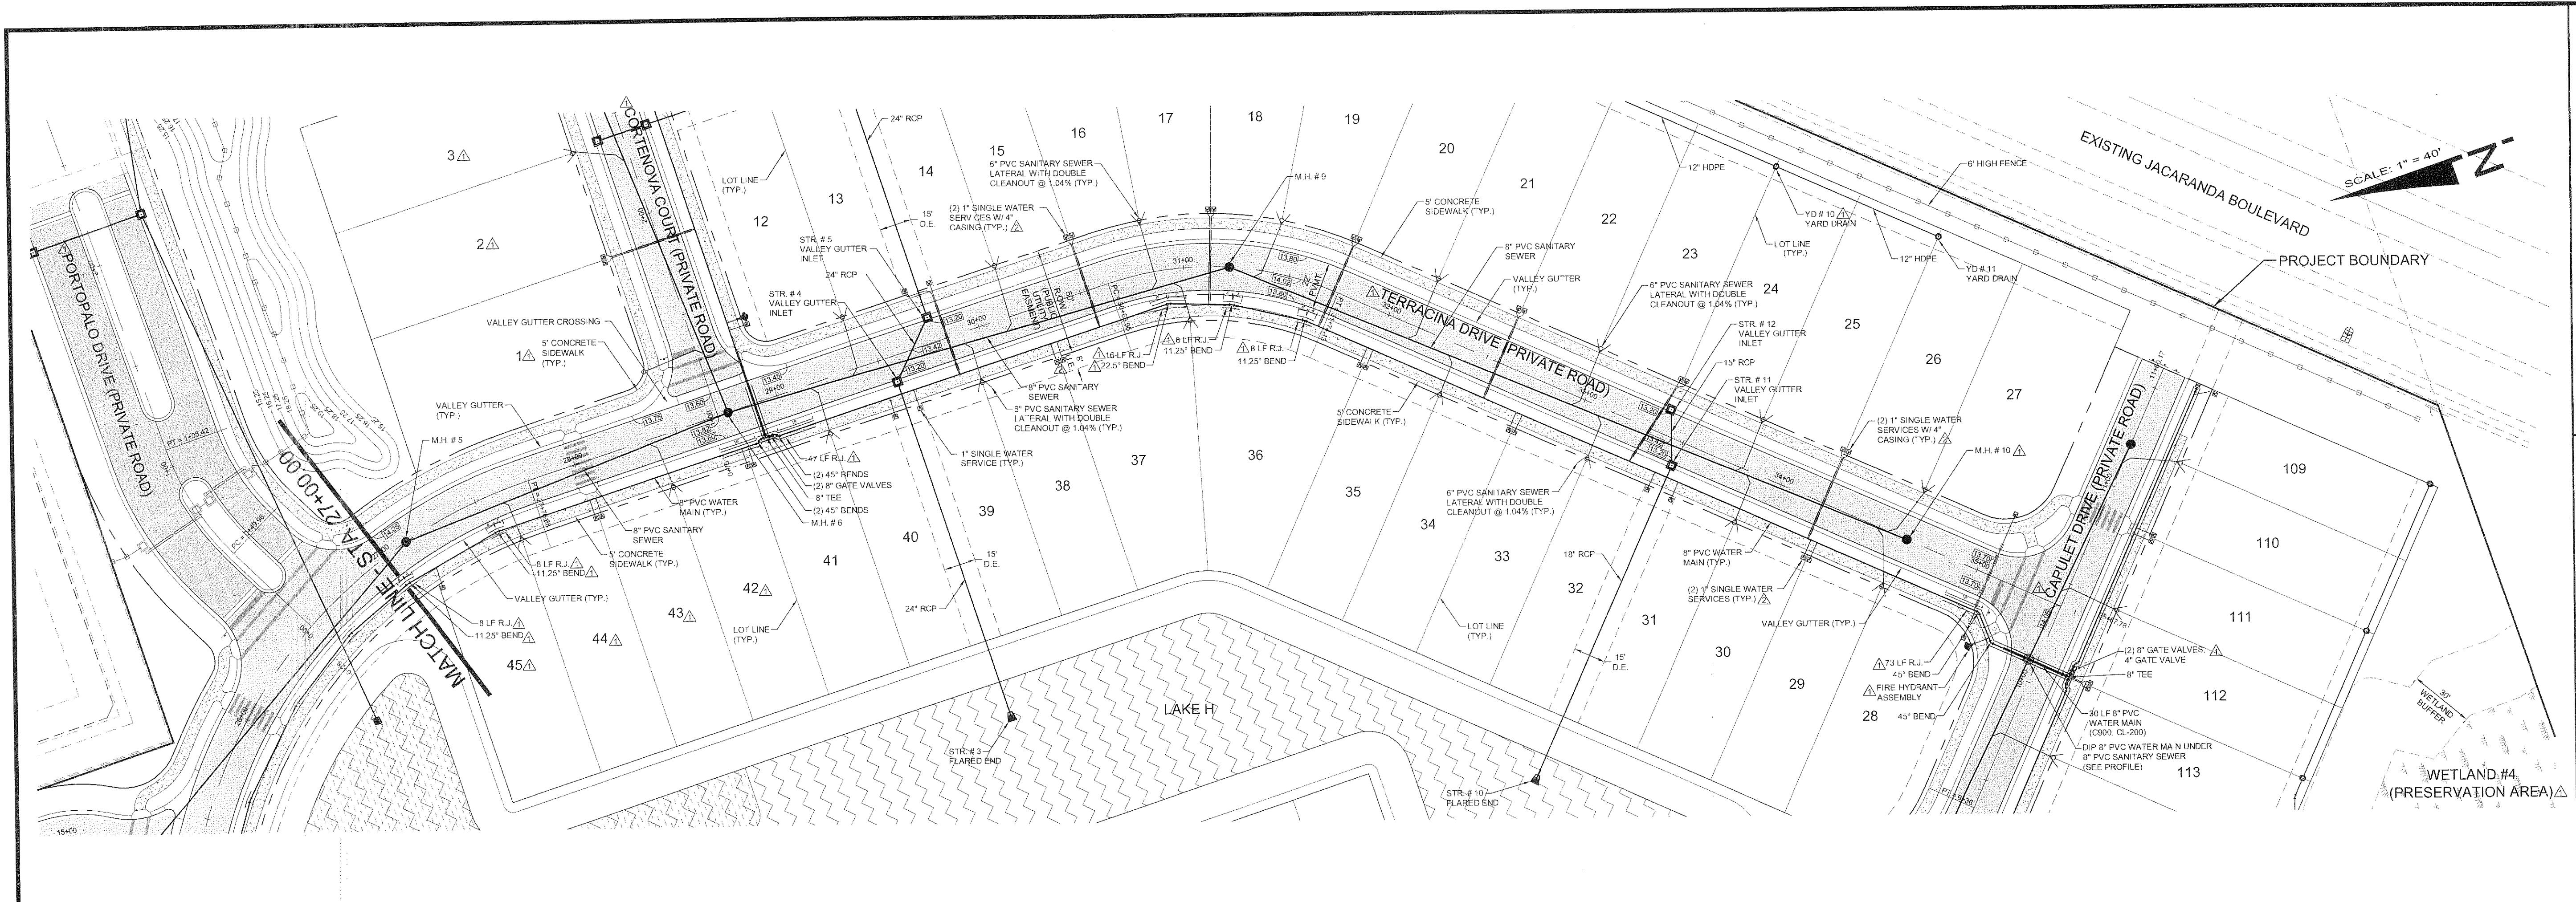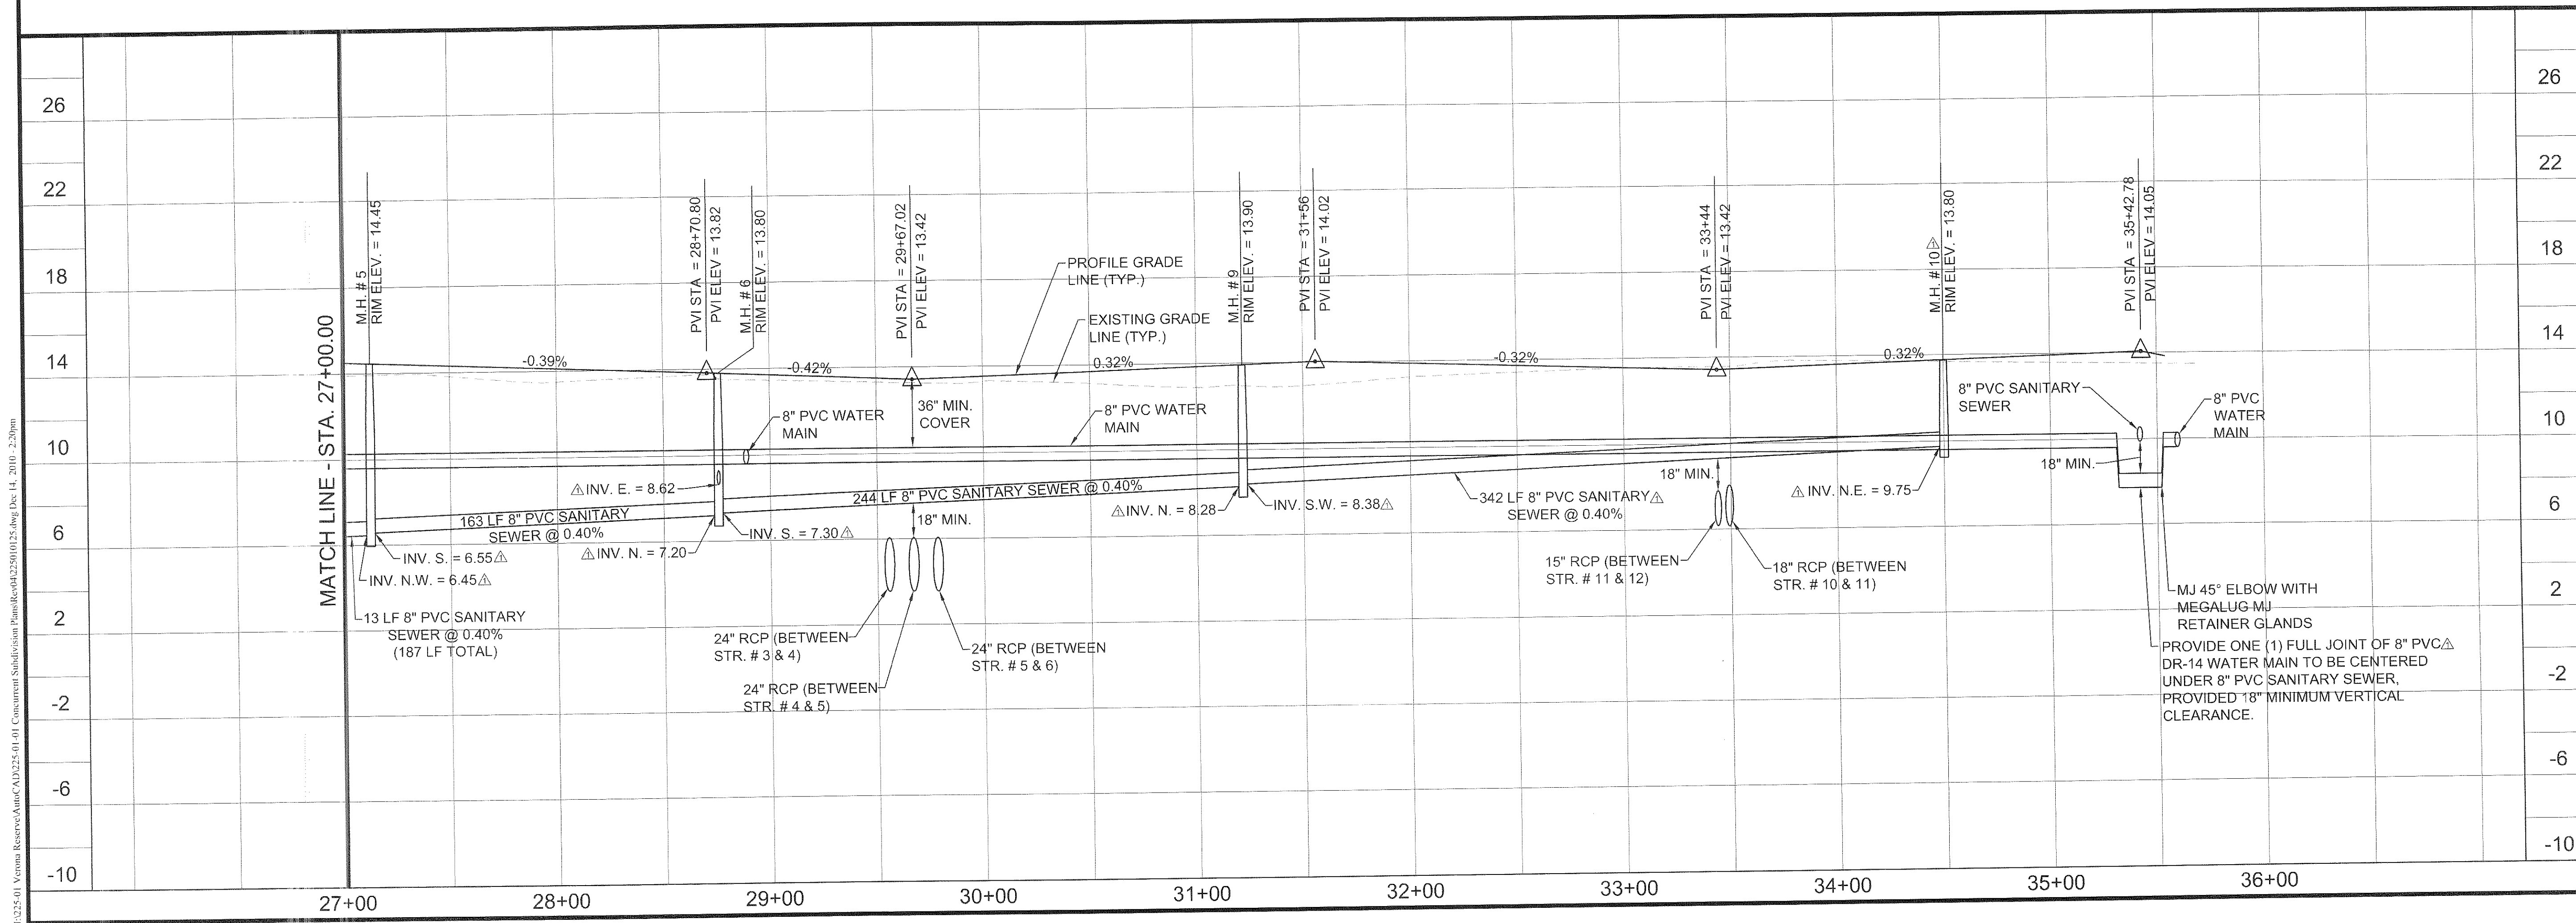

WALDROP
ENGINEERING





CIVIL ENGINEERING &
LAND DEVELOPMENT CONSULTANTS
28100 BONITA GRANDE DRIVE - SUITE 305 BONITA SPRINGS, FL 34135
P: 239-405-7777 F: 239-405-7899 EMAIL: info@waldropengineering.com

VERONA RESERVE
CLIENT: TAYLOR MORRISON OF FLORIDA, INC.
PLAN AND PROFILE: TERRACINA DRIVE
(STA. 27+00.00 TO END)

DATE	REVISIONS
02/20/10	REVISED PER SARASOTA COUNTY COMMENTS
04/14/10	REVISED PER SARASOTA COUNTY COMMENTS
04/16/10	REVISED PER SARASOTA COUNTY COMMENTS

FLORIDA CERTIFICATE OF AUTHORIZATION 03436
MICHAEL B. SPELACH, P.E.
No 70207
12/15/10
STATE OF FLORIDA
SET NUMBER: 225-01-01
SHEET: 25

J:\225-01 Verona Reserve\AutoCAD\225-01 Concurrent Subdivision Plans\225-01\225-01.dwg, Dec 14, 2010 - 2:29pm

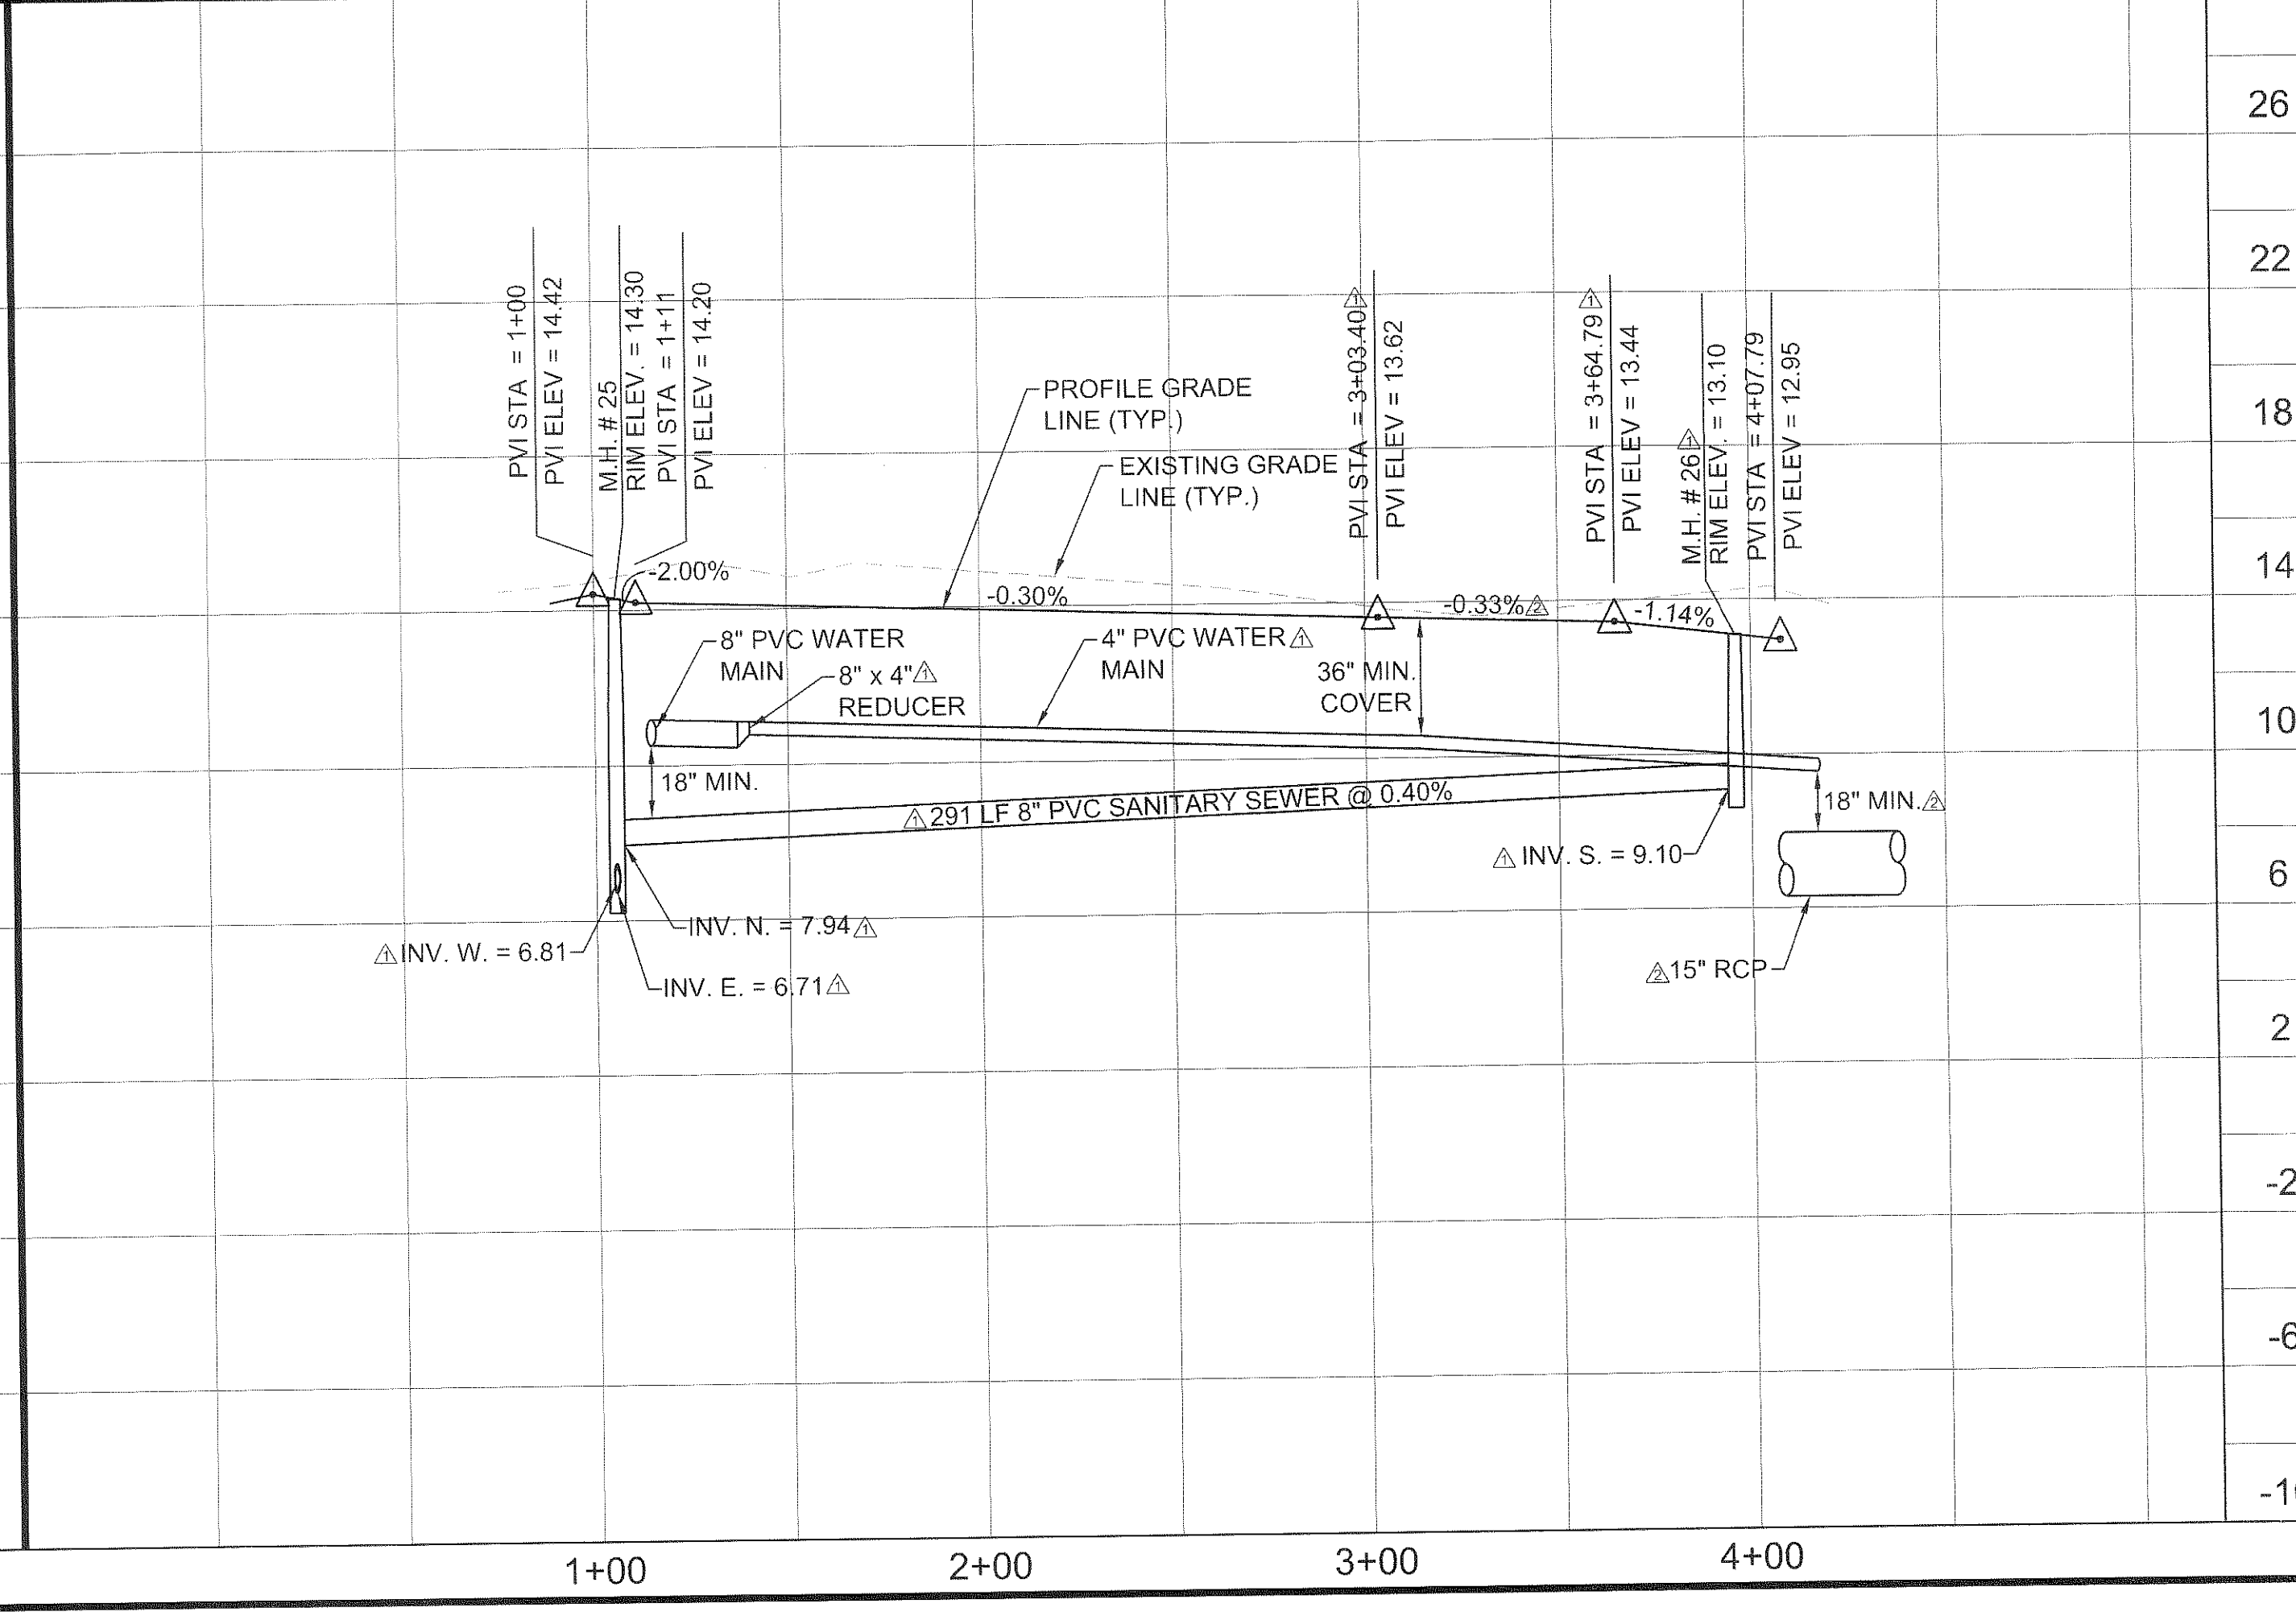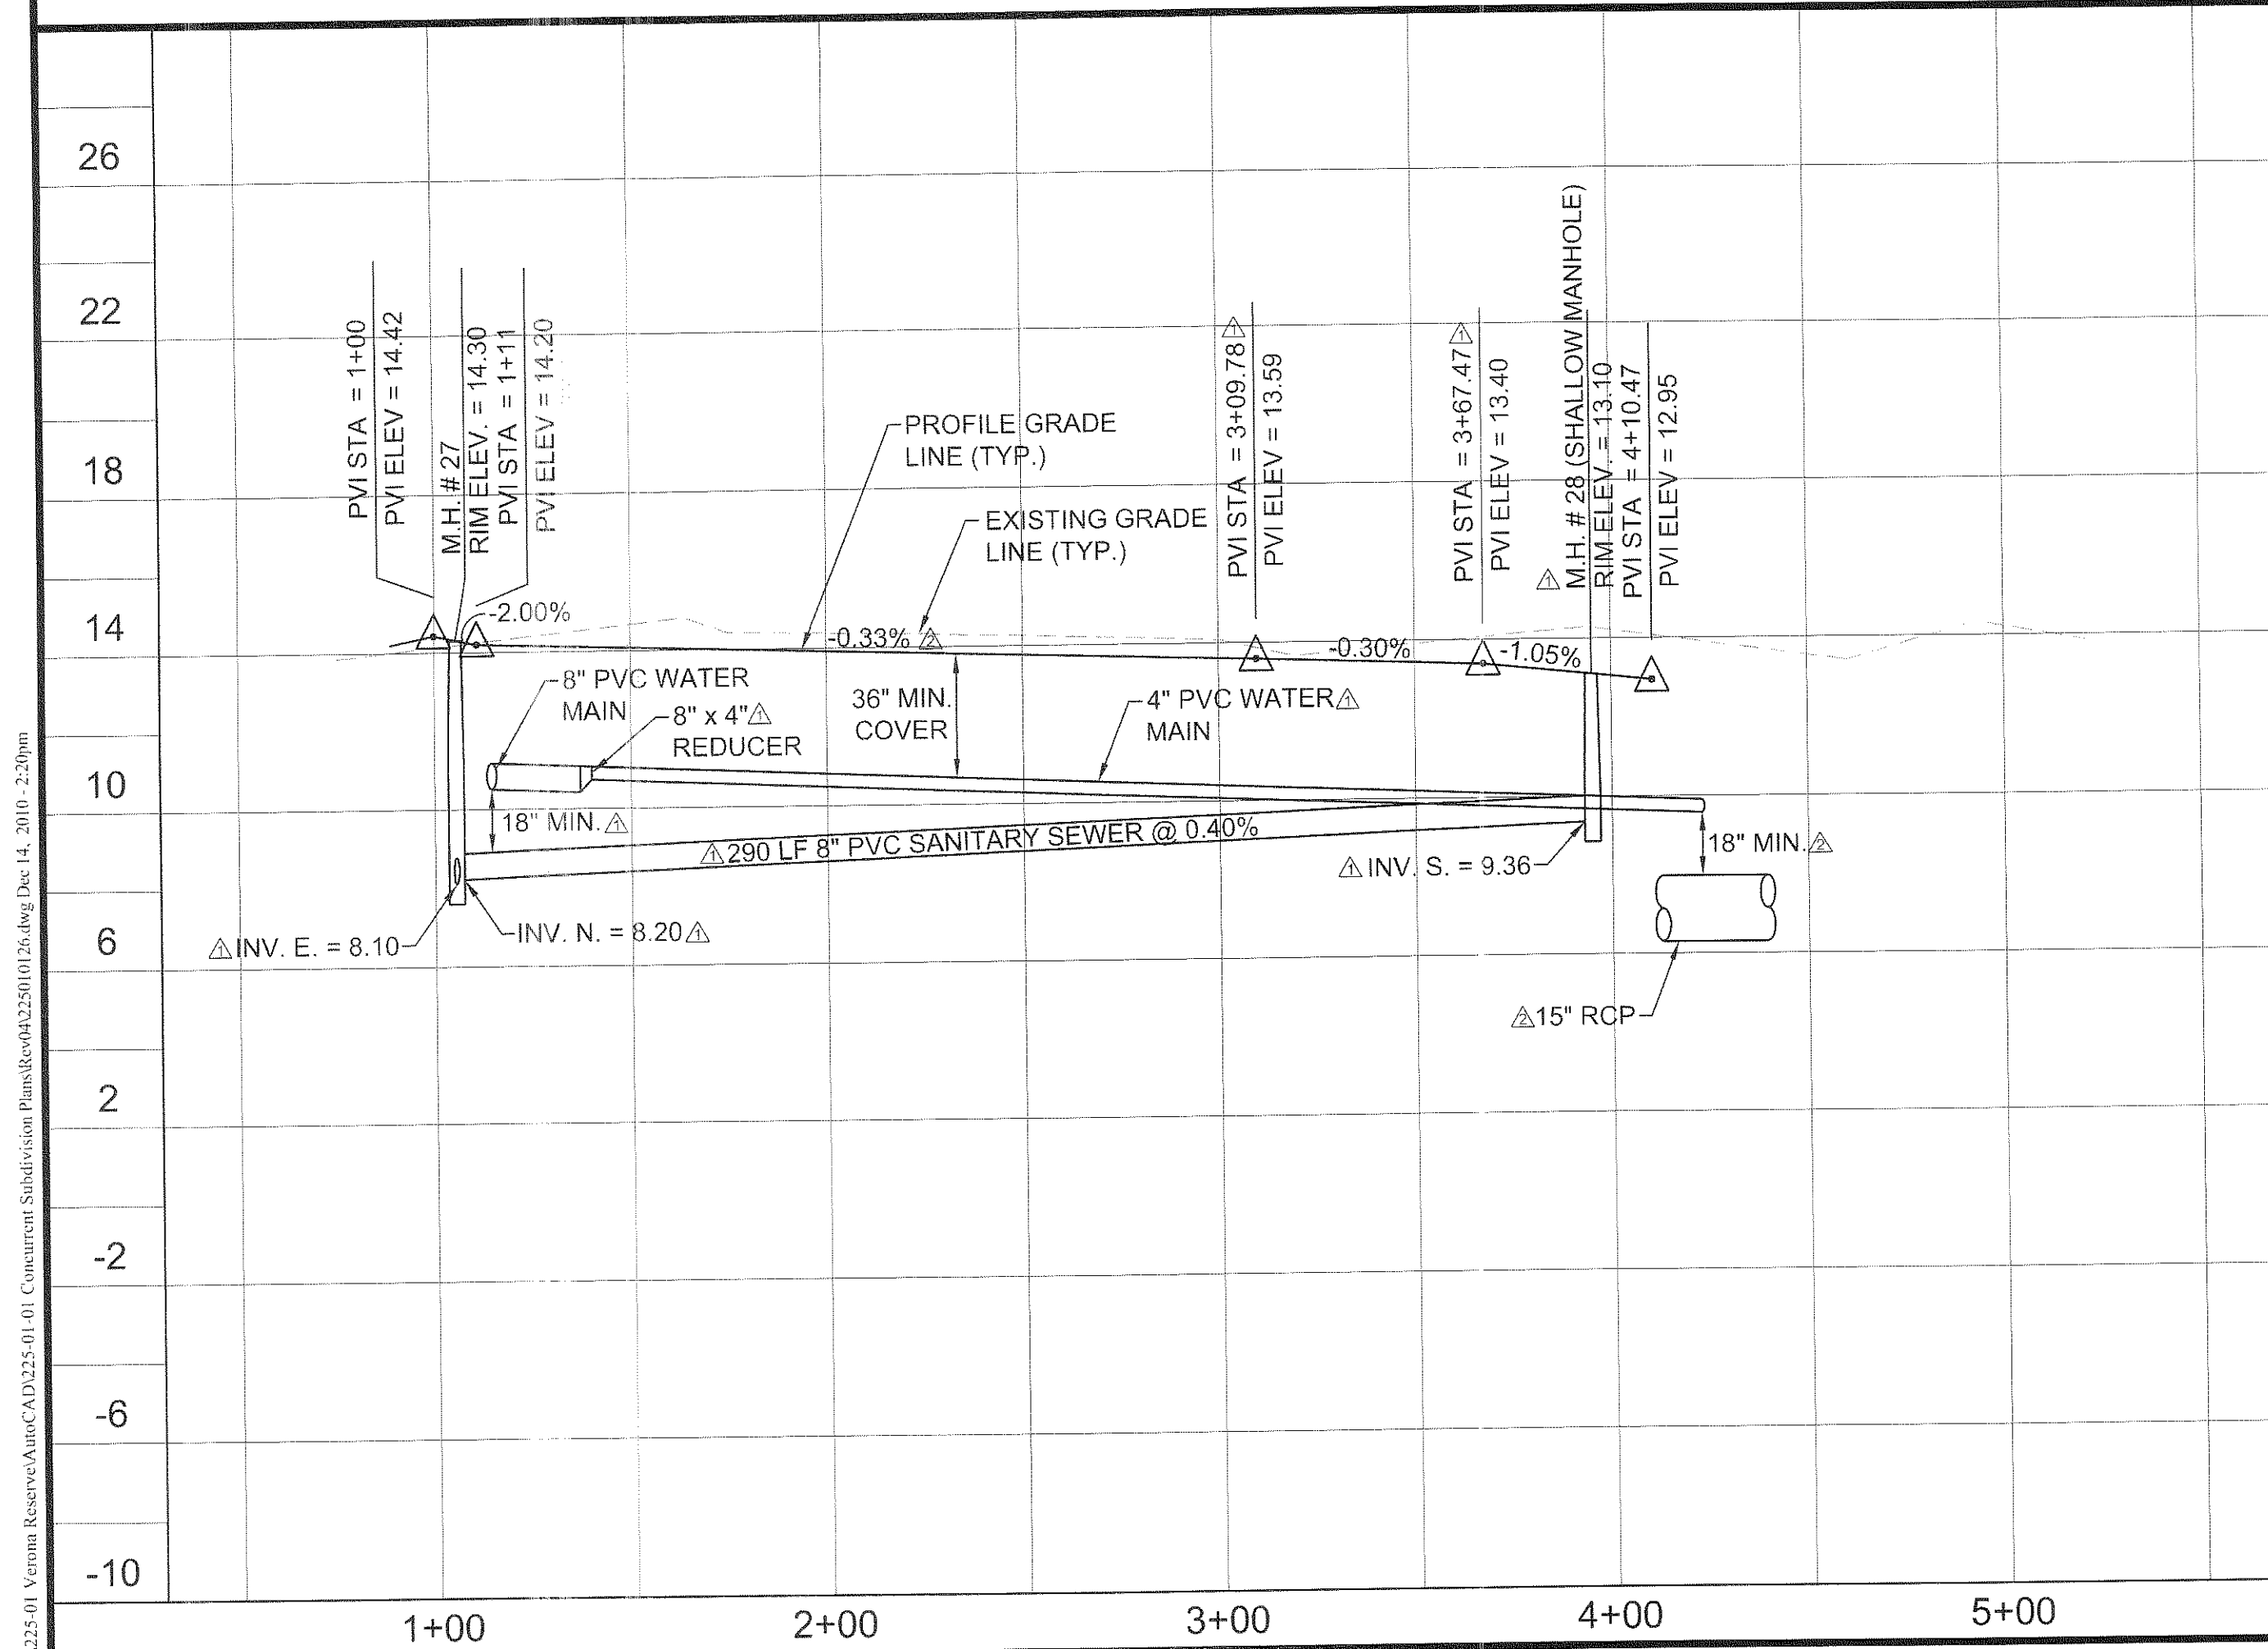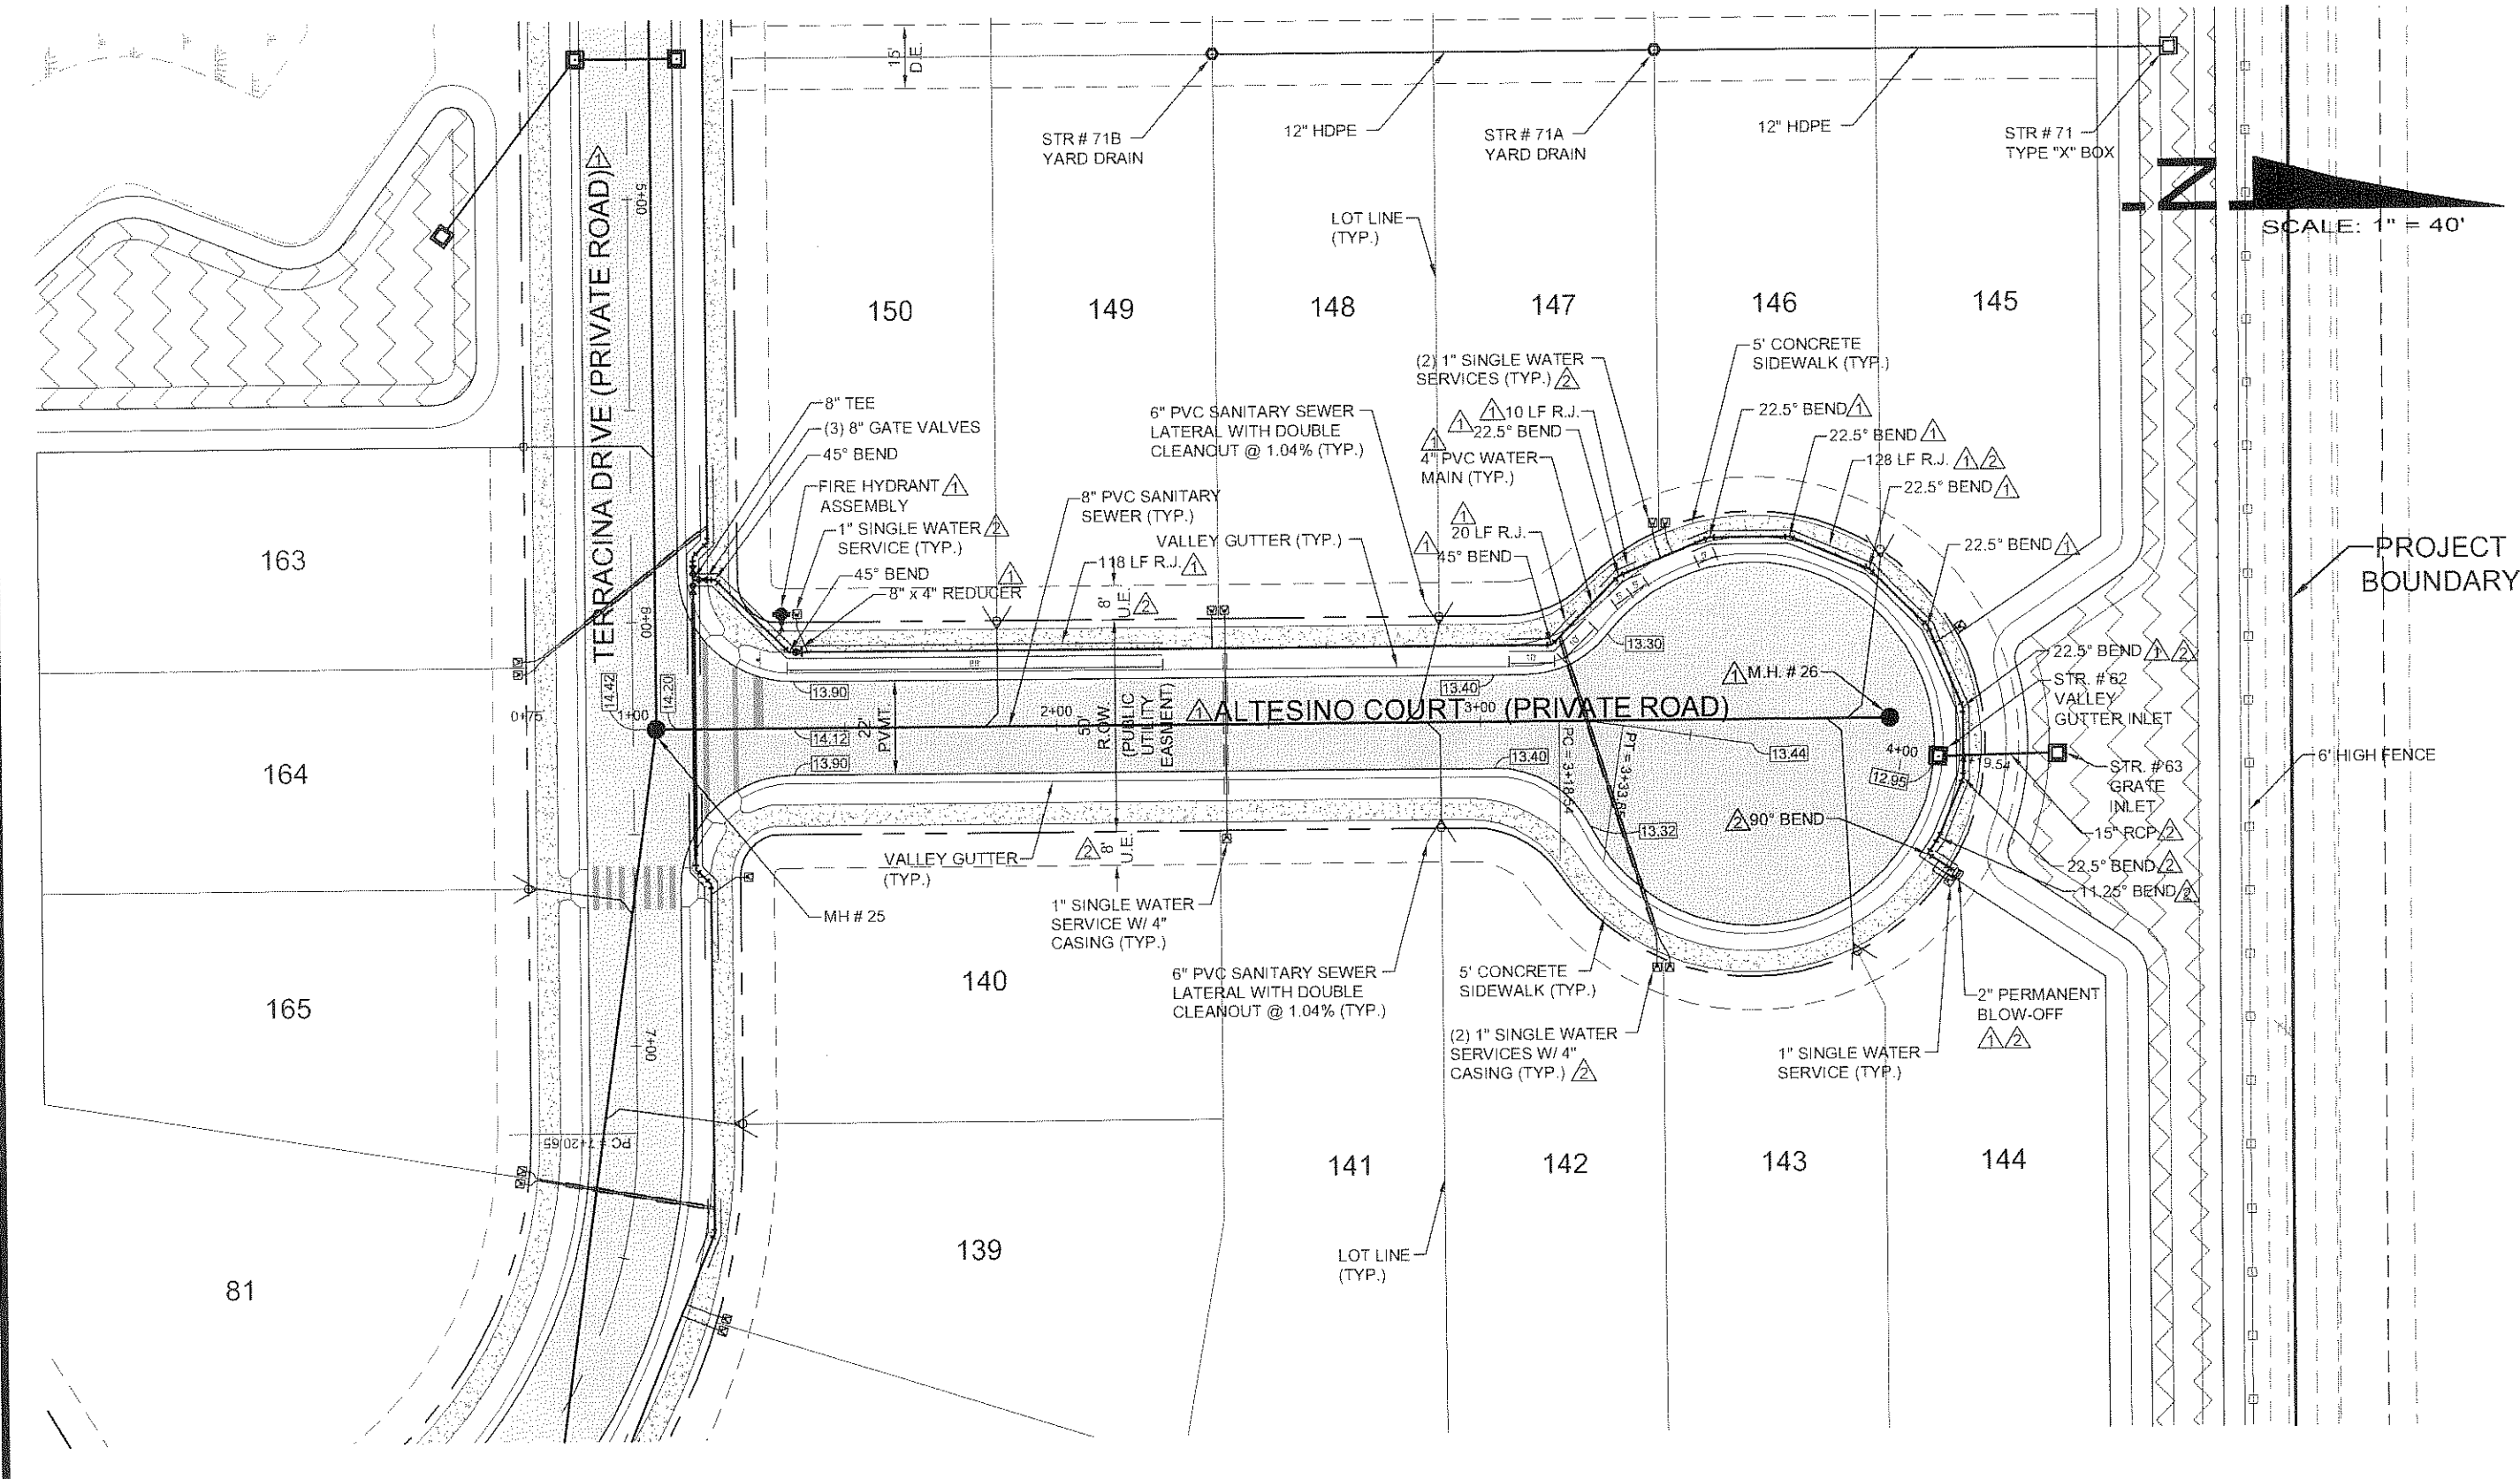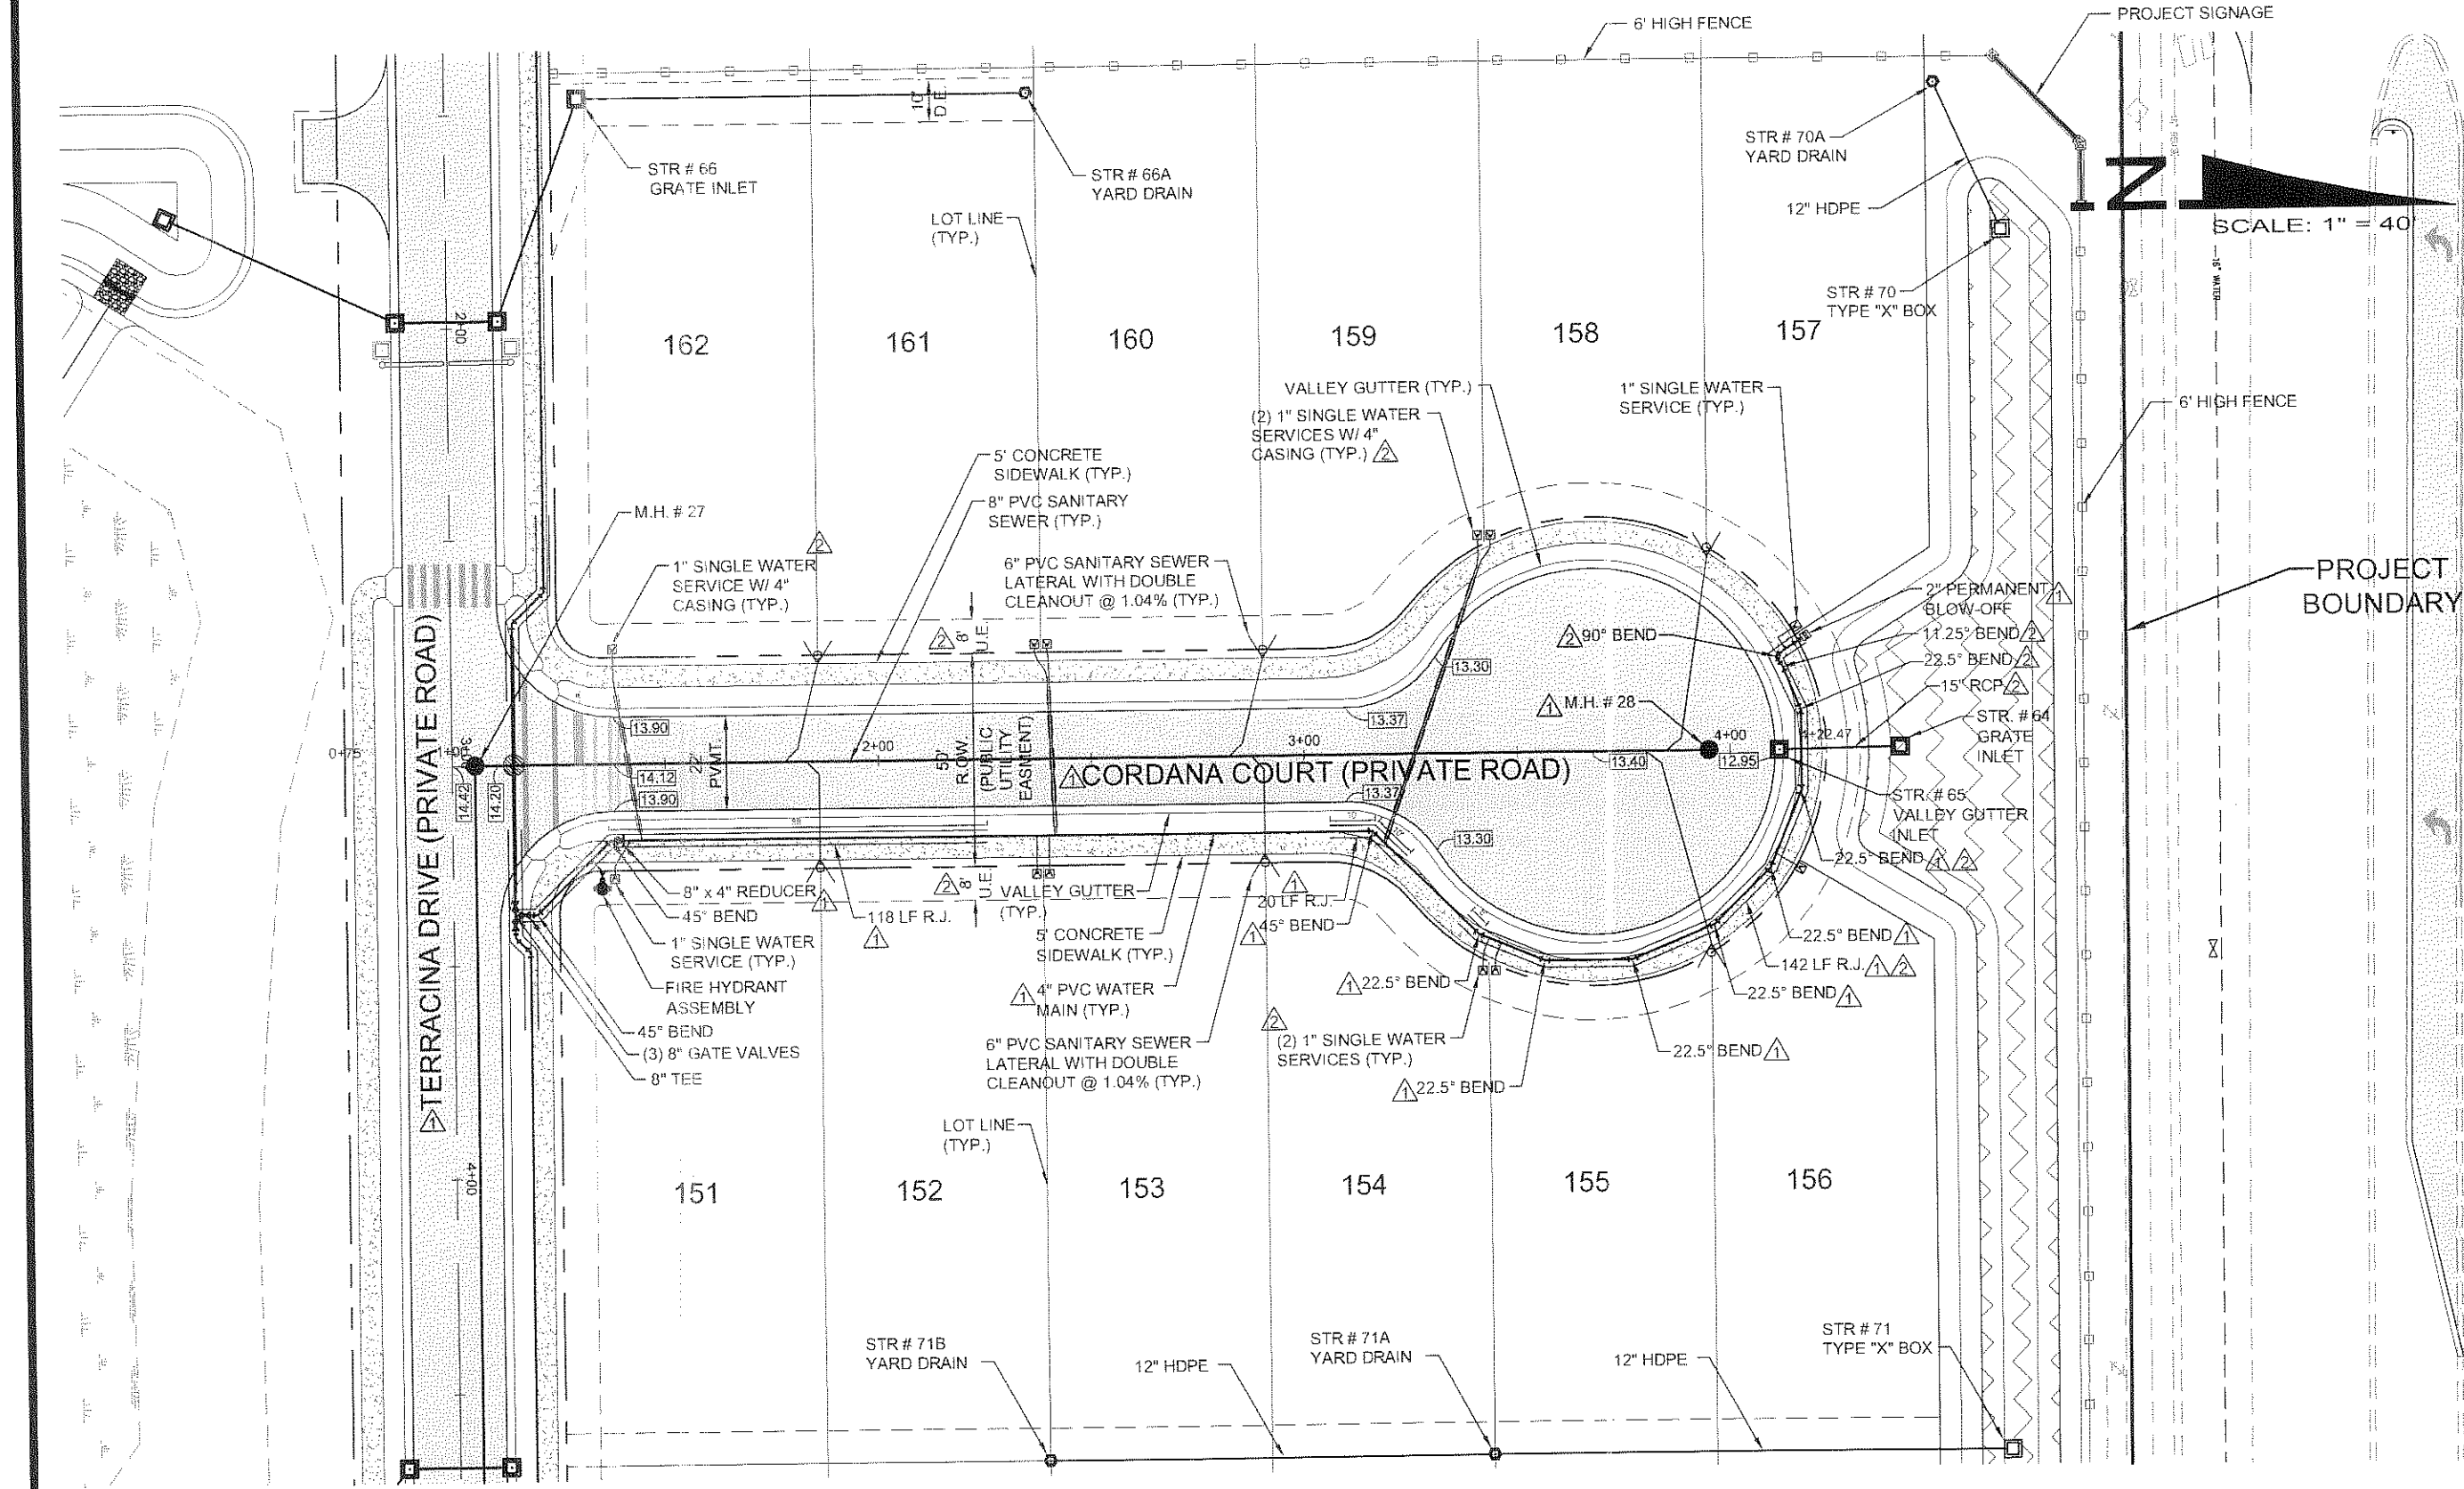

WALDROP
ENGINEERING

VERONA RESERVE






CLIENT: TAYLOR MORRISON OF FLORIDA, INC.
PLAN AND PROFILE: CORDANA COURT (STA. 1+00.00 TO END)
PLAN AND PROFILE: ALTESINO COURT (STA. 1+00.00 TO END)

PLAN REVISIONS
1. 07/28/10 REVISED PER SARASOTA COUNTY COMMENTS
2. 08/14/10 REVISED PER SARASOTA COUNTY COMMENTS
3. 10/04/10 REVISED PER SARASOTA COUNTY COMMENTS

FLORIDA CERTIFICATE OF AUTHORIZATION #9638
NICHOLAS W. SPEAR, P.E.
12/15/10
SET NUMBER: 225-01-01
SHEET: 26

CIVIL ENGINEERING &
LAND DEVELOPMENT CONSULTANTS
25100 BONITA GRANDE DRIVE - SUITE 305 BONITA SPRINGS, FL 34135
P: 239-405-7777 F: 239-405-7999 EMAIL: info@waldropengineering.com

1/23/25-01 Verona Reserve/AmcCA0235-01-01 Concurrent Subdivision Plan/Rev04/25010127.dwg Dec 14, 2010 2:20pm

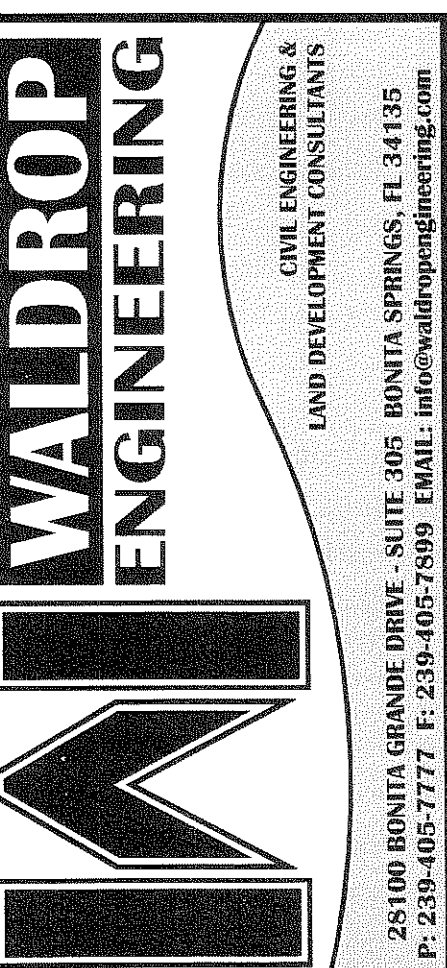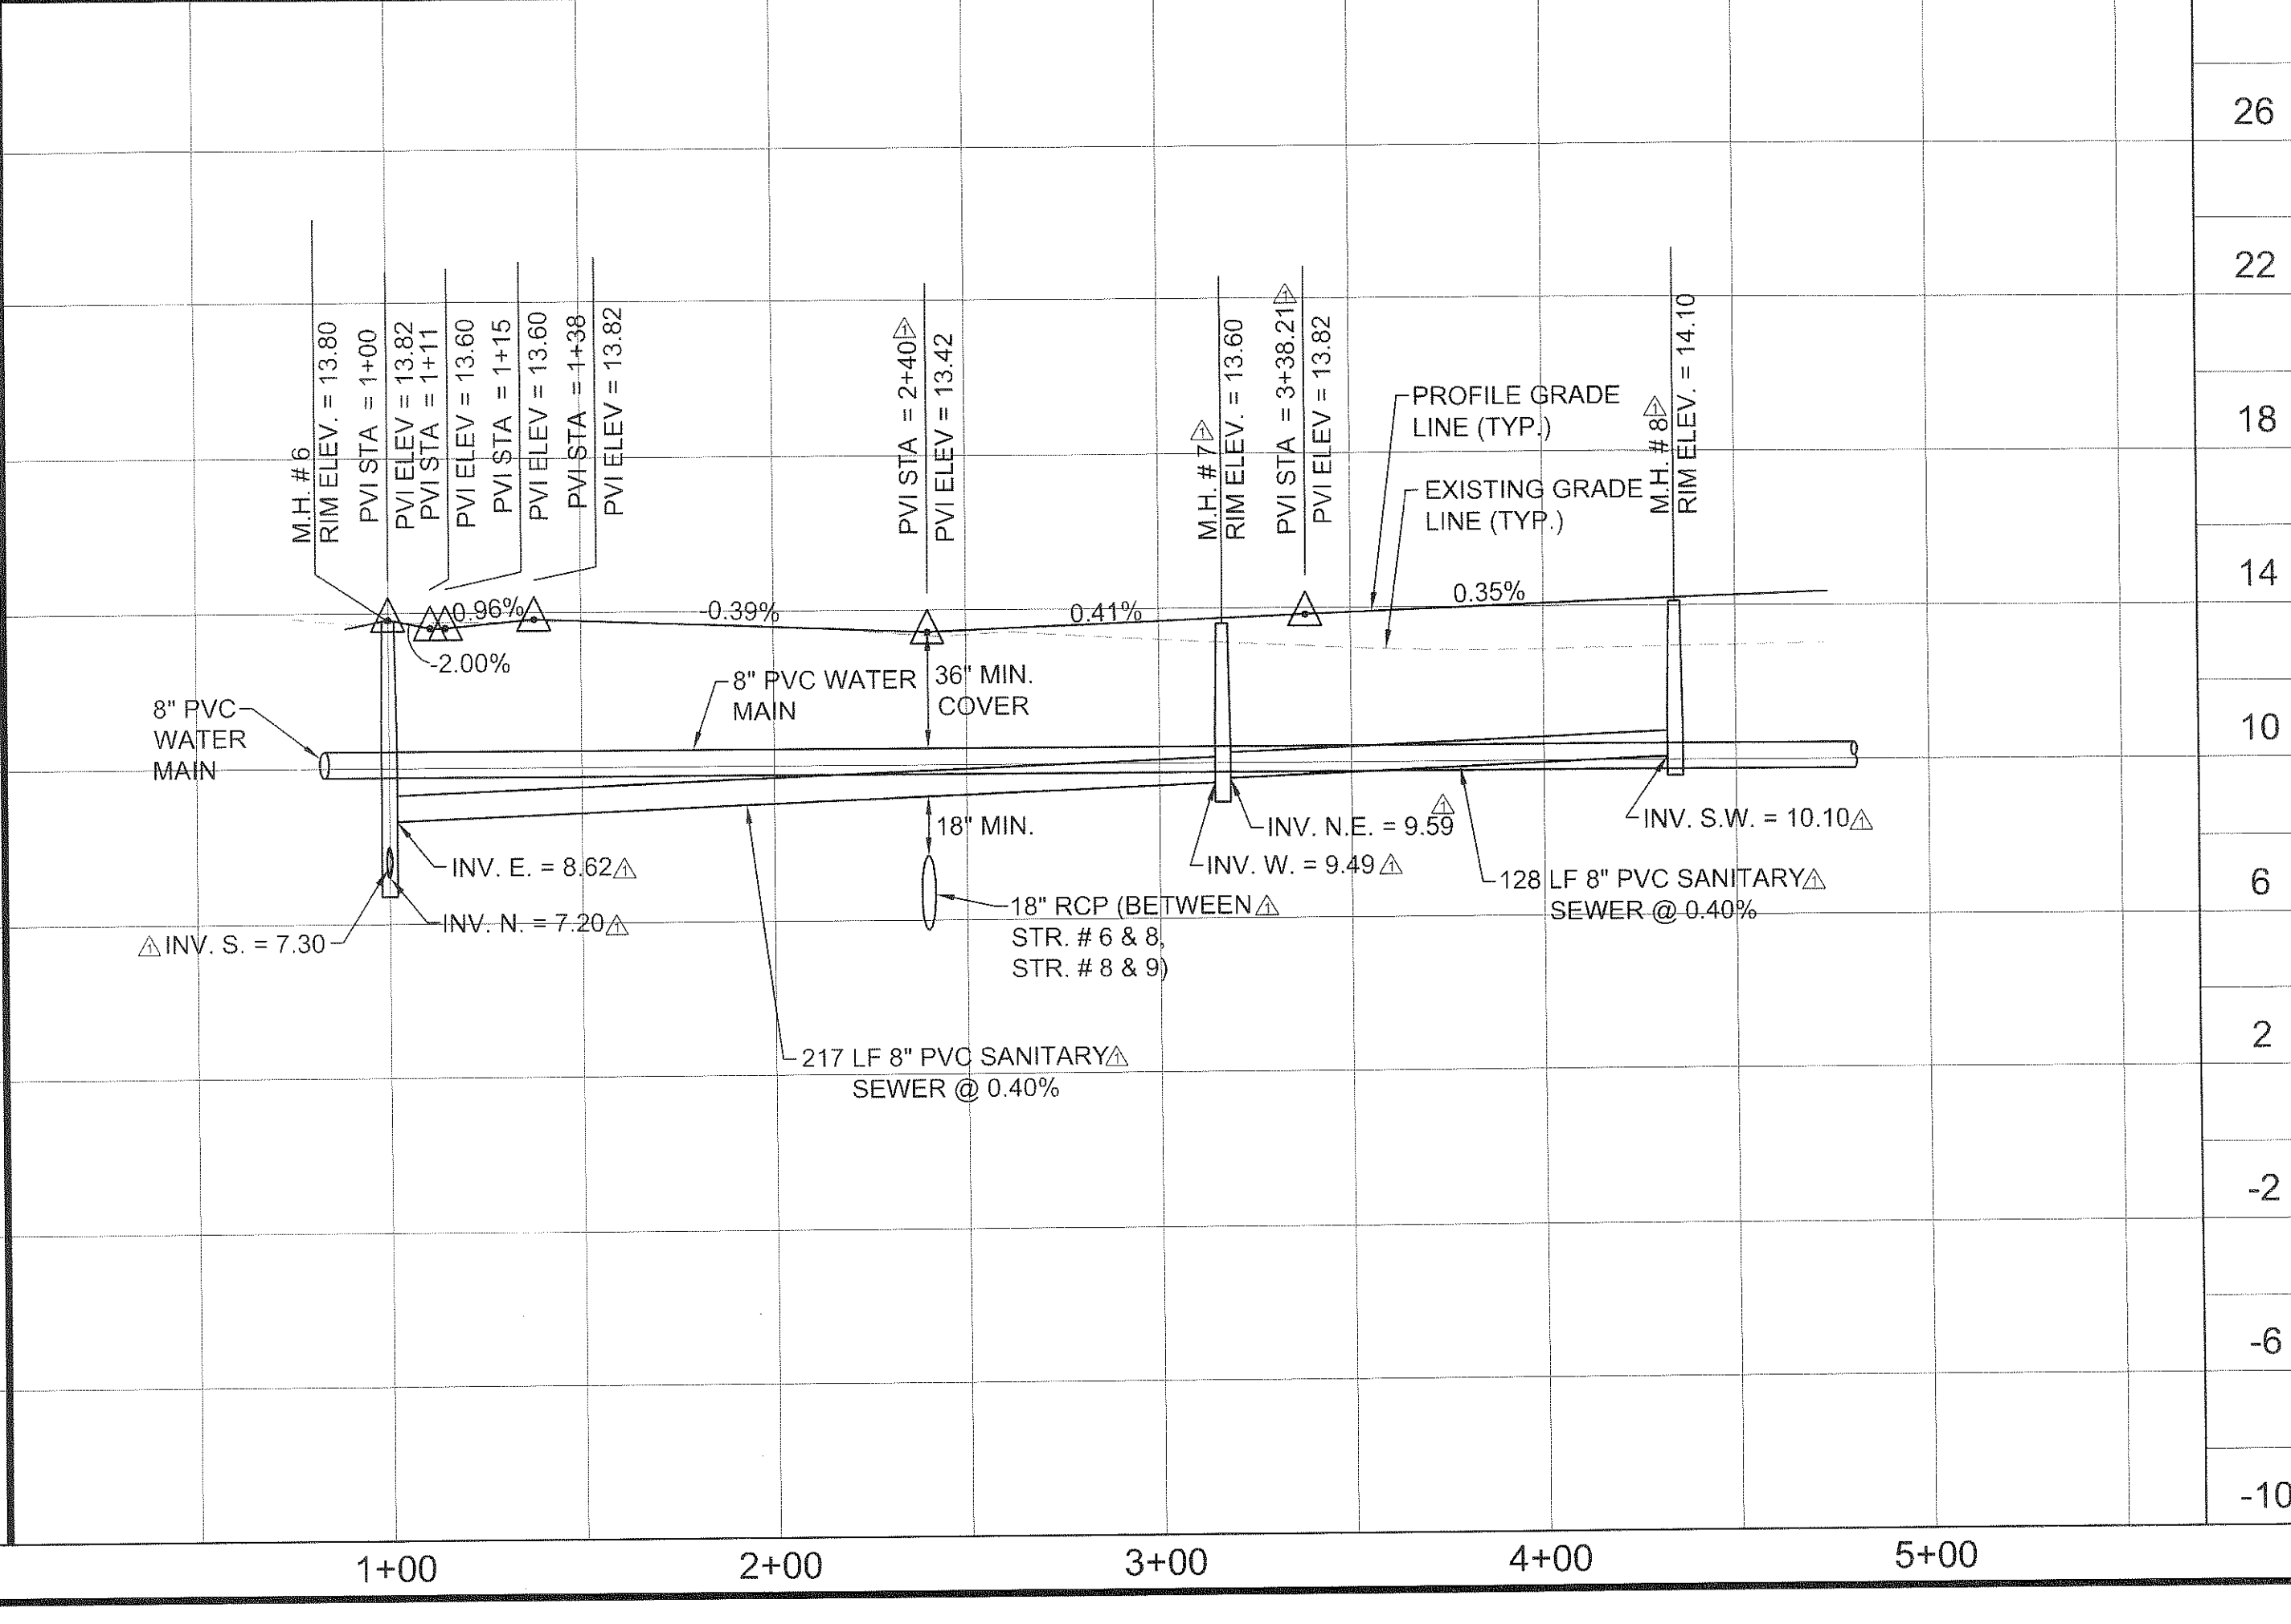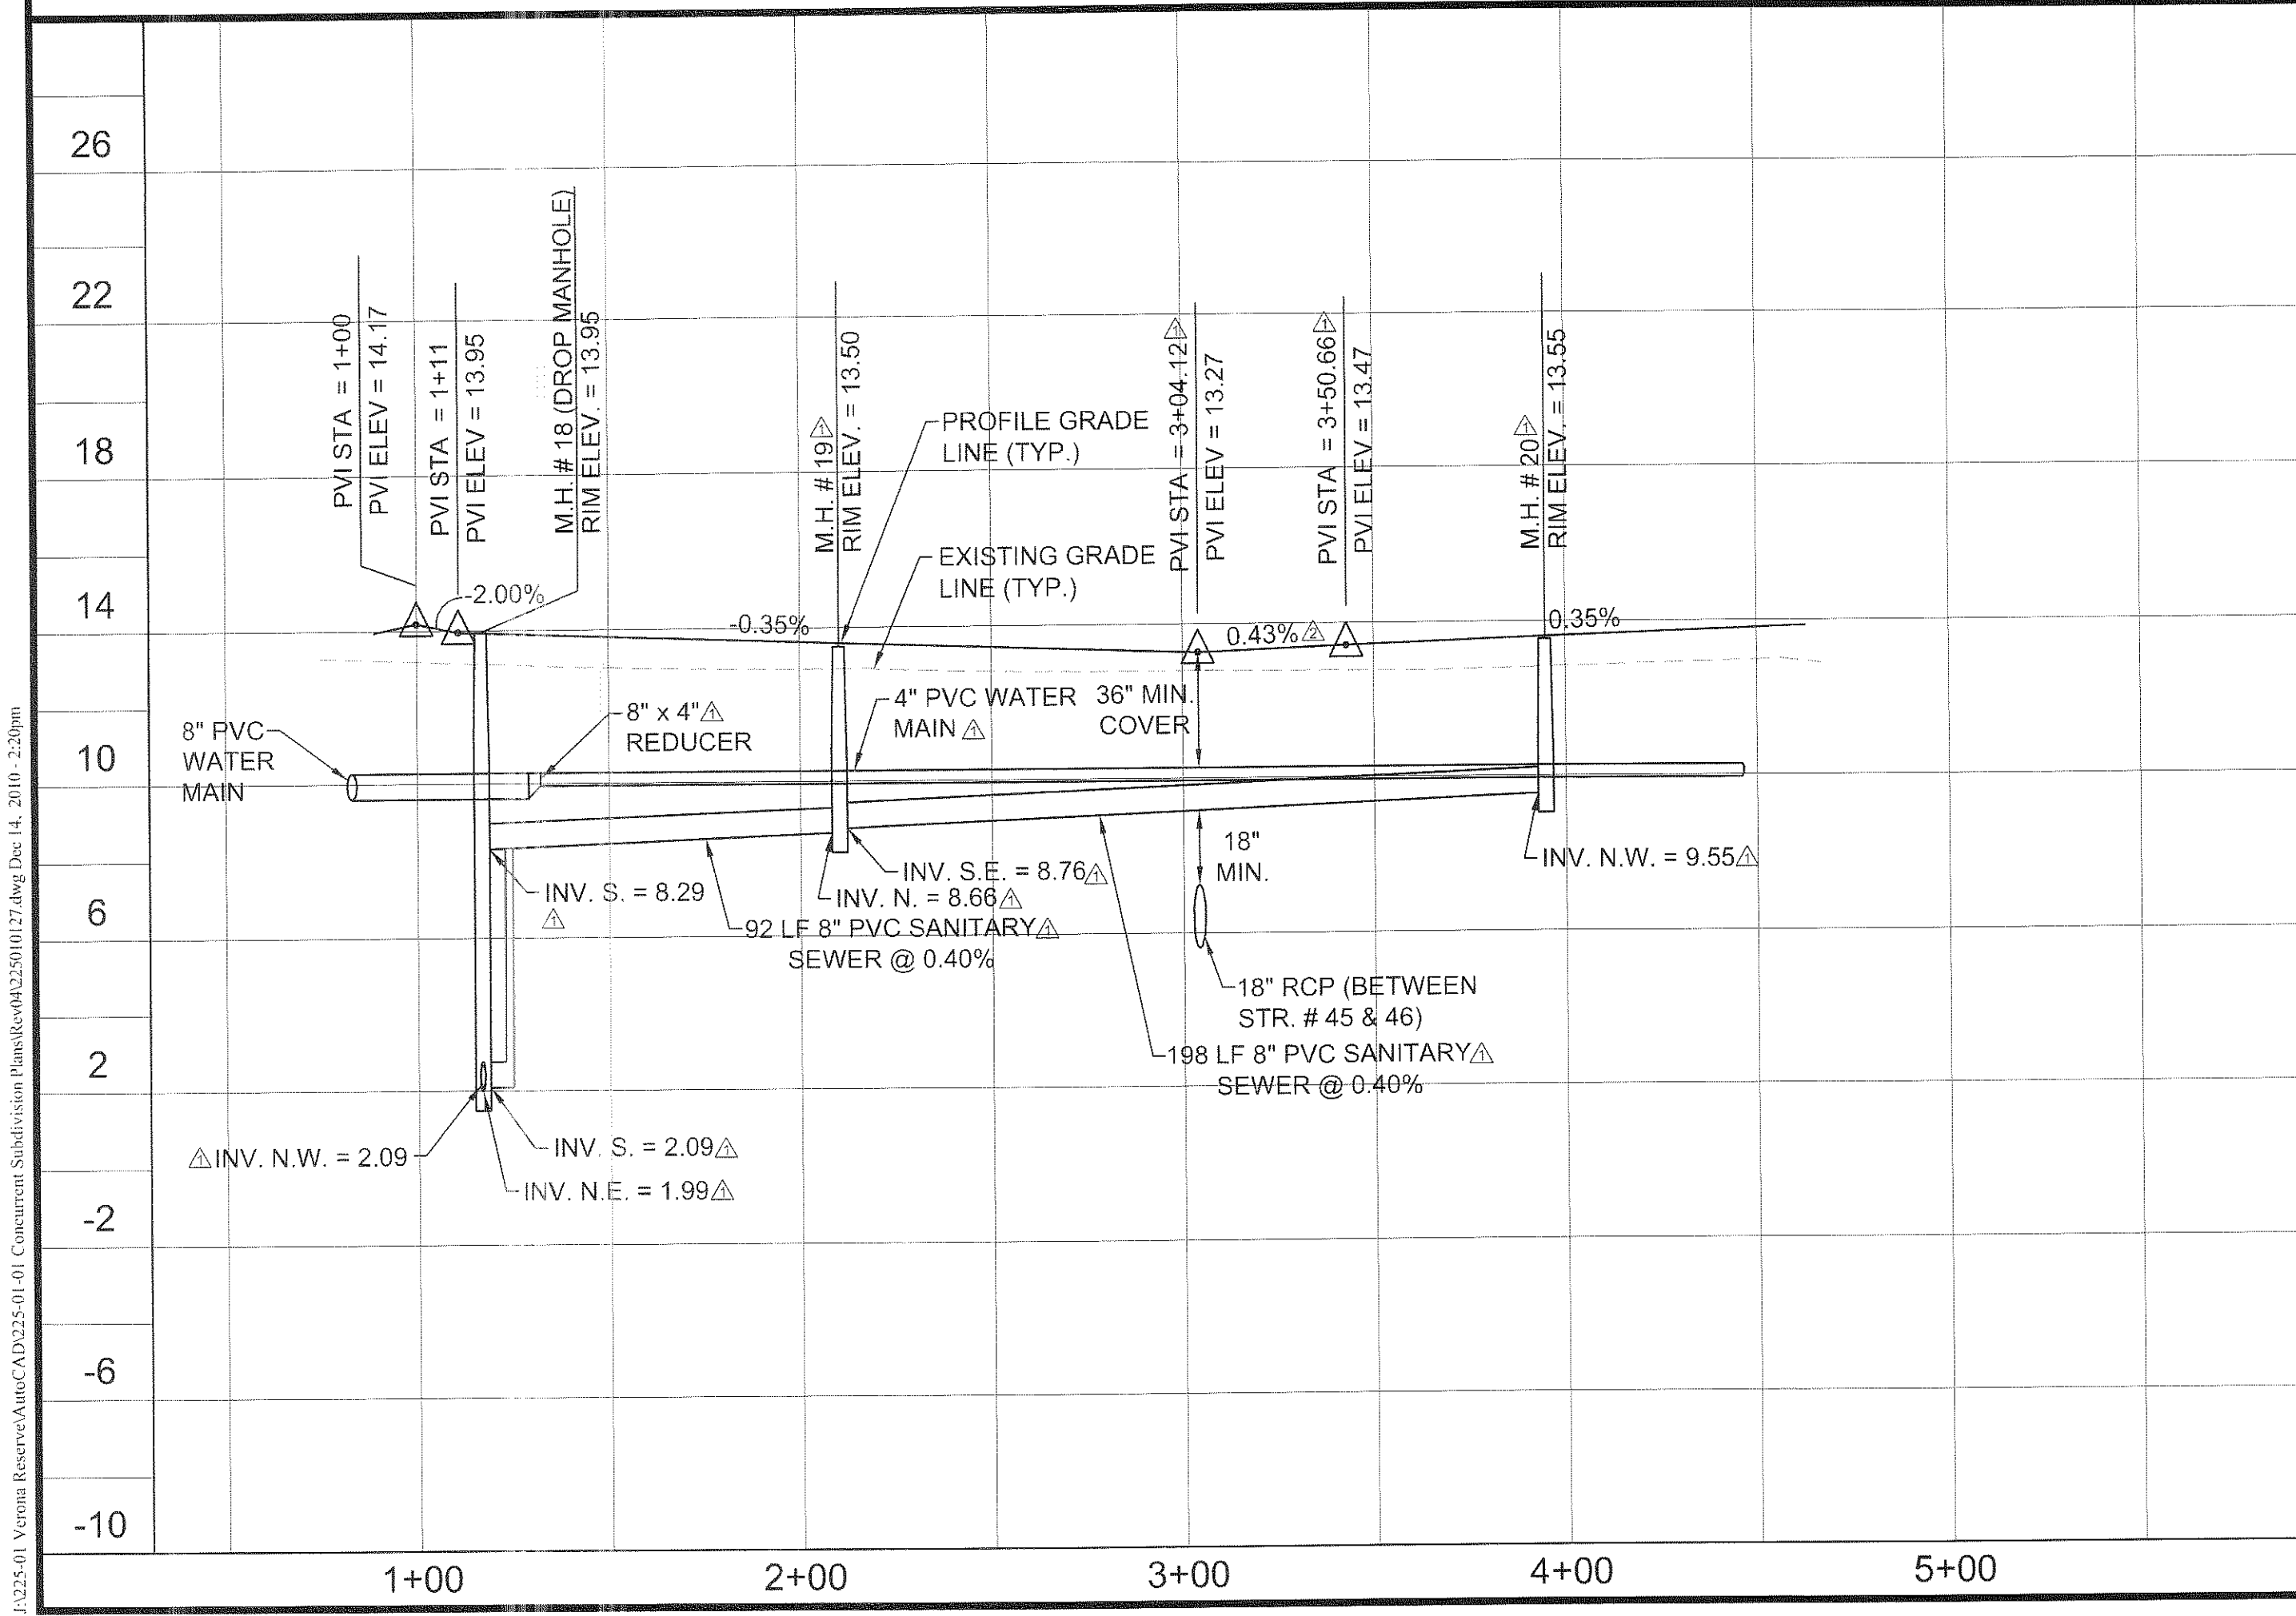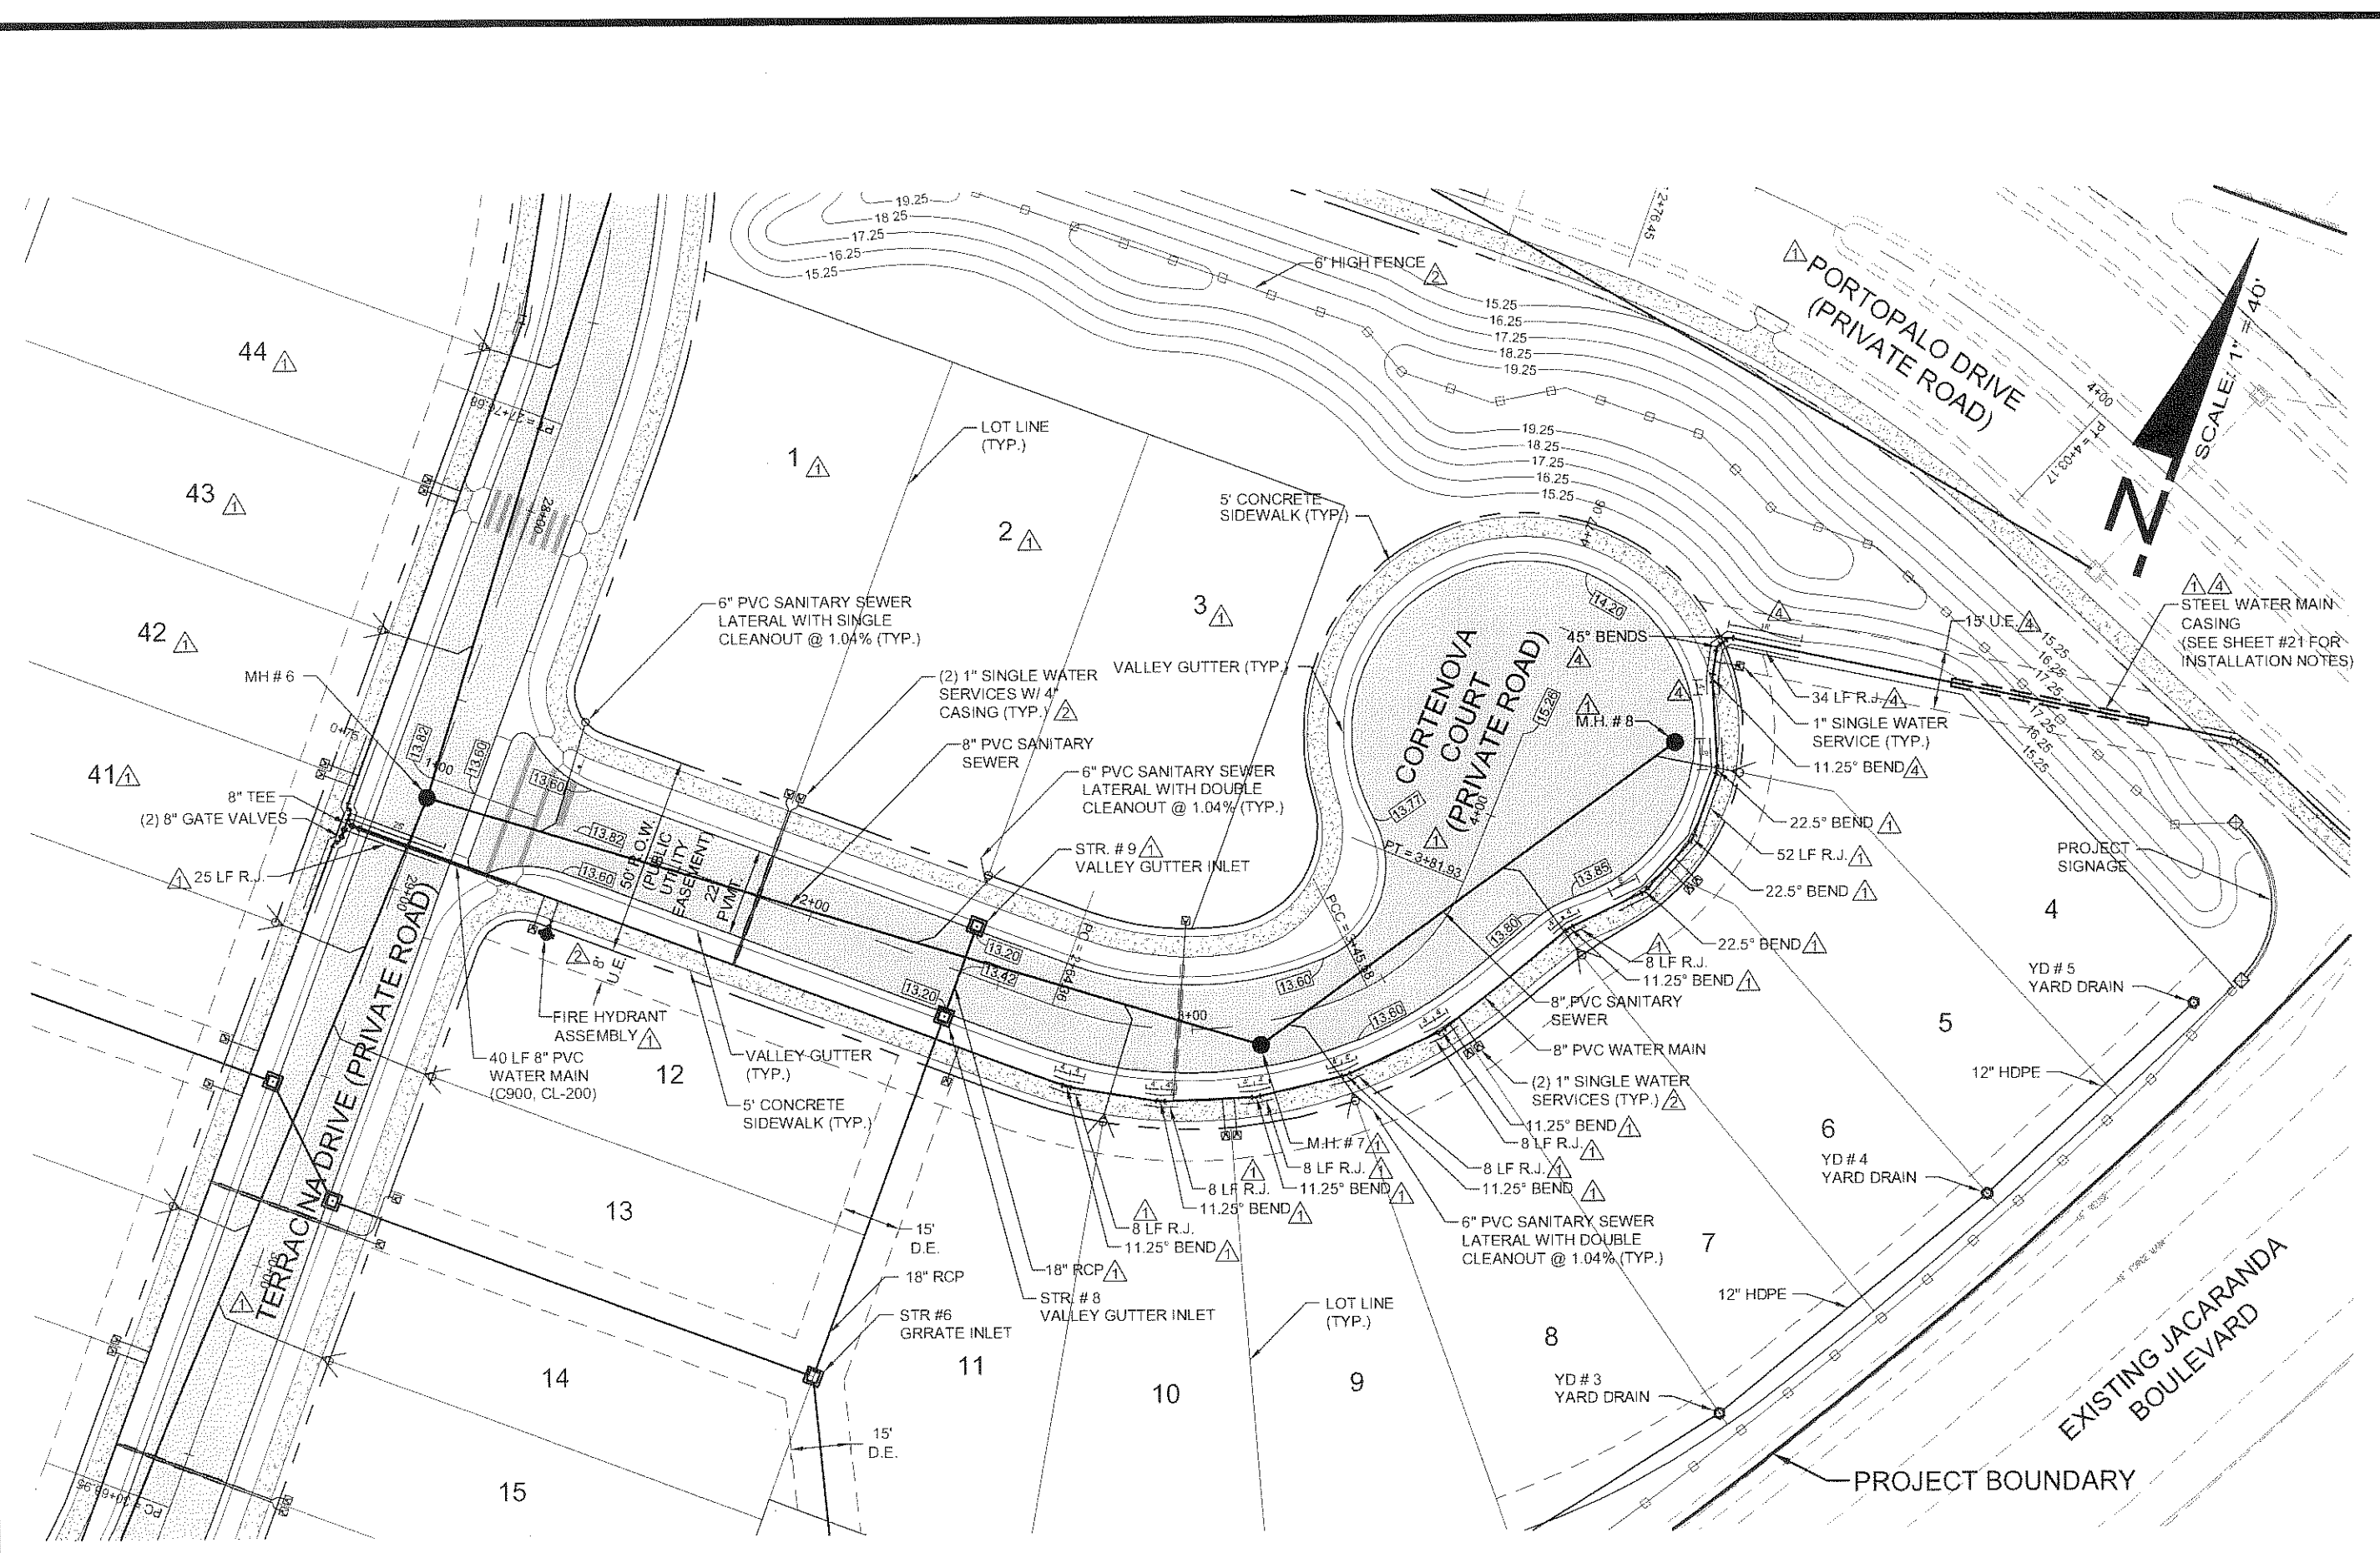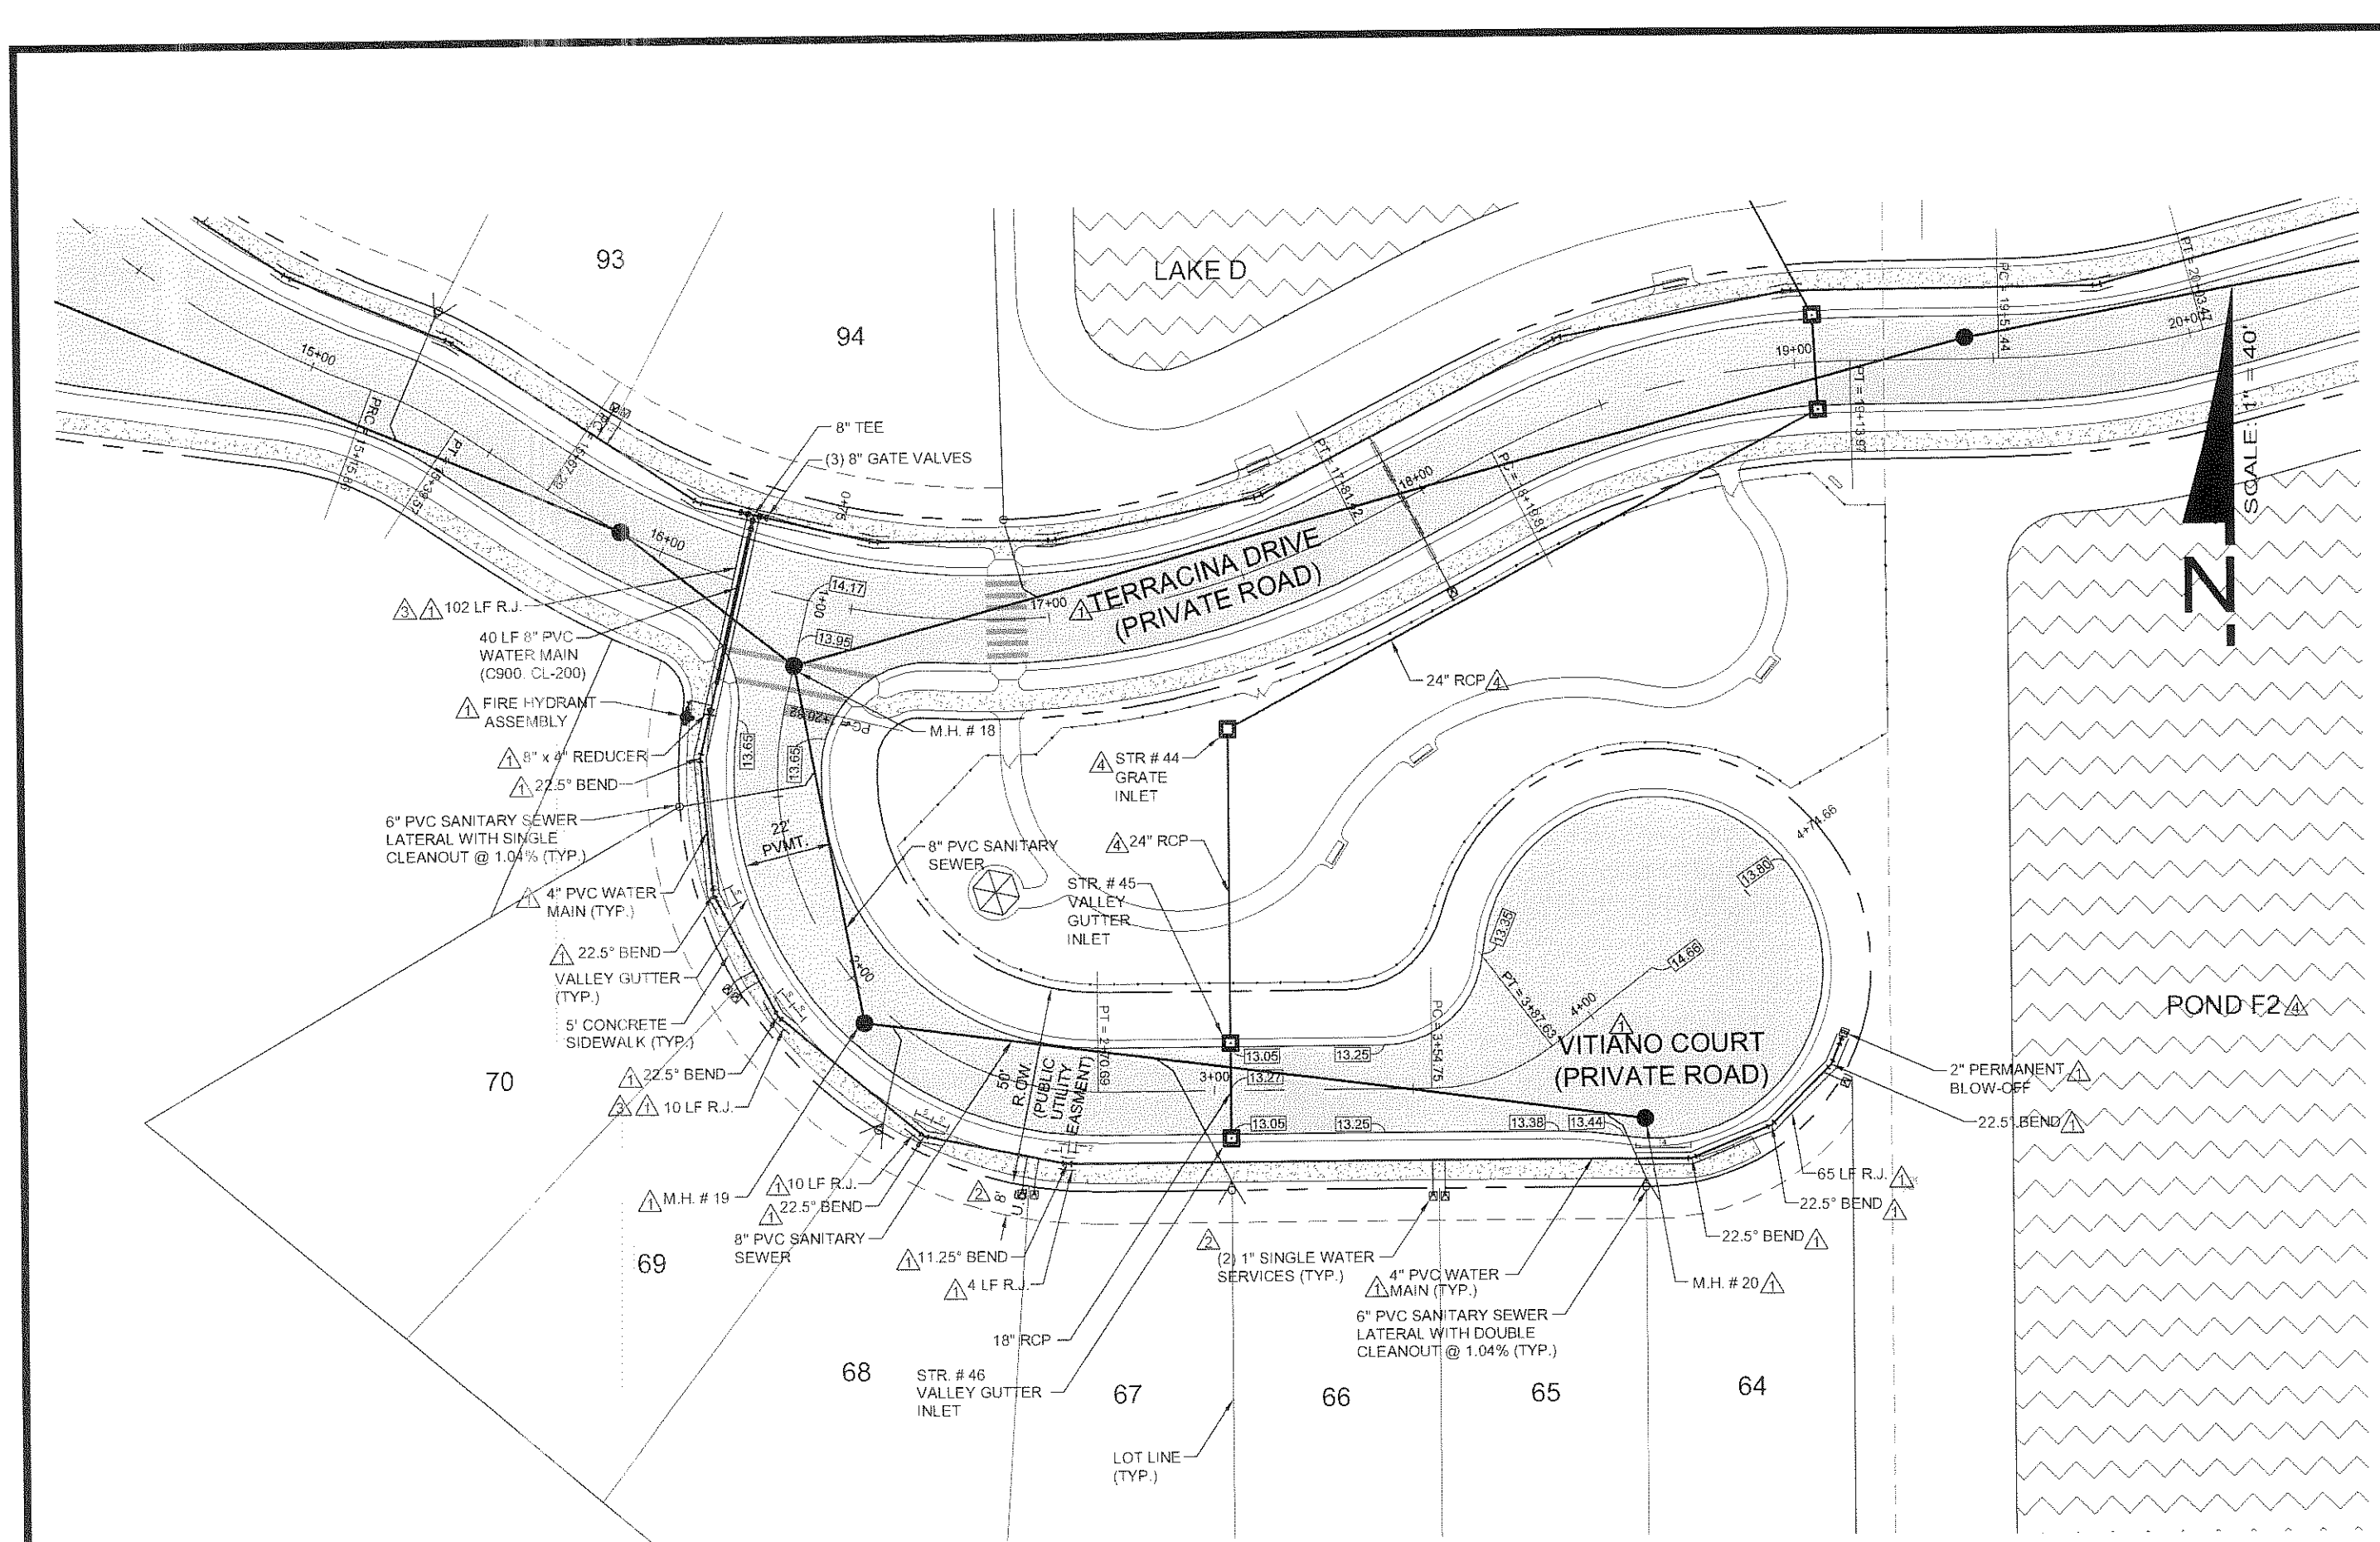

VERONA RESERVE



CLIENT: TAYLOR MORRISON OF FLORIDA, INC.

PLAN AND PROFILE: VITIANO COURT (STA. 1+00.00 TO END)

PLAN AND PROFILE: CORTENOVA COURT (STA. 1+00.00 TO END)

PLAN REVISIONS			
1	02/28/10	REVISED PER SARASOTA COUNTY COMMENTS	
2	03/04/10	REVISED PER SARASOTA COUNTY COMMENTS	
3	03/04/10	REVISED PER SARASOTA COUNTY COMMENTS	
4	03/04/10	REVISED PER CLIENT & SARASOTA COUNTY UTILITY COMMENTS	
FLORIDA CERTIFICATE OF AUTHORIZATION 0603			
SET NUMBER:		225-01-01	
SHEET:		27	




J:\225-01 Verona Reserve\AutoCAD\225-01.dwg Concurrent Subdivision Plans\Rev04\225-01.dwg Dec 14, 2010 - 2:20pm

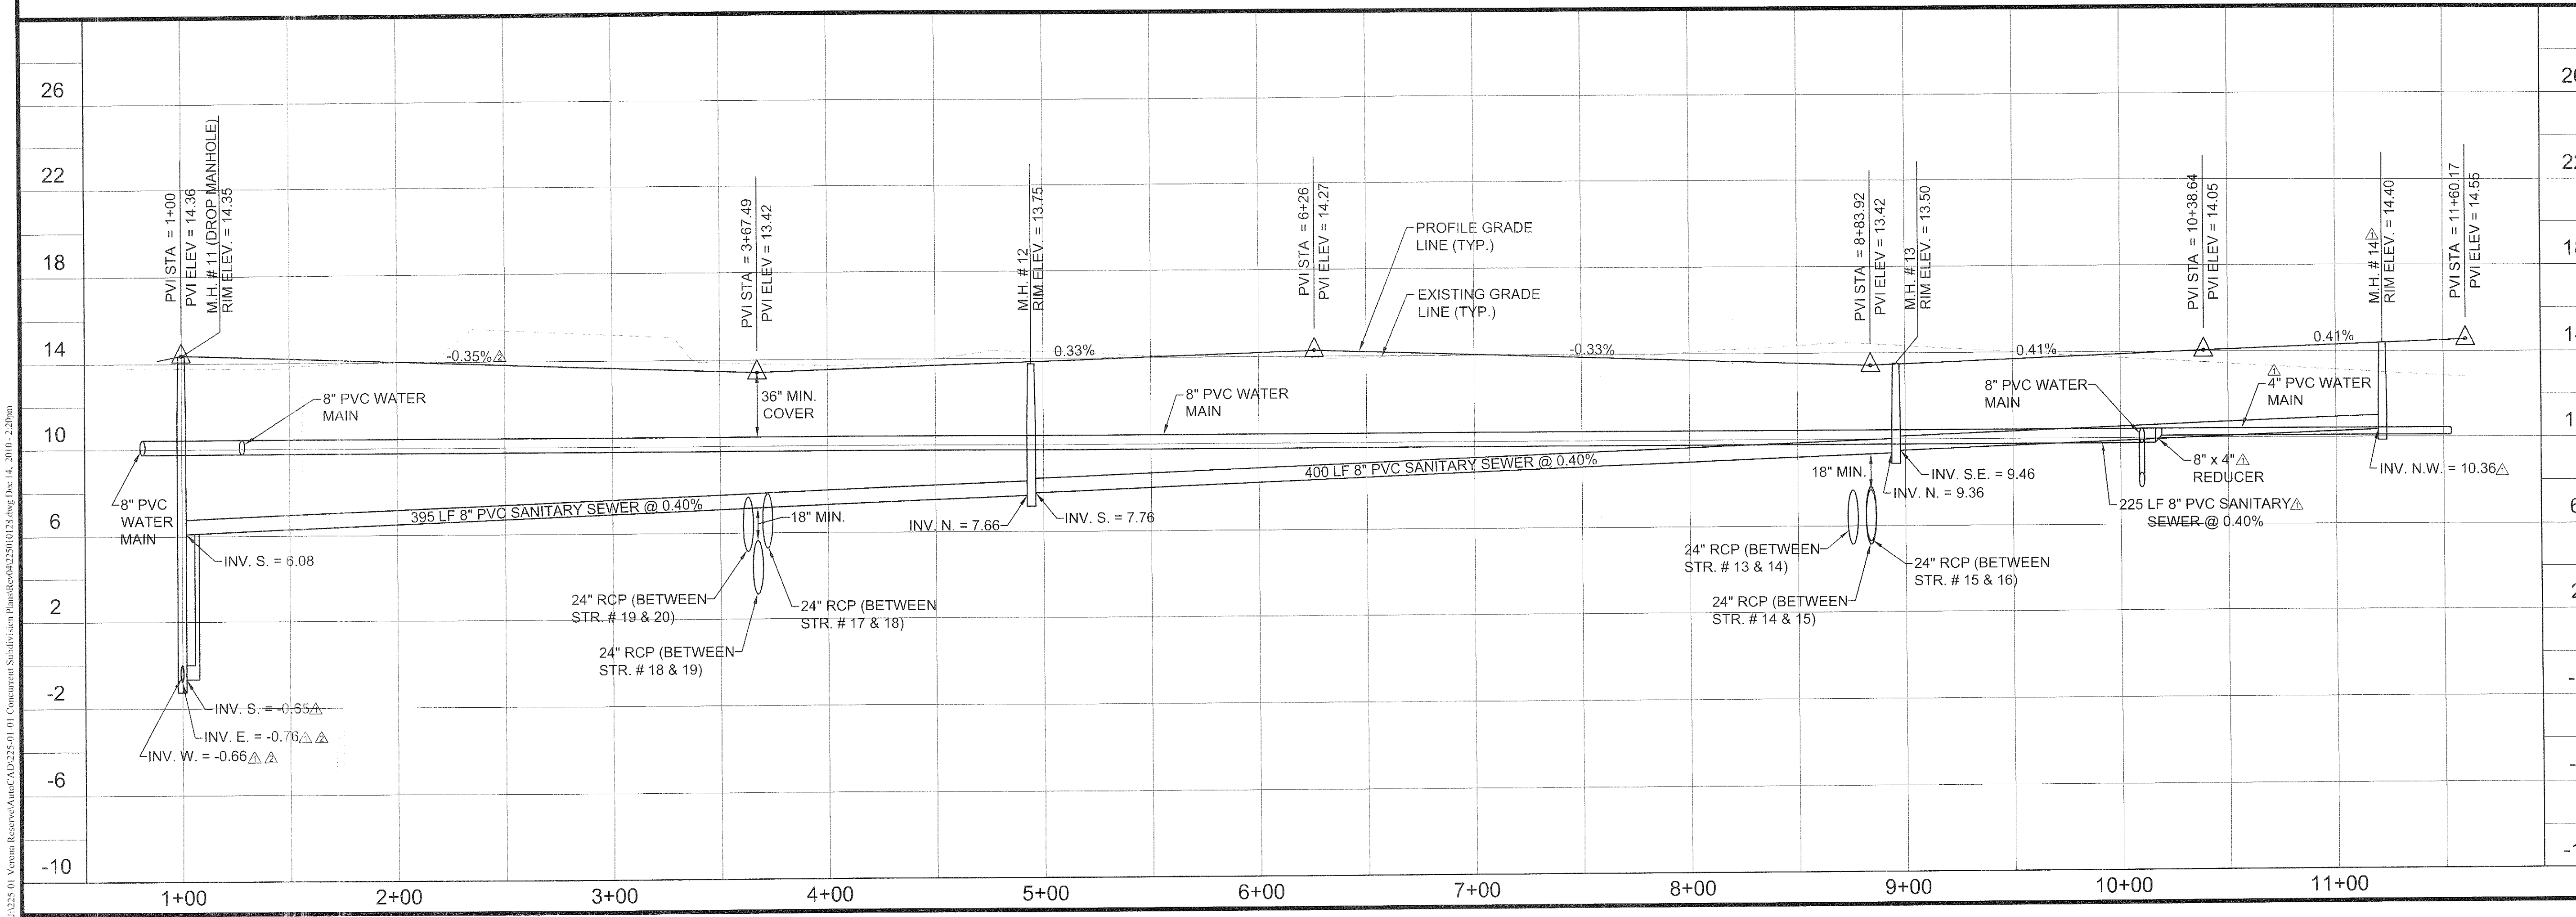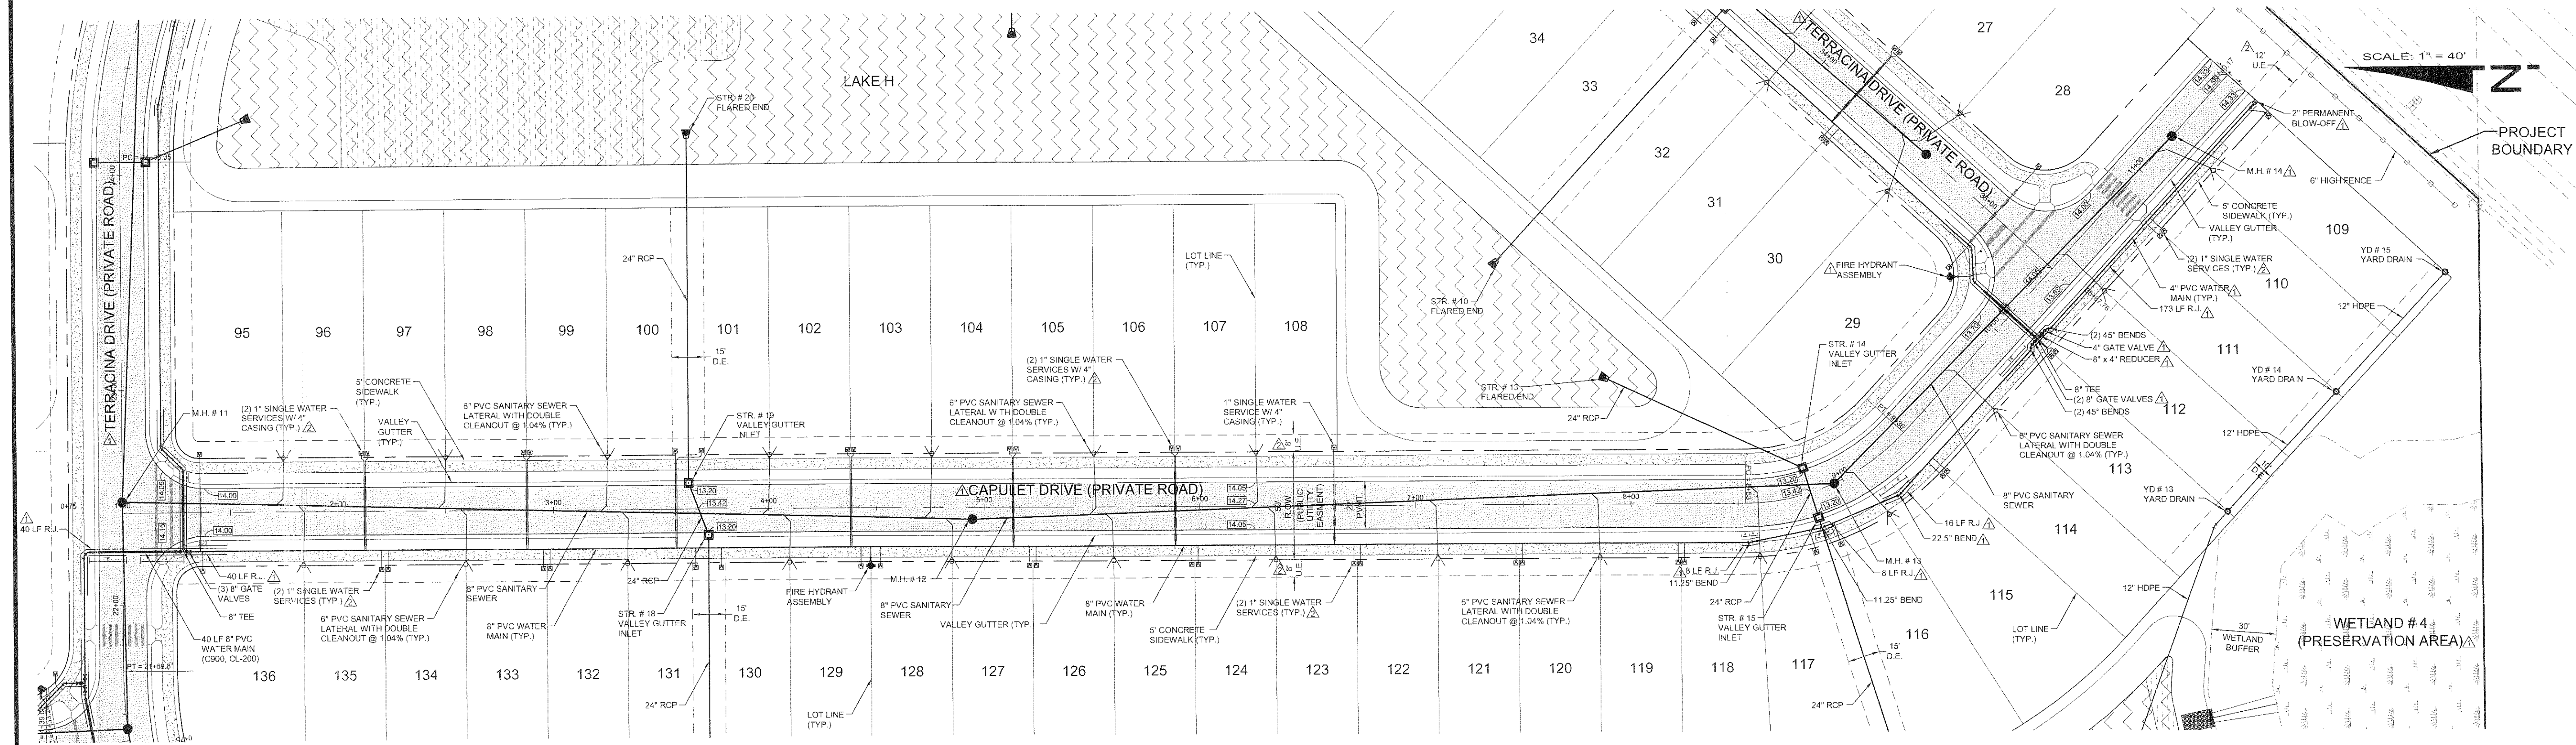

WALDROP
ENGINEERING
254100 DONATA GRADY DRIVE, SUITE 305 DONATA SPRINGS, FL 34135
P: 239-405-7777 F: 239-405-7599 EMAIL: info@waldropengineering.com

VERONA RESERVE
CLIENT: TAYLOR MORRISON OF FLORIDA, INC.
PLAN AND PROFILE: CAPULET DRIVE
(STA. 1+00.00 TO END)

PLAN REVISIONS	
01/20/10	REVISED PER SARASOTA COUNTY COMMENTS
02/04/10	REVISED PER SARASOTA COUNTY COMMENTS
02/04/10	REVISED PER SARASOTA COUNTY COMMENTS
02/04/10	REVISED PER SARASOTA COUNTY COMMENTS
FLORIDA CERTIFICATE OF AUTHORIZATION (BDS)	
NICHOLAS B. SPEACHT, P.E. FLORIDA CERTIFICATE NO. 73357	
SET NUMBER: 225-01-01	
SHEET: 28	

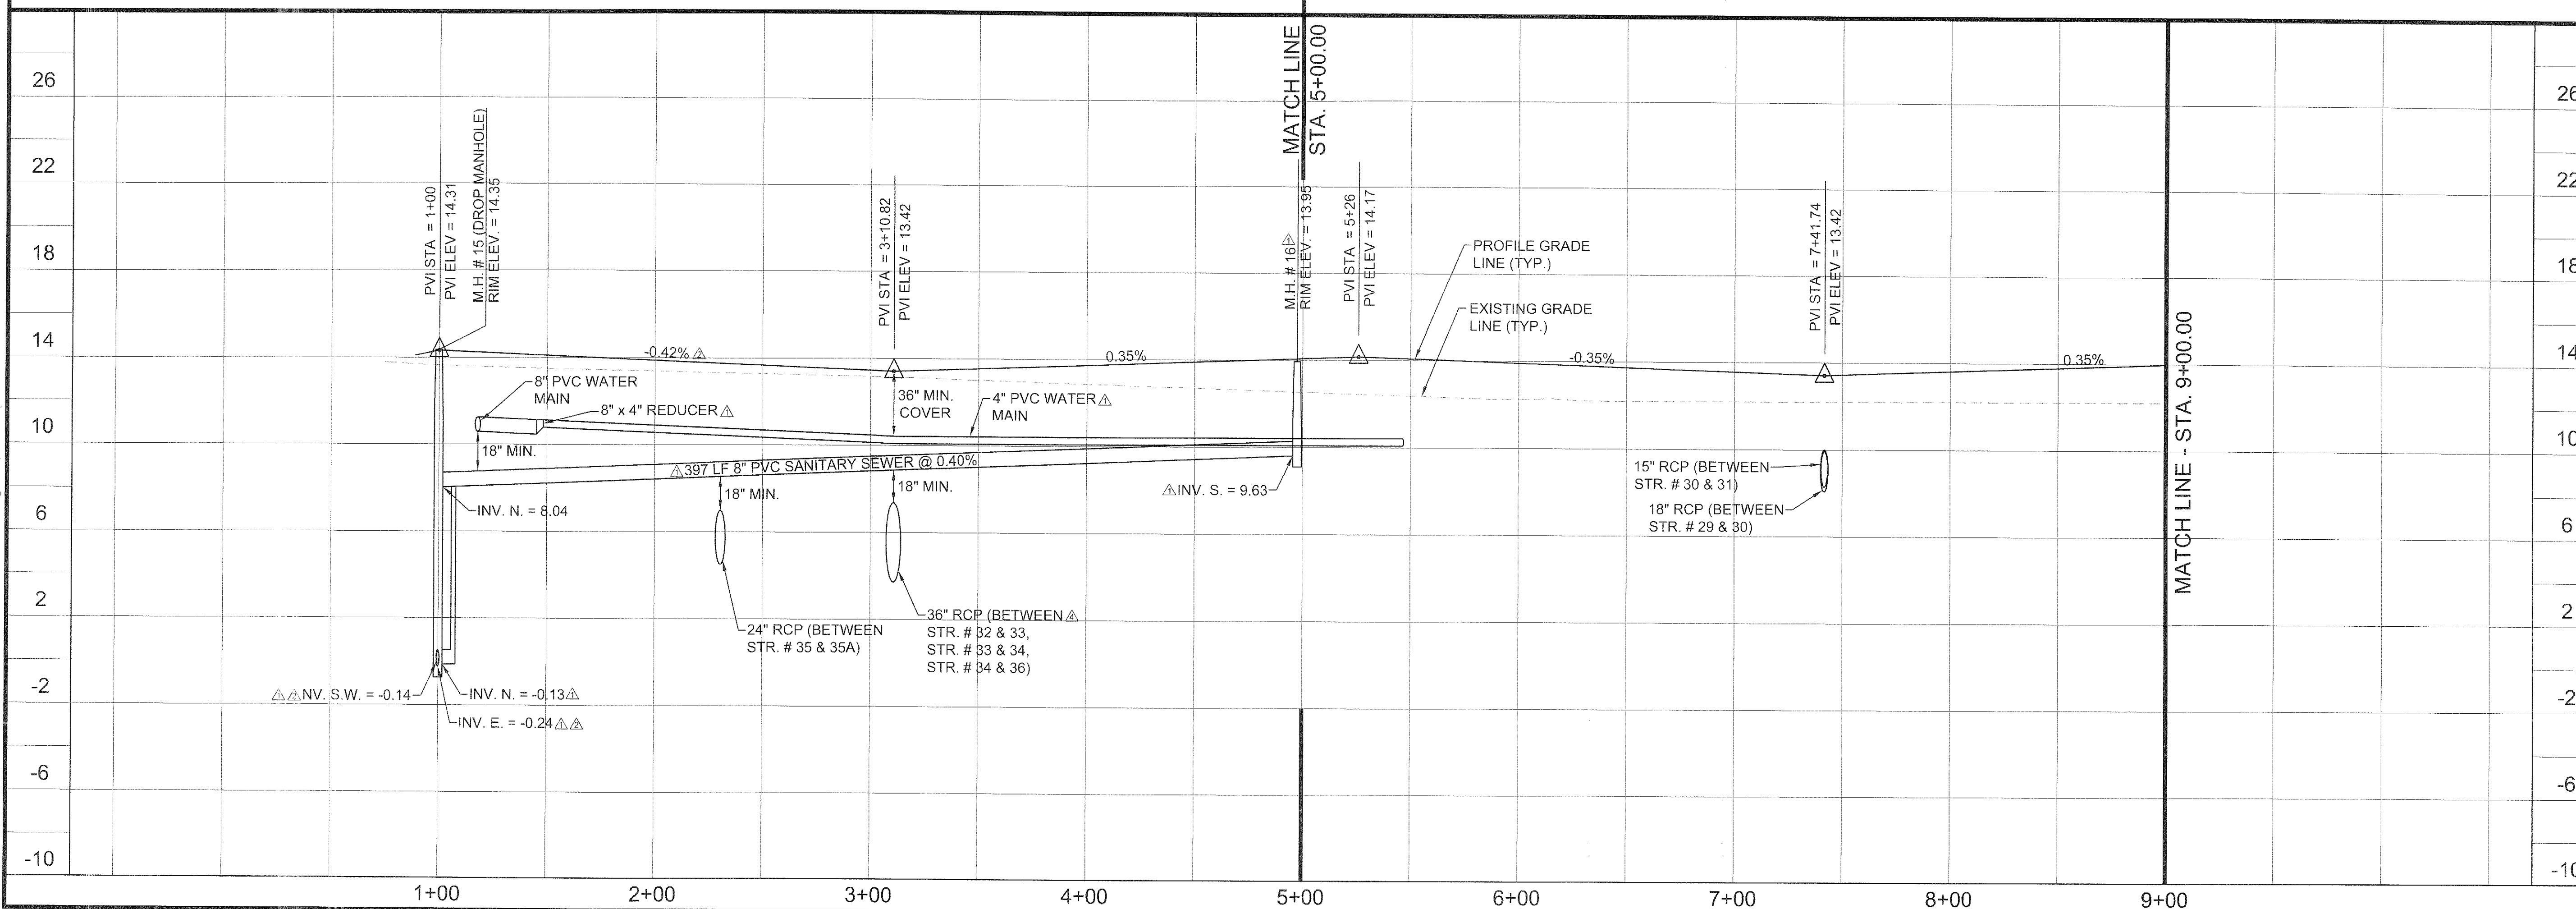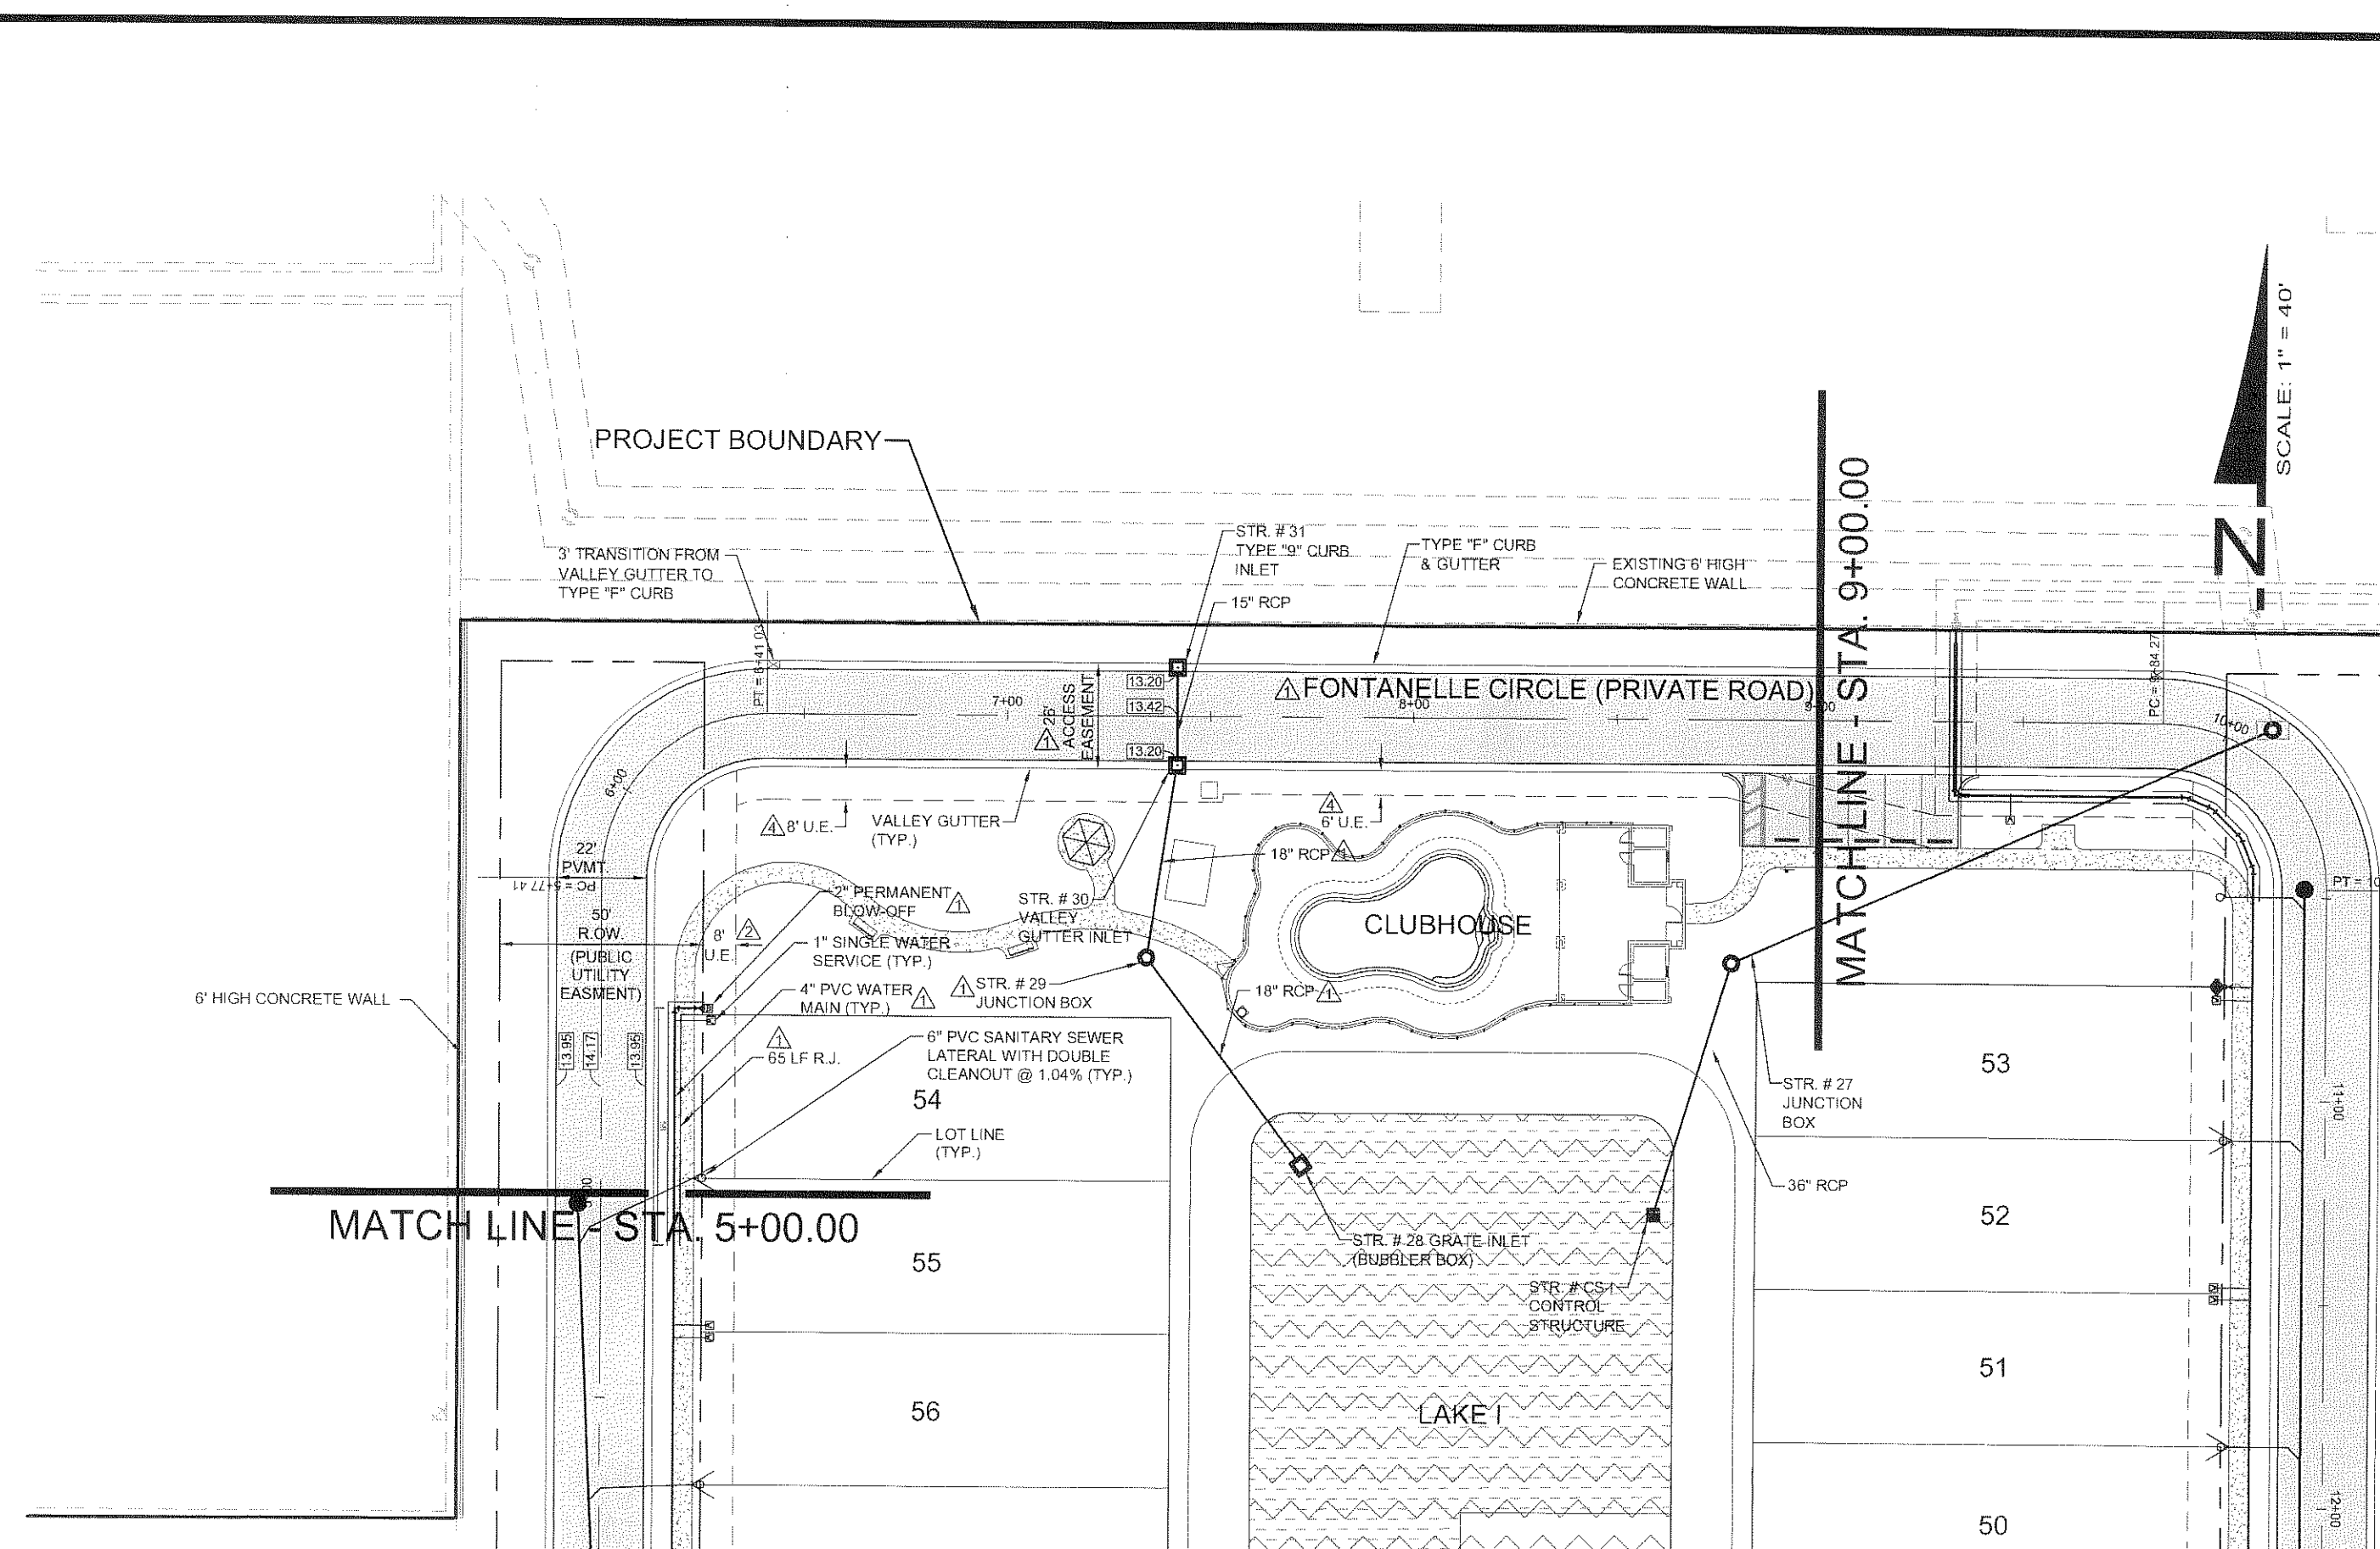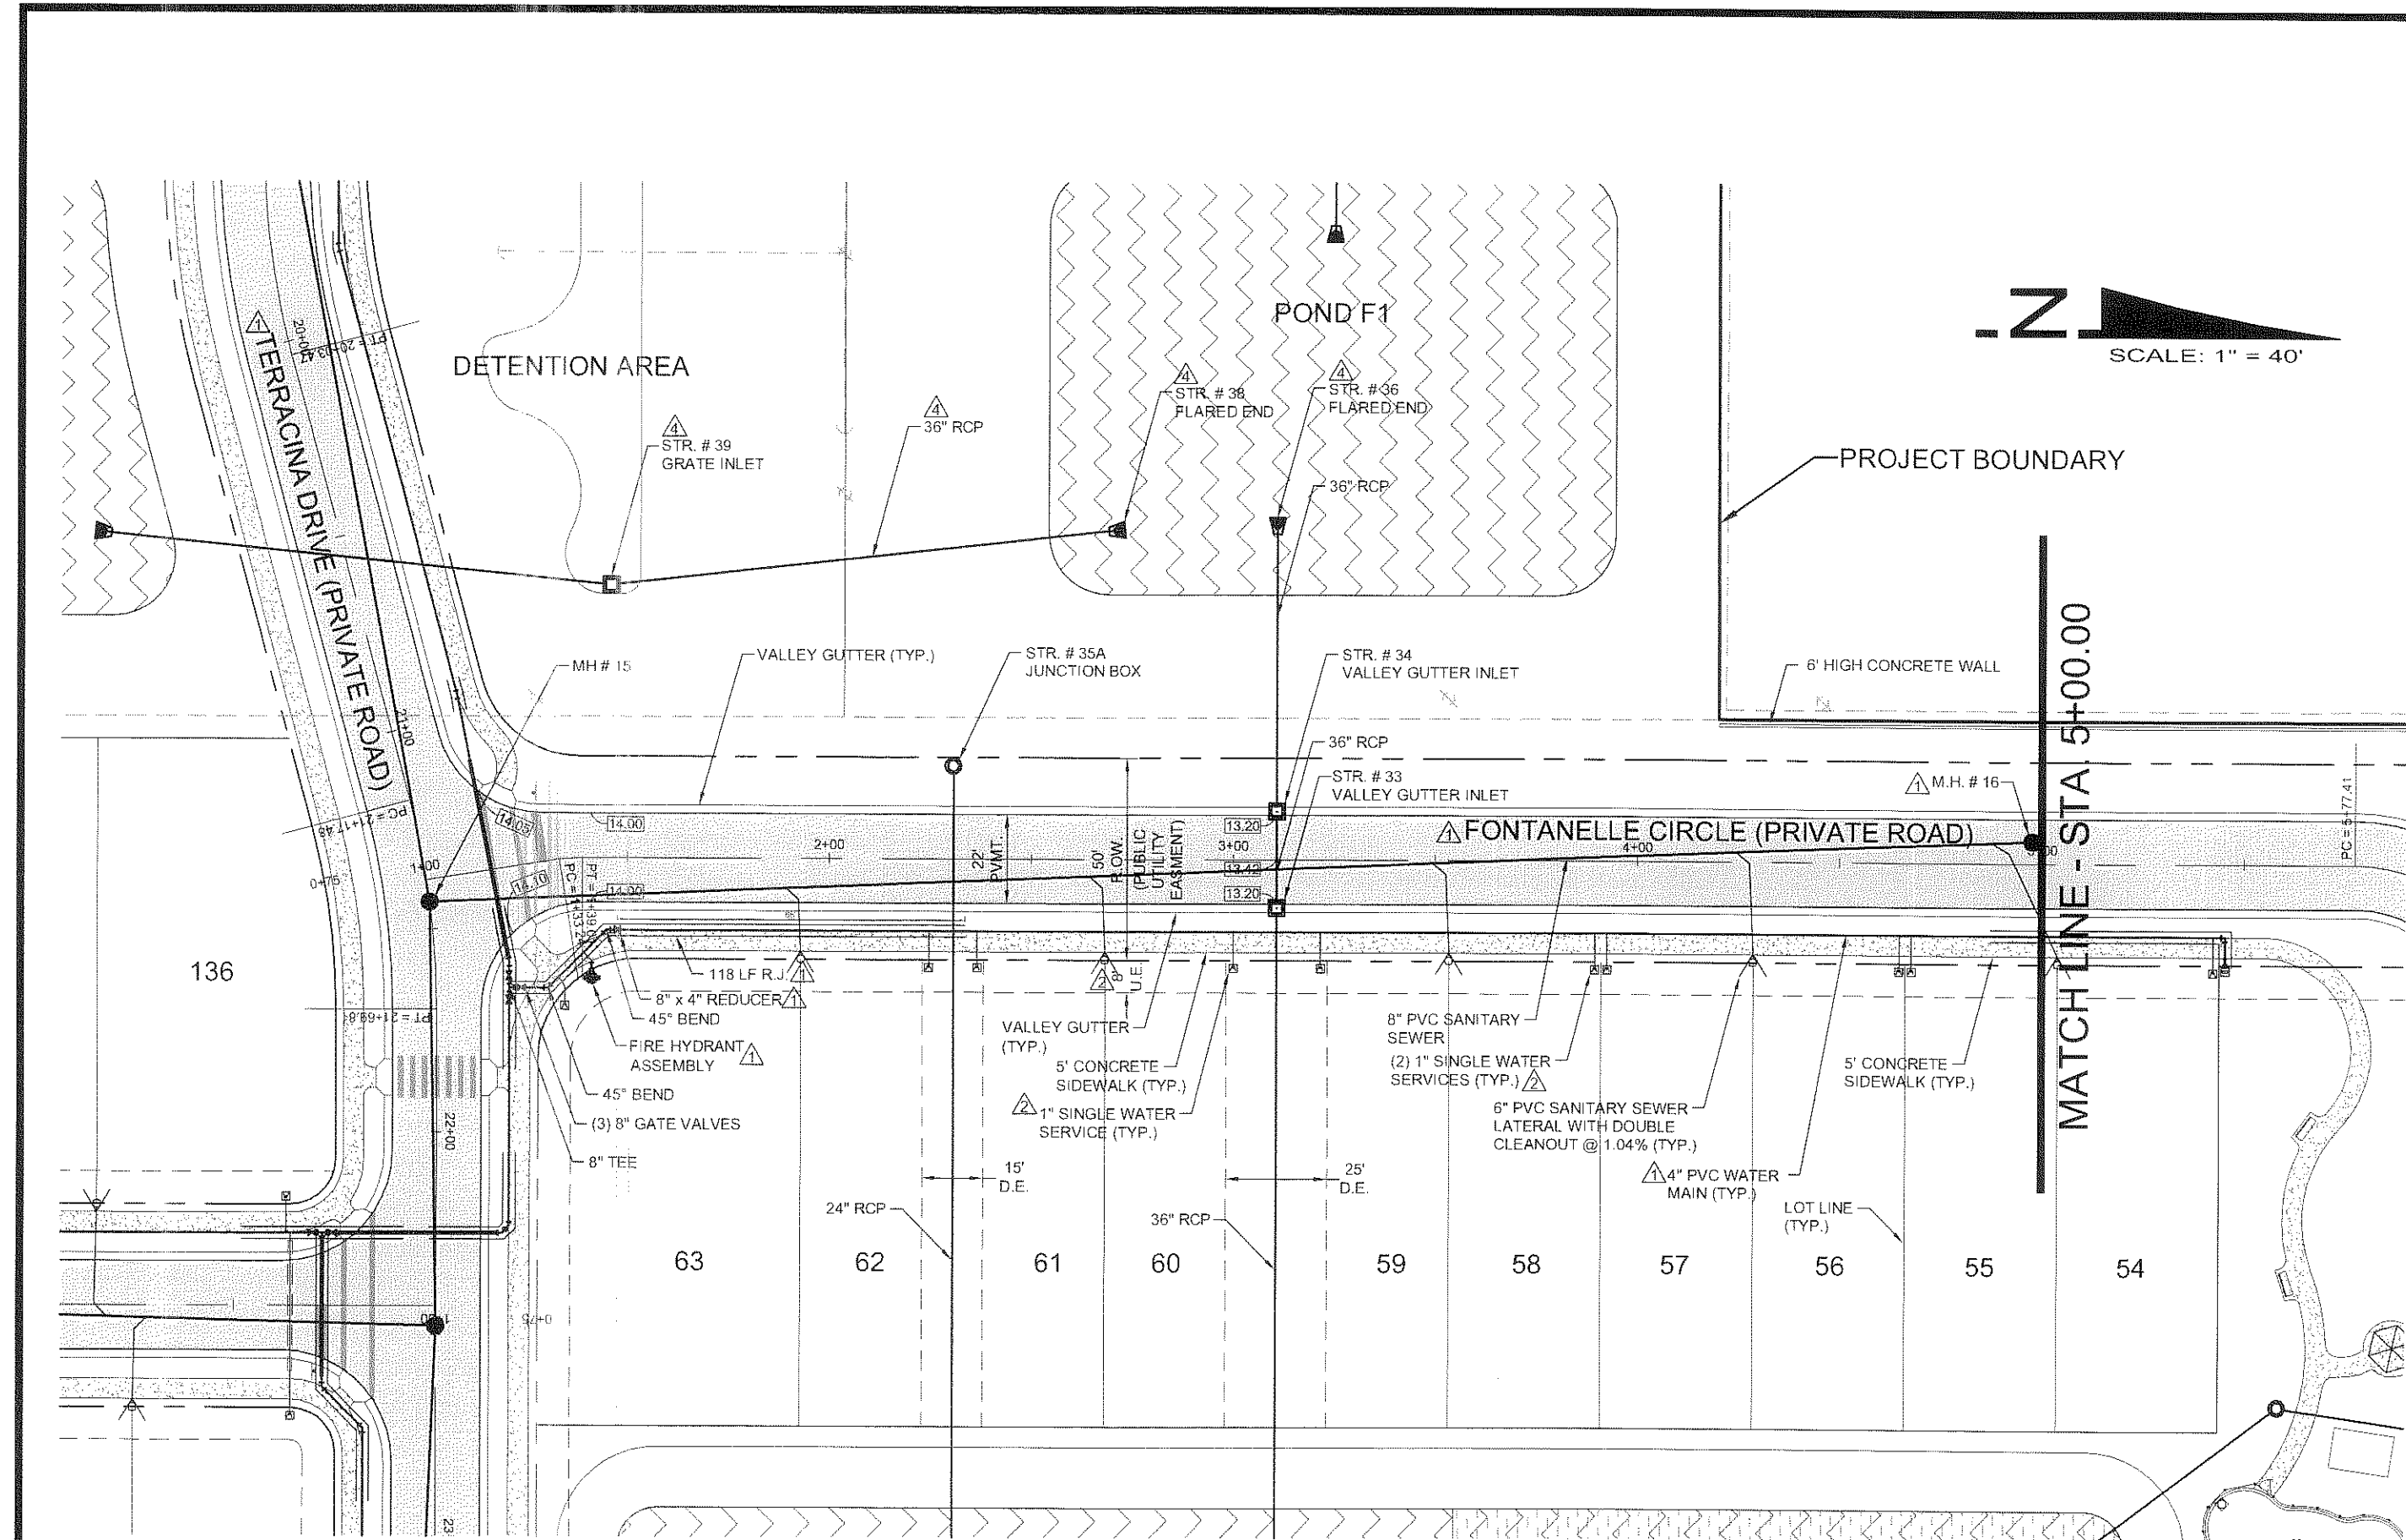[illegible]


WALDROP
ENGINEERING

VERONA RESERVE


CLIENT: TAYLOR MORRISON OF FLORIDA, INC.
 PLAN AND PROFILE: FONTANELLE CIRCLE Δ
 (STA. 1+00.00 TO STA. 9+00.00)

**CIVIL ENGINEERING &
LAND DEVELOPMENT CONSULTANTS**


28100 BONITA GRANDE DRIVE - SUITE 305 BONITA SPRINGS, FL 34135
P: 239-405-7777 F: 239-405-7899 EMAIL: info@walddropengineering.com

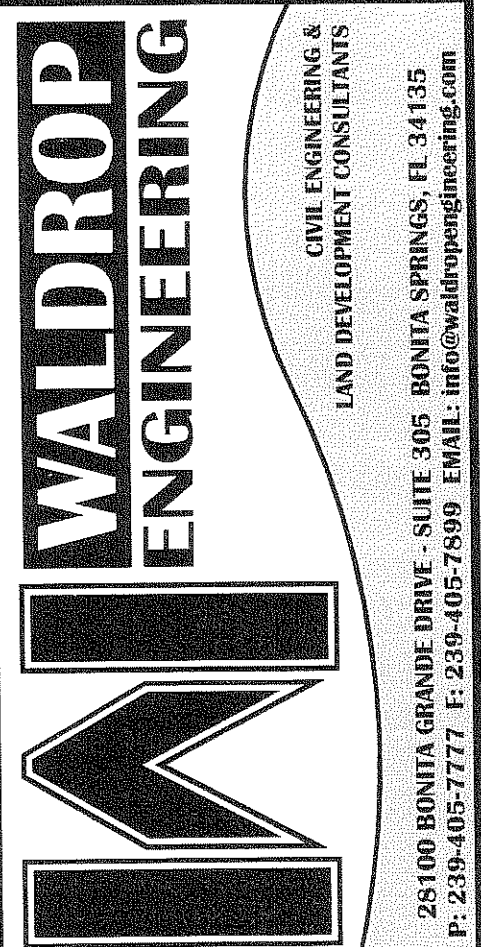

CLIENT: TAYLOR MORRISON OF FLORIDA, INC.
PLAN AND PROFILE: PORTOPALO DRIVE ▴
(STA. 0+00 TO END)

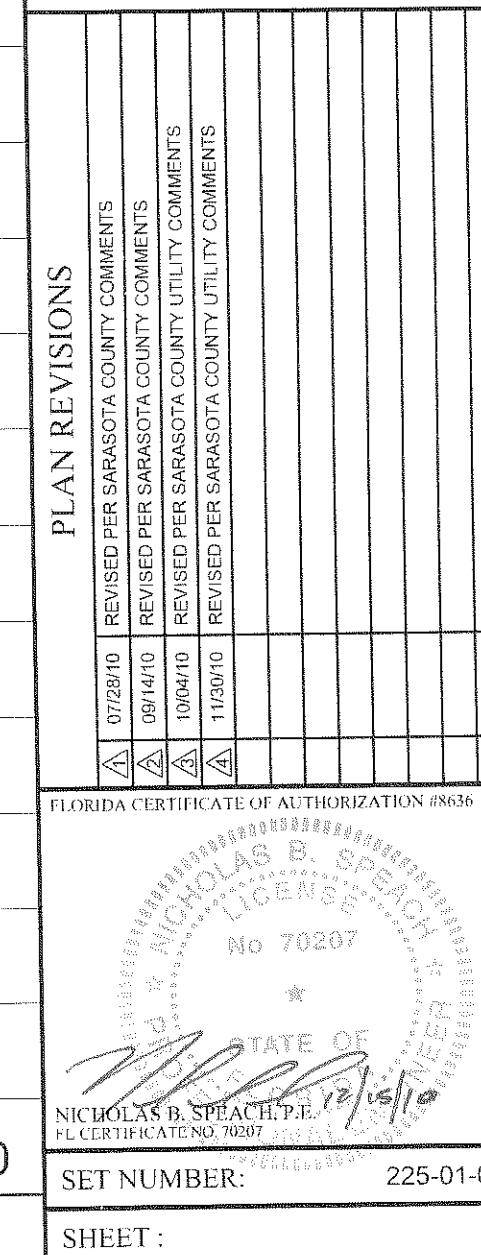

1/2/25-01 Verona Reserve/Amec/CAD/225-01.dwg Concurrent Subdivision Plans/04/25/01/035.dwg Dec 14, 2010 - 2:21pm

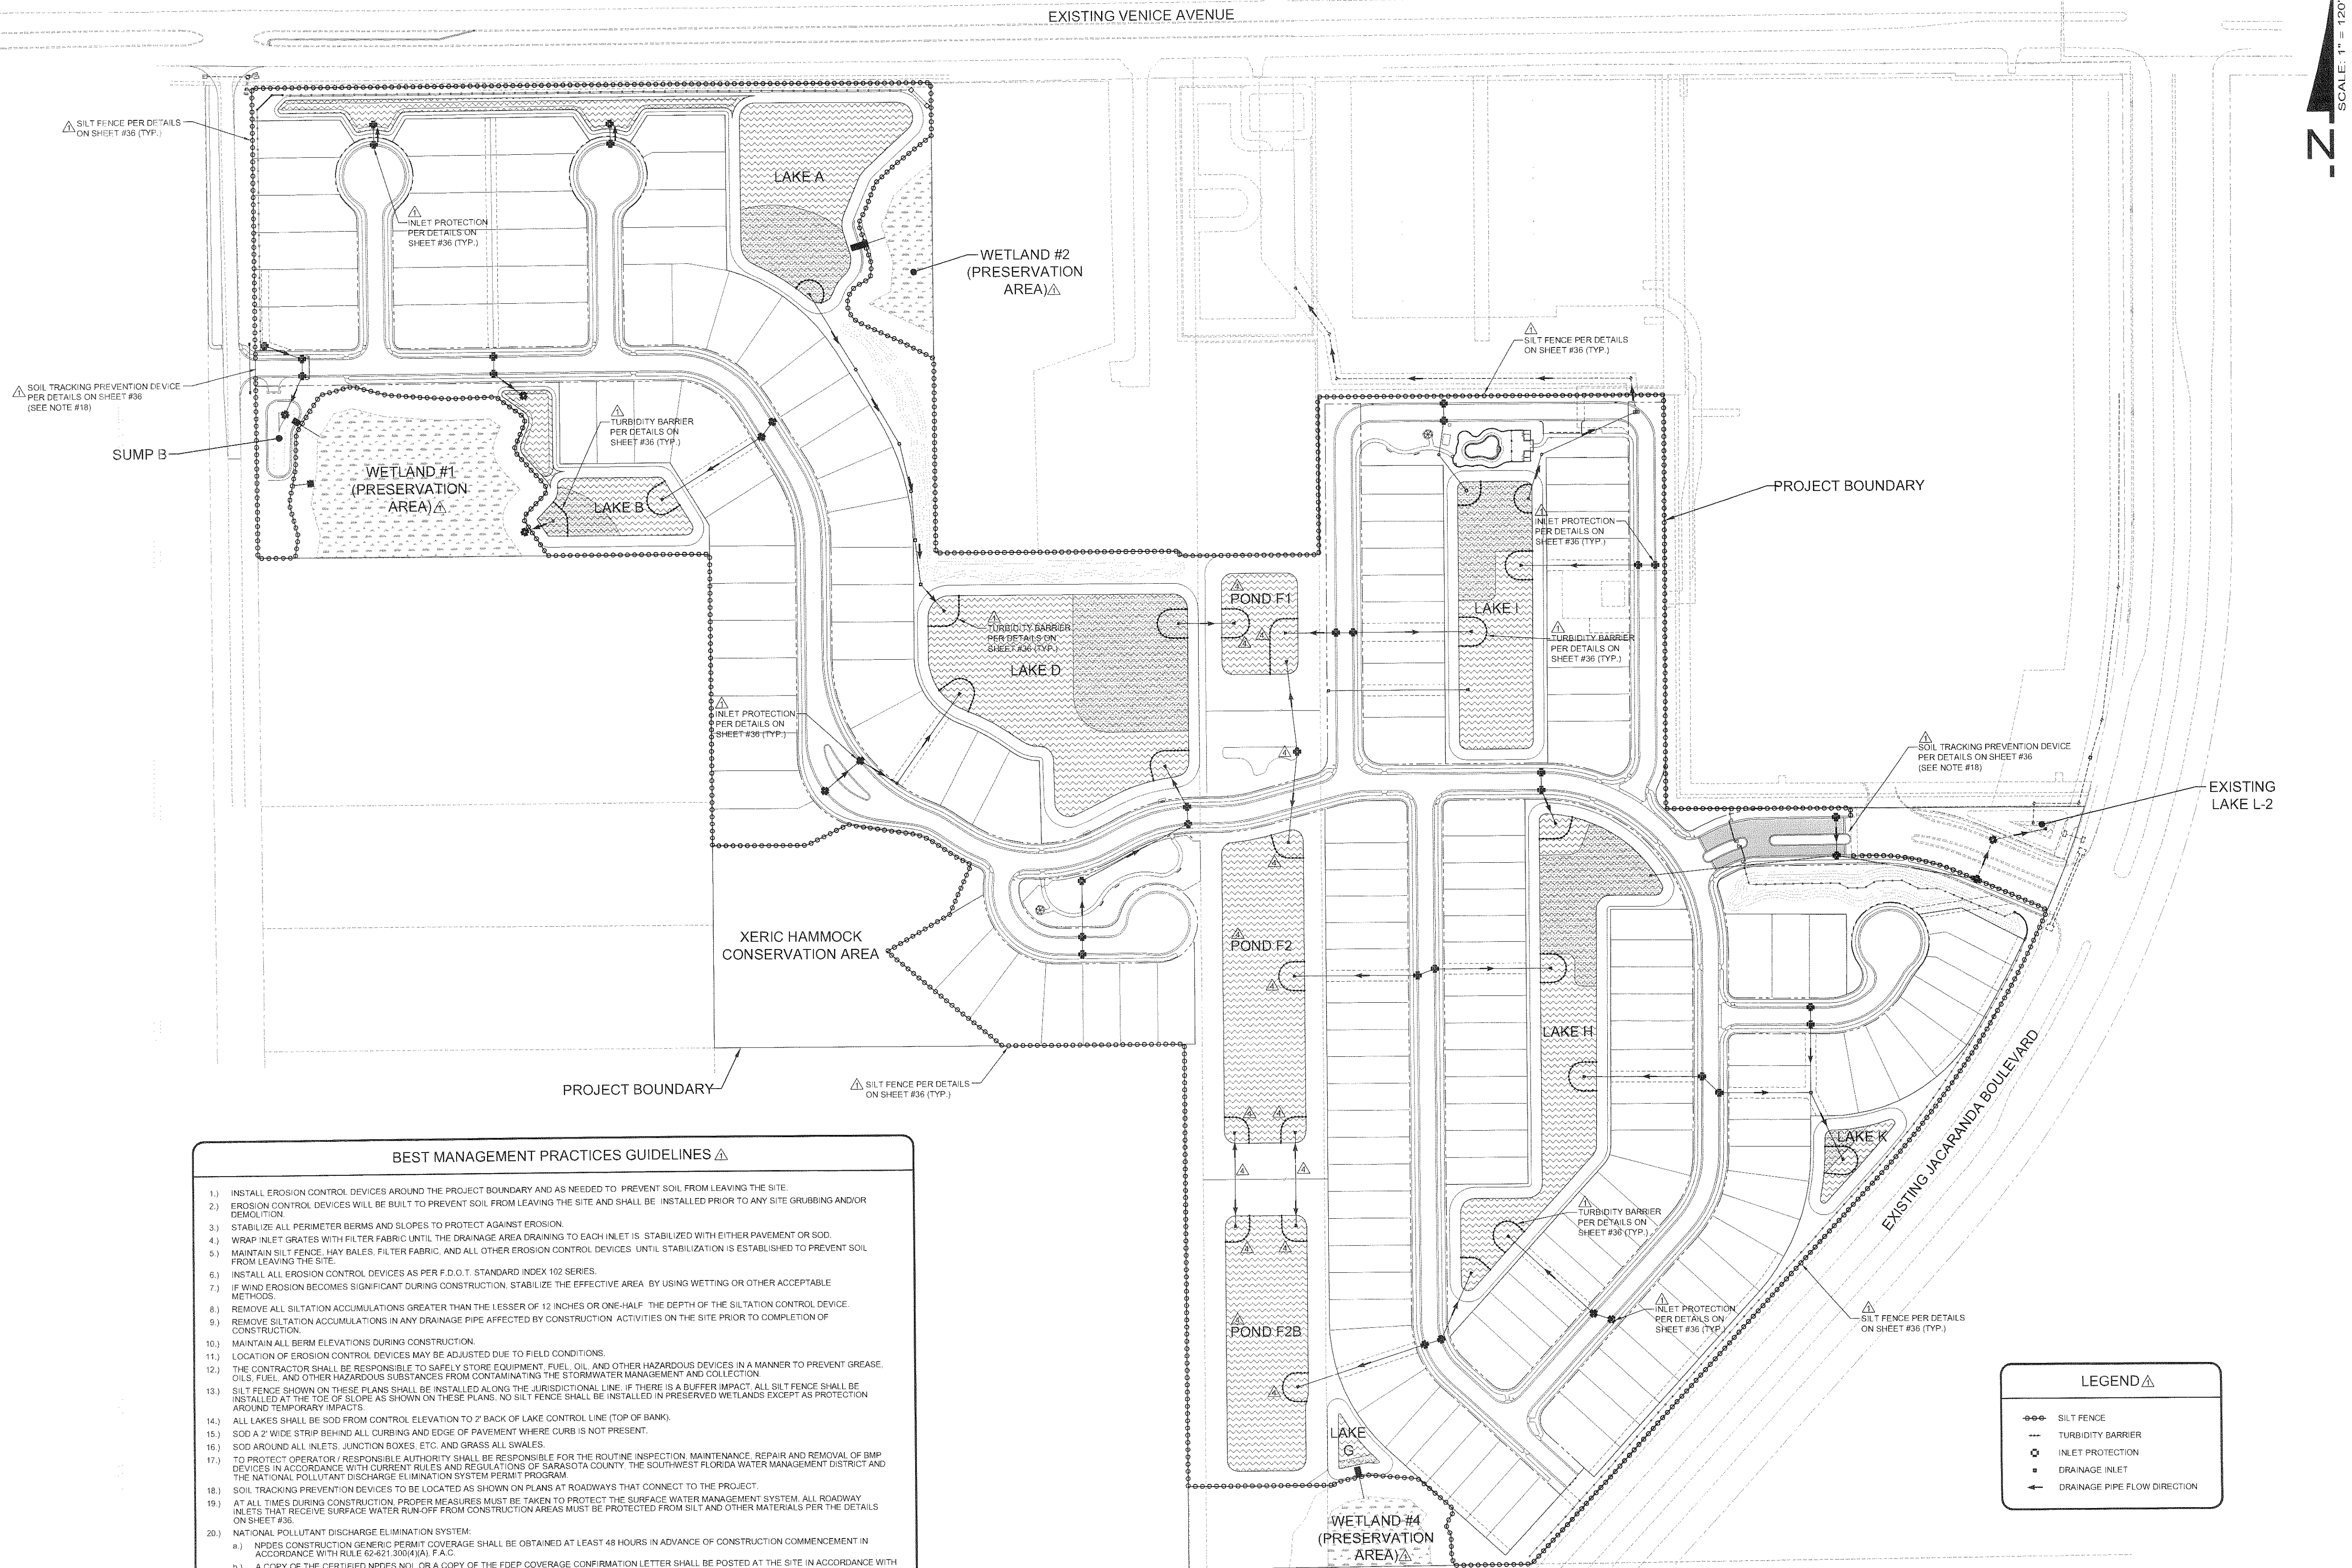

BEST MANAGEMENT PRACTICES GUIDELINES


1. INSTALL EROSION CONTROL DEVICES AROUND THE PROJECT BOUNDARY AND AS NEEDED TO PREVENT SOIL FROM LEAVING THE SITE.
2. EROSION CONTROL DEVICES WILL BE BUILT TO PREVENT SOIL FROM LEAVING THE SITE AND SHALL BE INSTALLED PRIOR TO ANY SITE GRUBBING AND/OR DEMOLITION.
3. STABILIZE ALL PERMETER BERMS AND SLOPES TO PROTECT AGAINST EROSION.
4. WRAP INLET GRATES WITH FILTER FABRIC UNTIL THE DRAINAGE AREA DRAINING TO EACH INLET IS STABILIZED WITH EITHER PAVEMENT OR SOD.
5. MAINTAIN SILT FENCE, HAY BALES, FILTER FABRIC, AND ALL OTHER EROSION CONTROL DEVICES UNTIL STABILIZATION IS ESTABLISHED TO PREVENT SOIL FROM LEAVING THE SITE.
6. INSTALL ALL EROSION CONTROL DEVICES AS PER F.D.O.T. STANDARD INDEX 102 SERIES.
7. IF WIND EROSION BECOMES SIGNIFICANT DURING CONSTRUCTION, STABILIZE THE EFFECTIVE AREA BY USING WETTING OR OTHER ACCEPTABLE METHODS.
8. REMOVE ALL SILTATION ACCUMULATIONS GREATER THAN THE LESSER OF 12 INCHES OR ONE-HALF THE DEPTH OF THE SILTATION CONTROL DEVICE.
9. REMOVE SILTATION ACCUMULATIONS IN ANY DRAINAGE PIPE AFFECTED BY CONSTRUCTION ACTIVITIES ON THE SITE PRIOR TO COMPLETION OF CONSTRUCTION.
10. MAINTAIN ALL BERM ELEVATIONS DURING CONSTRUCTION.
11. LOCATION OF EROSION CONTROL DEVICES MAY BE ADJUSTED DUE TO FIELD CONDITIONS.
12. THE CONTRACTOR SHALL BE RESPONSIBLE TO SAFELY STORE EQUIPMENT, FUEL, OIL, AND OTHER HAZARDOUS DEVICES IN A MANNER TO PREVENT GREASE, OILS, FUEL, AND OTHER HAZARDOUS SUBSTANCES FROM CONTAMINATING THE STORMWATER MANAGEMENT AND COLLECTION.
13. SILT FENCE SHOWN ON THESE PLANS SHALL BE INSTALLED ALONG THE JURISDICTIONAL LINE. IF THERE IS A BUFFER IMPACT ALL SILT FENCE SHALL BE INSTALLED AT THE TOP OF SLOPE AS SHOWN ON THESE PLANS. NO SILT FENCE SHALL BE INSTALLED IN PRESERVED WETLANDS EXCEPT AS PROTECTION AROUND TEMPORARY IMPACTS.
14. ALL LAKES SHALL BE SOD FROM CONTROL ELEVATION TO 2' BACK OF LAKE CONTROL LINE (TOP OF BANK).
15. SOD A 2' WIDE STRIP BEHIND ALL CURBING AND EDGE OF PAVEMENT WHERE CURB IS NOT PRESENT.
16. SOD AROUND ALL INLETS, JUNCTION BOXES, ETC. AND GRASS ALL SWALES.
17. TO PROTECT OPERATOR / RESPONSIBLE AUTHORITY SHALL BE RESPONSIBLE FOR THE ROUTINE INSPECTION, MAINTENANCE, REPAIR AND REMOVAL OF BMP DEVICES IN ACCORDANCE WITH CURRENT RULES AND REGULATIONS OF SARASOTA COUNTY, THE SOUTHWEST FLORIDA WATER MANAGEMENT DISTRICT AND THE NATIONAL POLLUTANT DISCHARGE ELIMINATION SYSTEM PERMIT PROGRAM.
18. SOIL TRACKING PREVENTION DEVICES TO BE LOCATED AS SHOWN ON PLANS AT ROADWAYS THAT CONNECT TO THE PROJECT.
19. AT ALL TIMES DURING CONSTRUCTION, PROPER MEASURES MUST BE TAKEN TO PROTECT THE SURFACE WATER MANAGEMENT SYSTEM. ALL ROADWAY INLETS THAT RECEIVE SURFACE WATER RUNOFF FROM CONSTRUCTION AREAS MUST BE PROTECTED FROM SILT AND OTHER MATERIALS PER THE DETAILS ON SHEET #36.
20. NATIONAL POLLUTANT DISCHARGE ELIMINATION SYSTEM.
 - a. NPDES CONSTRUCTION GENERAL PERMIT COVERAGE SHALL BE OBTAINED AT LEAST 48 HOURS IN ADVANCE OF CONSTRUCTION COMMENCEMENT IN ACCORDANCE WITH RULE 62-421.300(4)(A), F.A.C.
 - b. A COPY OF THE CERTIFIED NPDES NOI, OR A COPY OF THE FDEP COVERAGE CONFIRMATION LETTER SHALL BE POSTED AT THE SITE IN ACCORDANCE WITH RULE 62-421.300(4)(A) PART II (C), F.A.C., AND AS PER SEC 54-181(5)(1) OF THE SARASOTA COUNTY CODE.
 - c. A COPY OF THE CERTIFIED NPDES NOI, OR A COPY OF THE FDEP COVERAGE CONFIRMATION LETTER SHALL BE PROVIDED TO WATER RESOURCES IN ACCORDANCE WITH RULE 62-421.300(4)(A) PART II (D), F.A.C., AND SEC 54-181(5)(1) OF THE SARASOTA COUNTY CODE.
 - d. THE SWPPP SHALL BE CERTIFIED IN ACCORDANCE WITH RULE 62-421.300(4)(A) PART V D.B, F.A.C., AND A COPY OF THE CERTIFIED DOCUMENT SHALL BE SUBMITTED TO WATER RESOURCES AT LEAST 48 HOURS PRIOR TO THE COMMENCEMENT OF CONSTRUCTION PER SEC 54-181(5)(1) OF THE SARASOTA COUNTY CODE.
 - e. A COPY OF THE SWPPP, AND COPIES OF THE INSPECTION AND MAINTENANCE RECORDS SHALL BE MAINTAINED AT THE PROJECT SITE, AND SHALL BE READILY AVAILABLE TO COUNTY OR STATE INSPECTORS PER SEC 54-181(5)(1) OF THE SARASOTA COUNTY CODE.
21. THE DISCHARGE OF GROUNDWATER PRODUCED THROUGH DEWATERING PROTECTION (DEP) PERMIT(S) SHALL BE OBTAINED PRIOR TO THE COMMENCEMENT OF DEWATERING.




WALDROP
ENGINEERING
CIVIL ENGINEERING &
LAND DEVELOPMENT CONSULTANTS
264100 BONITA GRANDE DRIVE, SUITE 305 BONITA SPRINGS, FL 34135
P: 239-405-7777 F: 239-405-7898 EMAIL: info@waldropengineering.com

VERONA RESERVE
CLIENT: TAYLOR MORRISON OF FLORIDA, INC.
BEST MANAGEMENT PRACTICES PLAN


PLAN REVISIONS	
NO.	REVISION
1	REVISED PER SARASOTA COUNTY COMMENTS
2	REVISED PER CLIENT COMMENTS
3	
4	
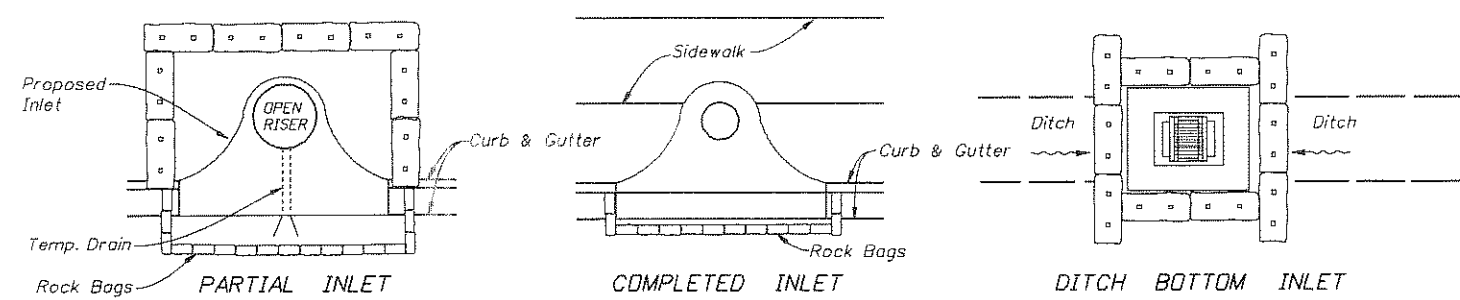


PROTECTION AROUND INLETS OR SIMILAR STRUCTURES

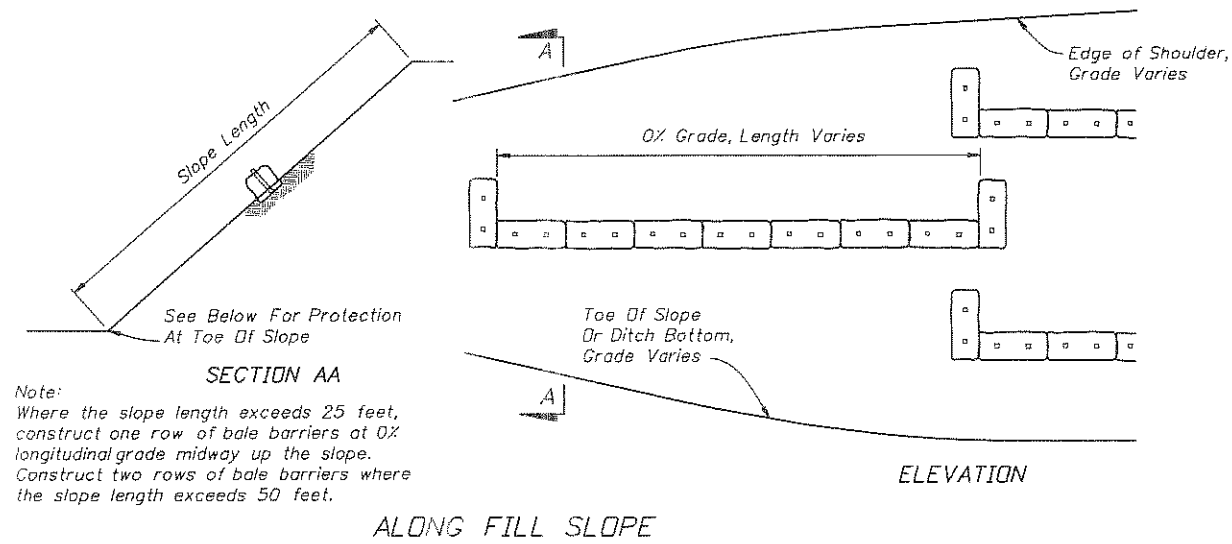

SYNTHETIC BALES OR BALE TYPE BARRIERS FOR PAVED DITCHES

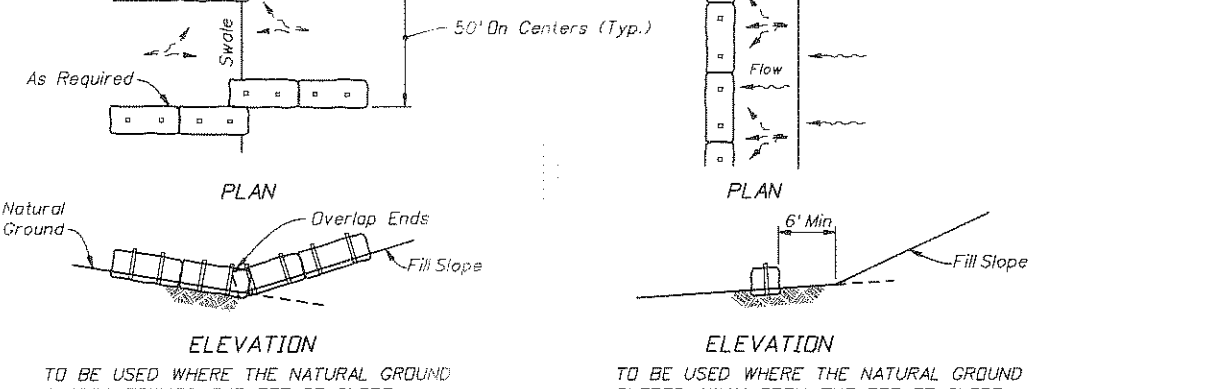


SYNTHETIC BALES OR BALE TYPE BARRIERS FOR UNPAVED DITCHES

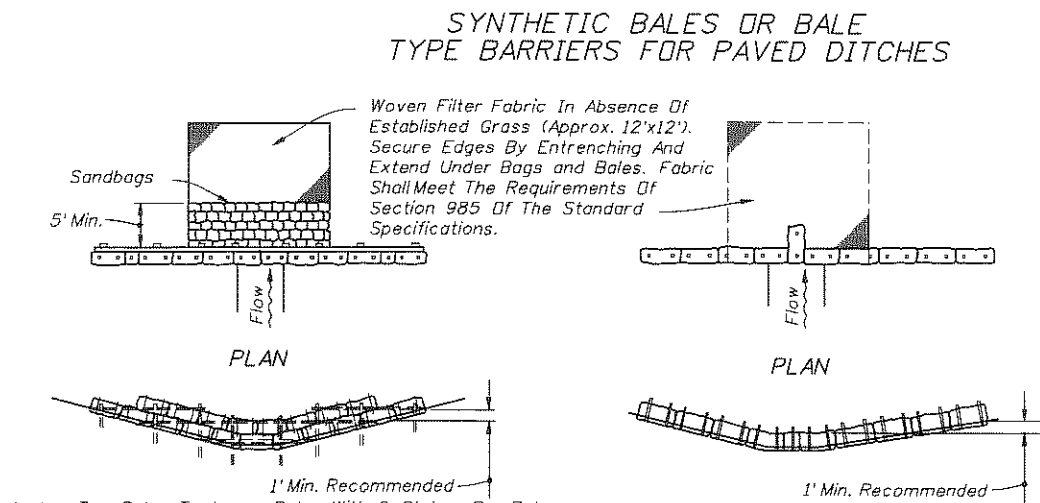


SYNTHETIC BALES OR BALE TYPE BARRIERS FOR UNPAVED DITCHES

NOTES FOR SYNTHETIC BALES OR BALE TYPE BARRIERS

1. Type I and II Synthetic Barrier should be spaced in accordance with Chart 1, Sheet 1.
2. Bales should be trawled 3" to 4" and anchored with 2" x 2" (or 1" dia.) x 4' wood stakes. Stakes of other material or shape providing equivalent strength may be used if approved by the Engineer. Stakes other than wood should be removed upon completion of the project.
3. Ralls and posts should be 2" x 4" wood. Other materials providing equivalent strength may be used if approved by the Engineer.
4. Adjacent bales should be butted firmly together.
5. Where used in conjunction with silt fences, bales should be placed on the upstream side of the fence.
6. Bales to be paid for under the contract unit price for Synthetic Bales, LF. The unit price shall include the cost of filter fabric for Type I and II Barriers. Sandbags should be paid for under the unit price for Sandbagging, CY. Rock bags to be paid for under the contract unit price for Rock Bags, EA.

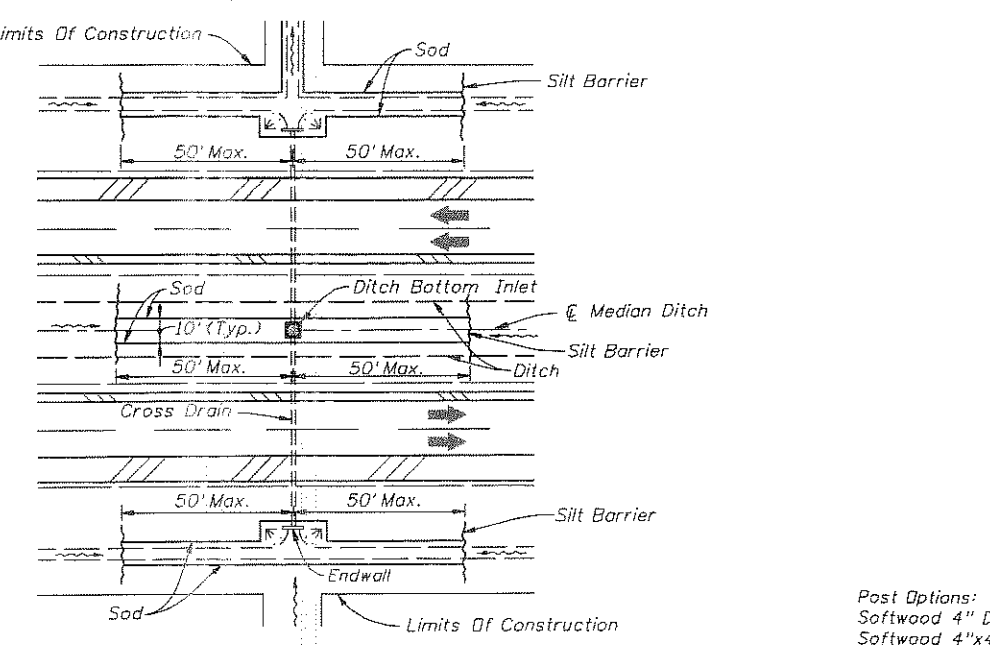


DITCH INSTALLATIONS AT DRAINAGE STRUCTURES

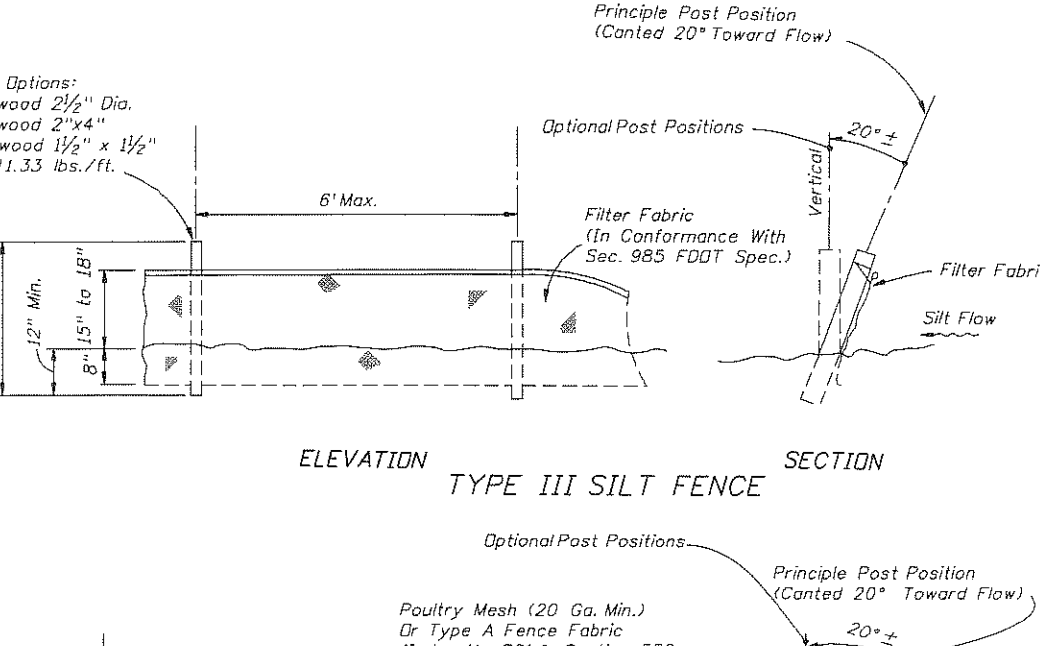


DITCH INSTALLATIONS AT DRAINAGE STRUCTURES




DITCH INSTALLATIONS AT DRAINAGE STRUCTURES

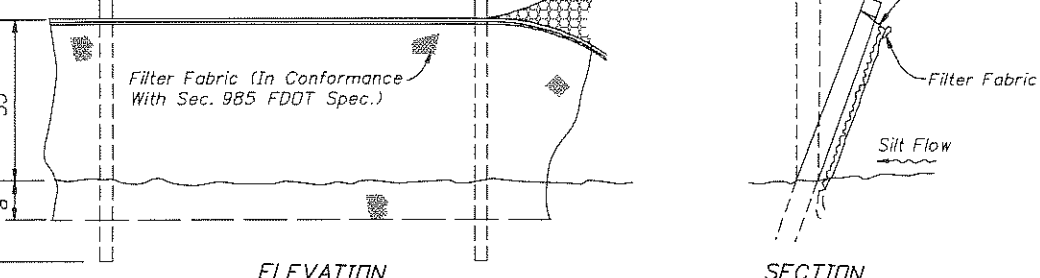

DITCH INSTALLATIONS AT DRAINAGE STRUCTURES

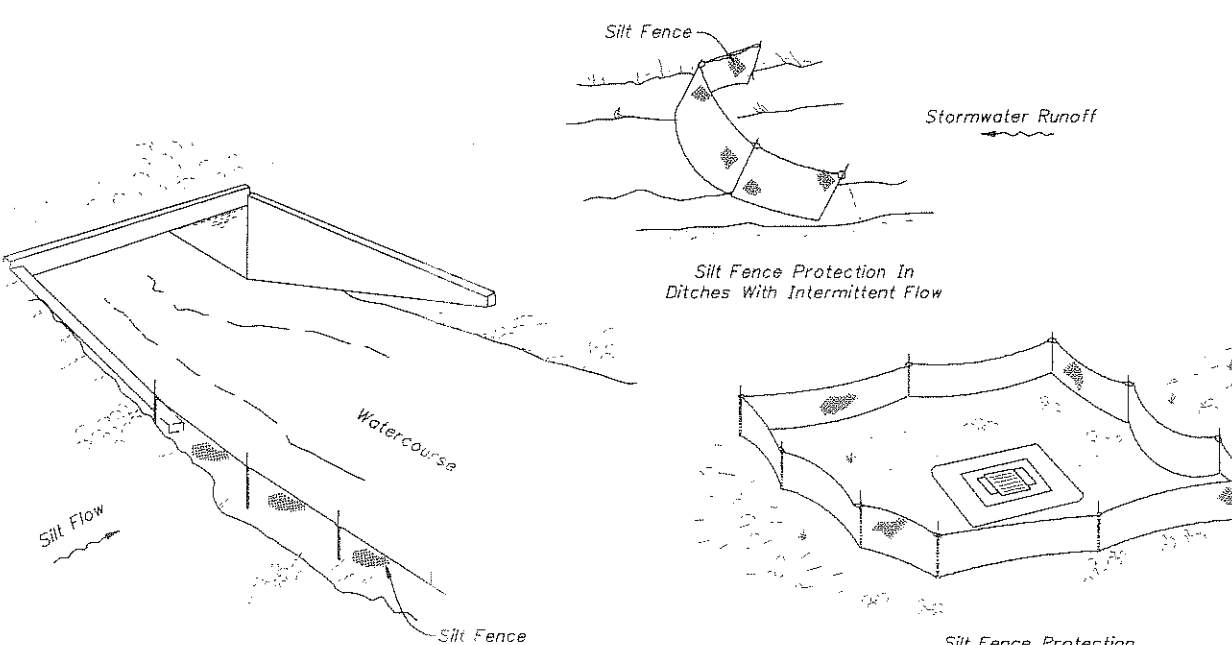

SILT FENCE APPLICATIONS

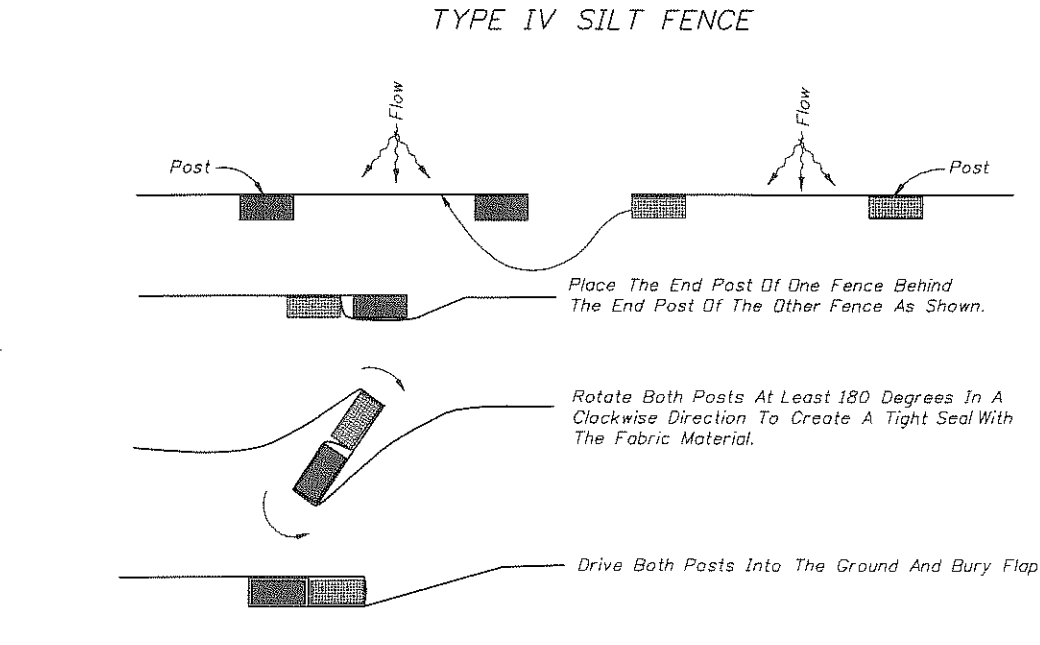


SILT FENCE APPLICATIONS

NOTES FOR SILT FENCES

1. Type III Silt Fence to be used at most locations. Where used in ditches, the spacing for Type III Silt Fence should be in accordance with Chart 1, Sheet 1.
2. Type IV Silt Fence to be used where large sediment loads are anticipated. Suggested use is where fill slope is 1:2 or steeper and length of slope exceeds 25 feet. Avoid use where the detained water may back into travel lanes or all the right of way.
3. Do not construct silt fences across permanent flowing watercourses. Silt fences are to be at upland locations and turbidity barriers used at permanent bodies of water.
4. Where used on slope protection, Silt Fence is to be constructed on 0% longitudinal grade to avoid channeling runoff along the length of the fence.
5. Silt Fence is to be paid for under the contract unit price for Staked Silt Fence, LF.

TEMPORARY EROSION AND SEDIMENT CONTROL

(REF. FOOT INDEX 102) N.T.S.

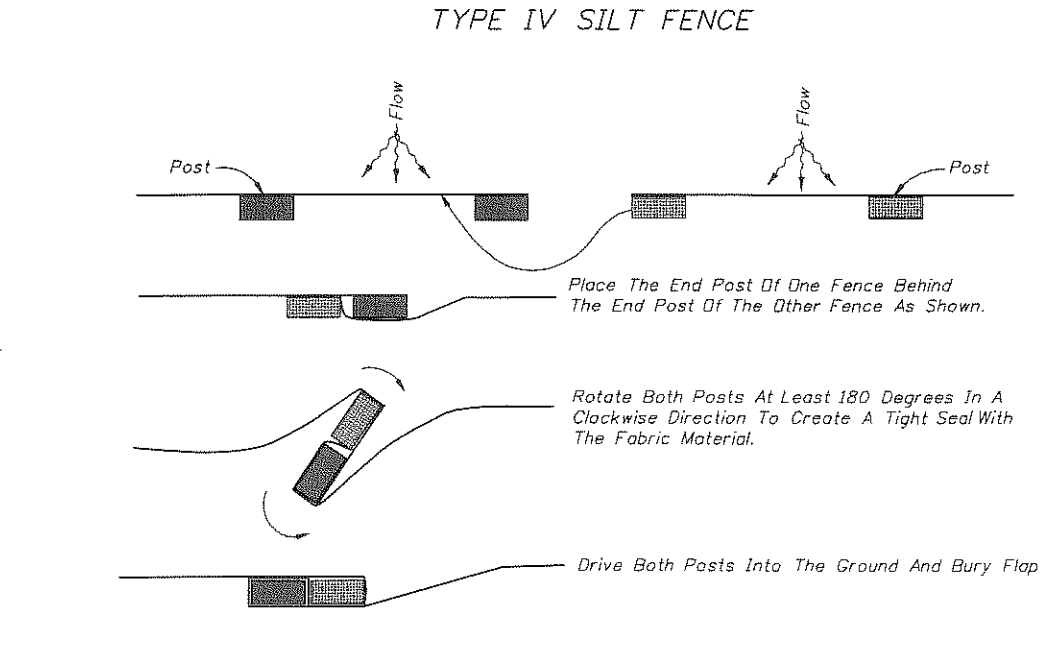


SILT FENCE APPLICATIONS

NOTES FOR SILT FENCES

1. Type III Silt Fence to be used at most locations. Where used in ditches, the spacing for Type III Silt Fence should be in accordance with Chart 1, Sheet 1.
2. Type IV Silt Fence to be used where large sediment loads are anticipated. Suggested use is where fill slope is 1:2 or steeper and length of slope exceeds 25 feet. Avoid use where the detained water may back into travel lanes or all the right of way.
3. Do not construct silt fences across permanent flowing watercourses. Silt fences are to be at upland locations and turbidity barriers used at permanent bodies of water.
4. Where used on slope protection, Silt Fence is to be constructed on 0% longitudinal grade to avoid channeling runoff along the length of the fence.
5. Silt Fence is to be paid for under the contract unit price for Staked Silt Fence, LF.

TEMPORARY EROSION AND SEDIMENT CONTROL

(REF. FOOT INDEX 102) N.T.S.

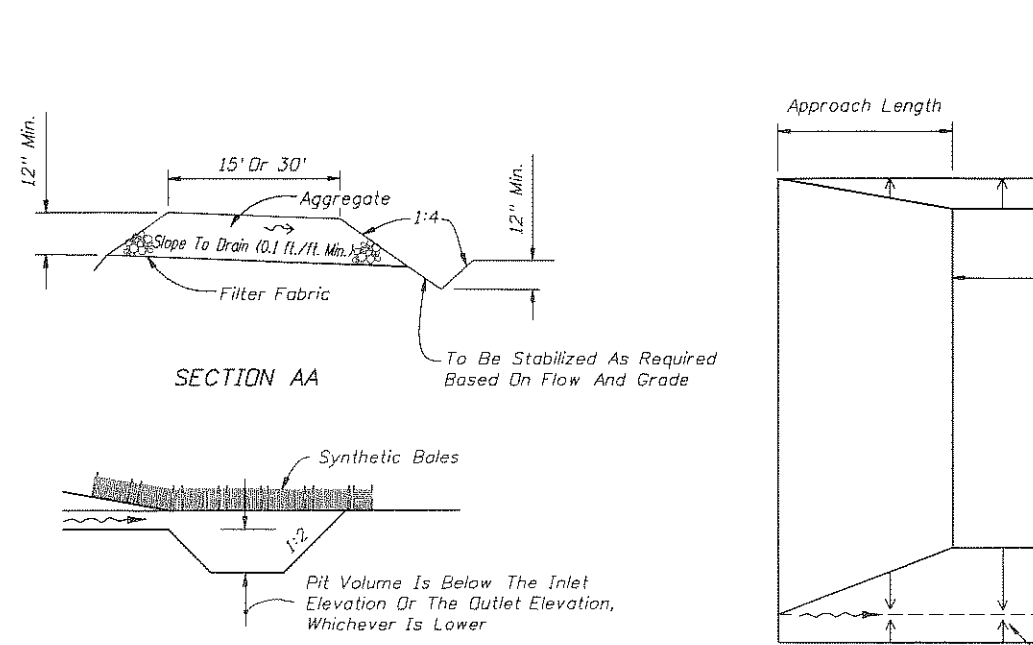


SILT FENCE APPLICATIONS

NOTES FOR SILT FENCES

1. Type III Silt Fence to be used at most locations. Where used in ditches, the spacing for Type III Silt Fence should be in accordance with Chart 1, Sheet 1.
2. Type IV Silt Fence to be used where large sediment loads are anticipated. Suggested use is where fill slope is 1:2 or steeper and length of slope exceeds 25 feet. Avoid use where the detained water may back into travel lanes or all the right of way.
3. Do not construct silt fences across permanent flowing watercourses. Silt fences are to be at upland locations and turbidity barriers used at permanent bodies of water.
4. Where used on slope protection, Silt Fence is to be constructed on 0% longitudinal grade to avoid channeling runoff along the length of the fence.
5. Silt Fence is to be paid for under the contract unit price for Staked Silt Fence, LF.


TEMPORARY EROSION AND SEDIMENT CONTROL

(REF. FOOT INDEX 102) N.T.S.

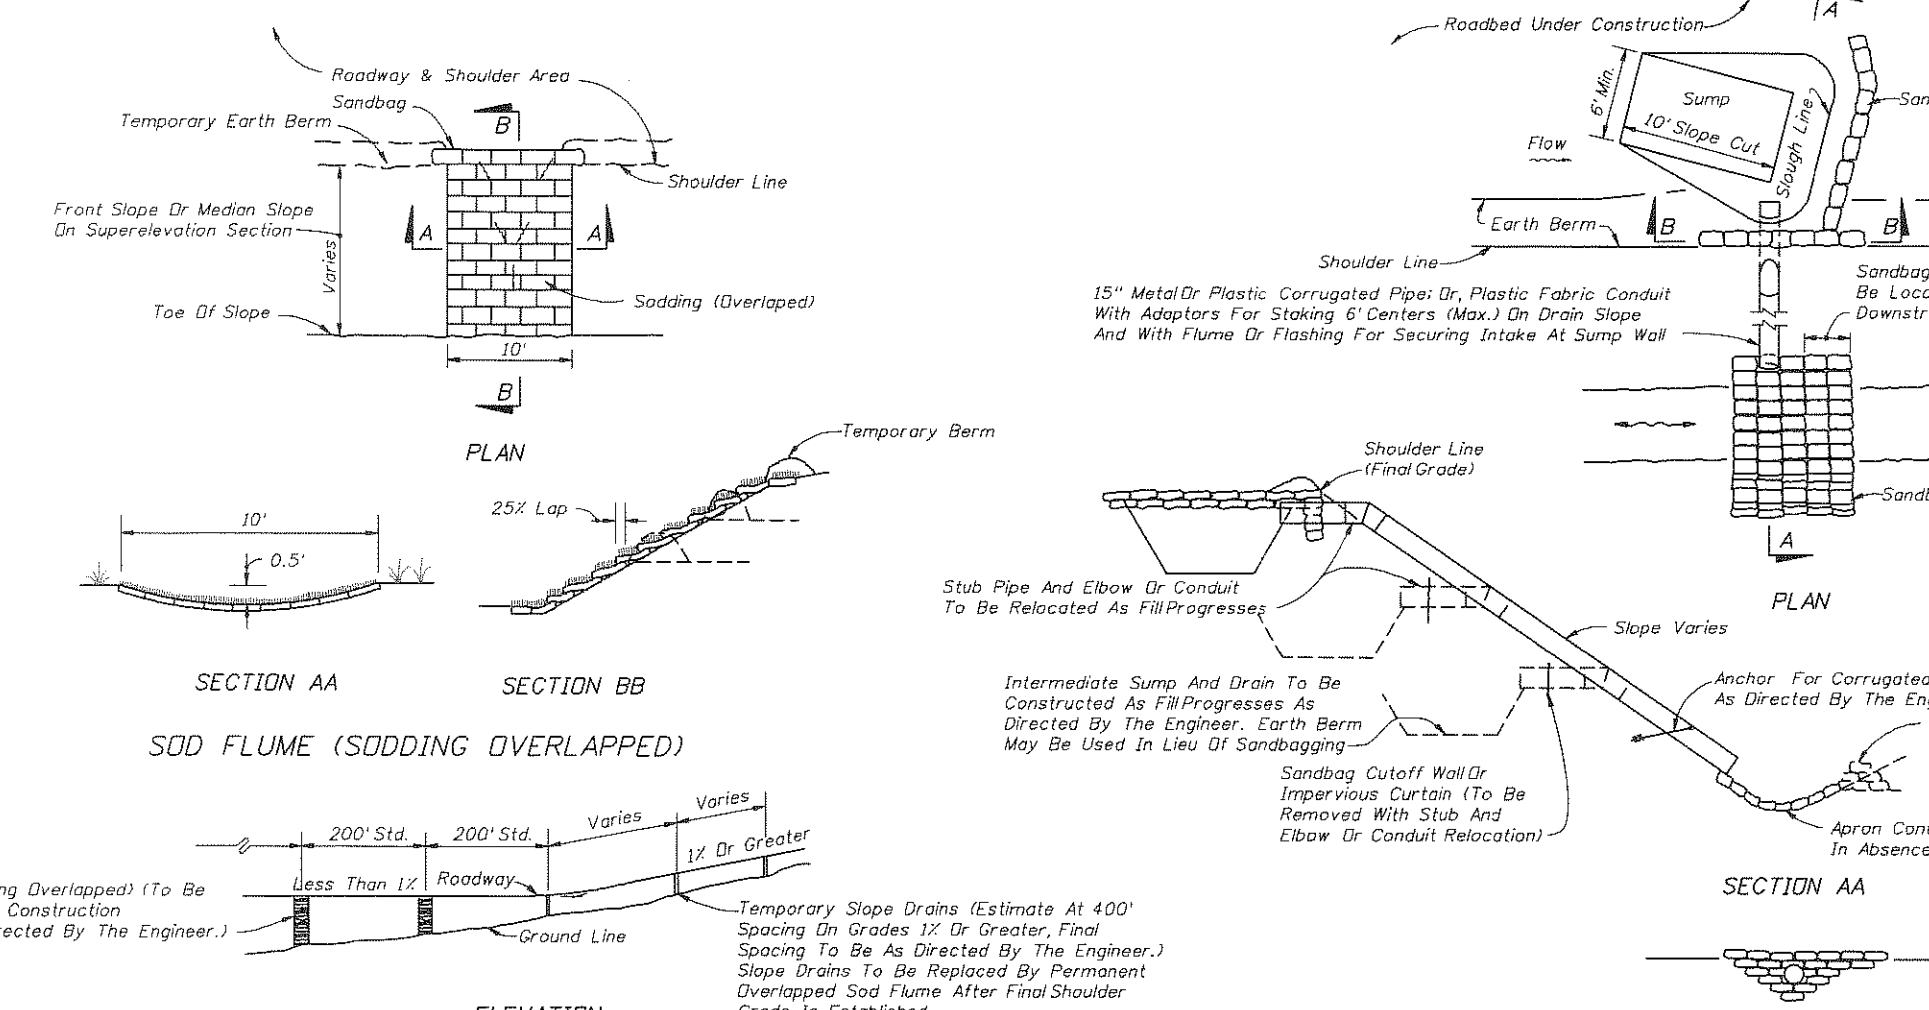


TEMPORARY SLOPE DRAIN AND SOD FLUME

(REF. FOOT INDEX 100) N.T.S.

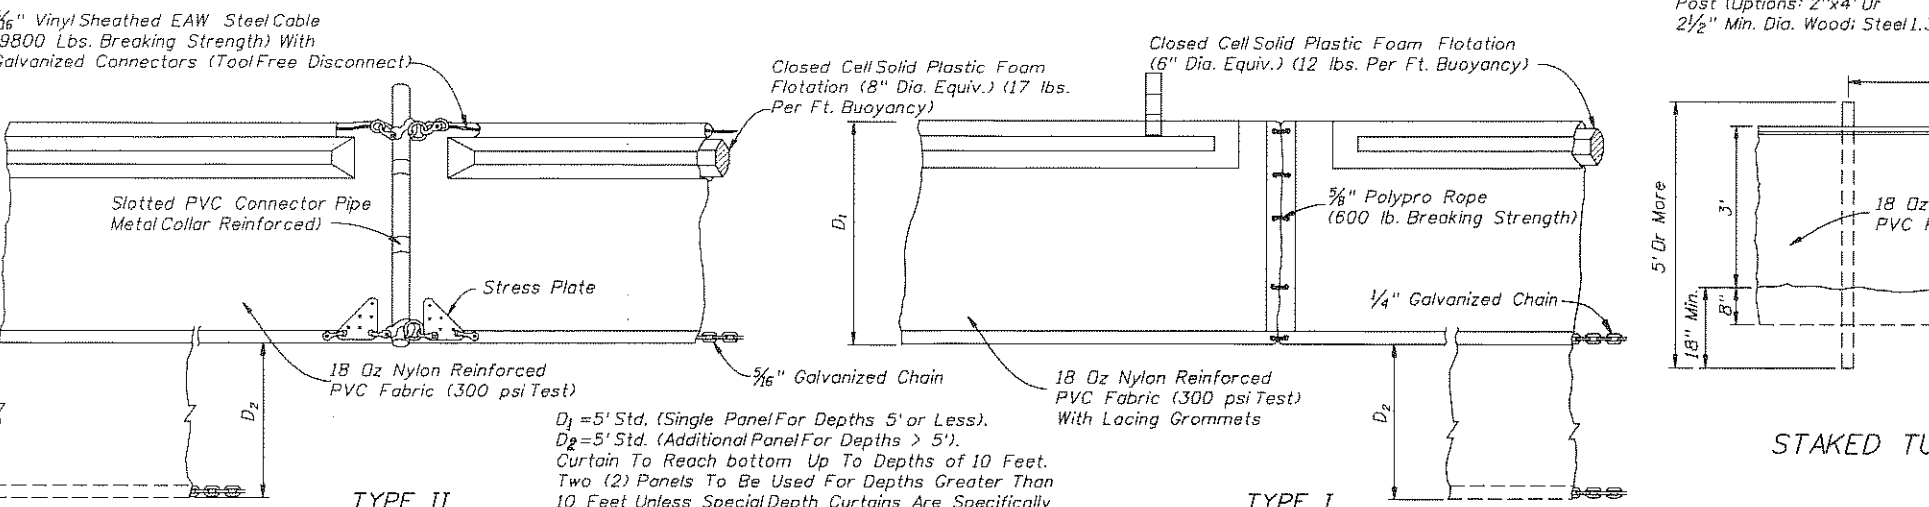


TEMPORARY SLOPE DRAIN AND SOD FLUME

(REF. FOOT INDEX 100) N.T.S.

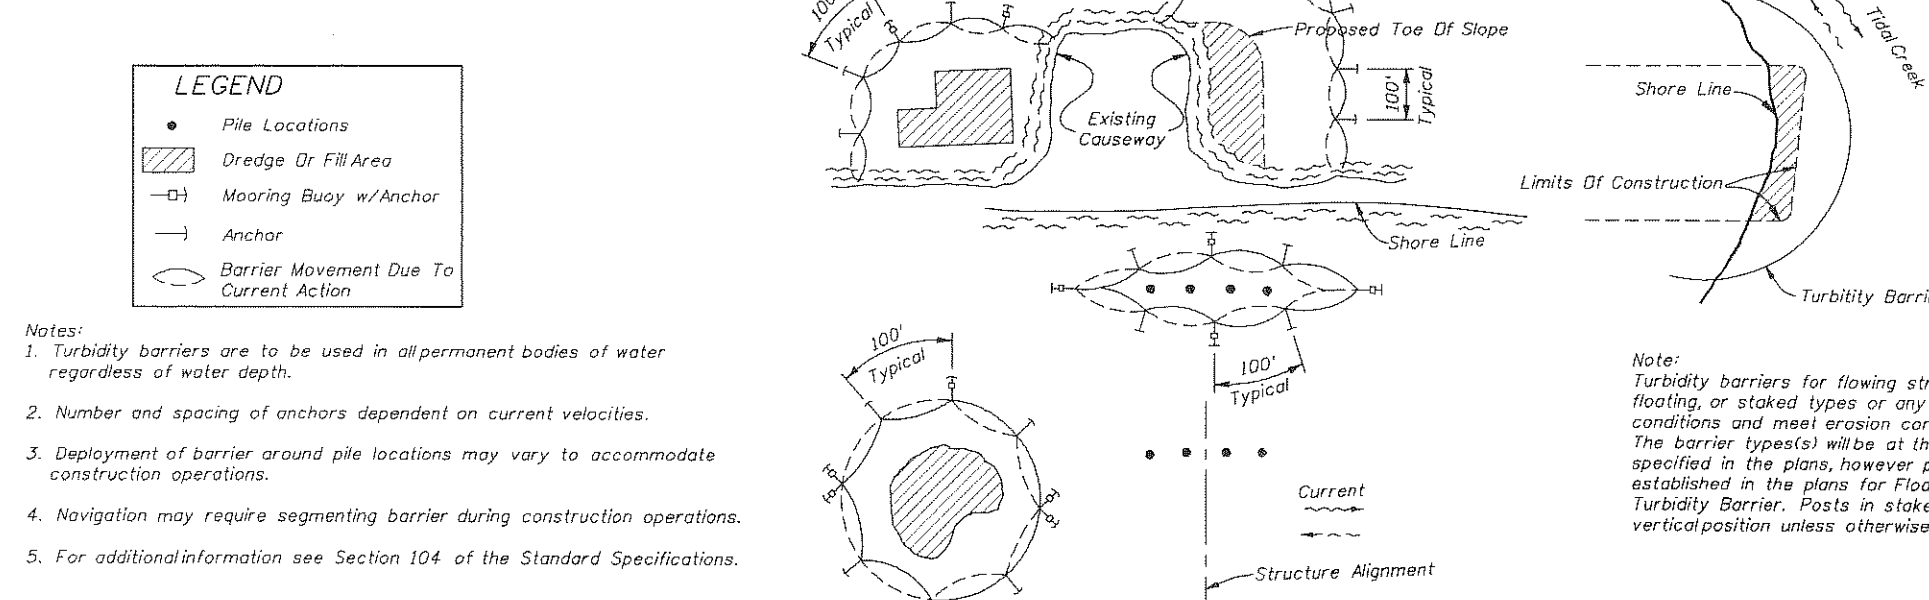

TEMPORARY SLOPE DRAIN AND SOD FLUME

(REF. FOOT INDEX 100) N.T.S.

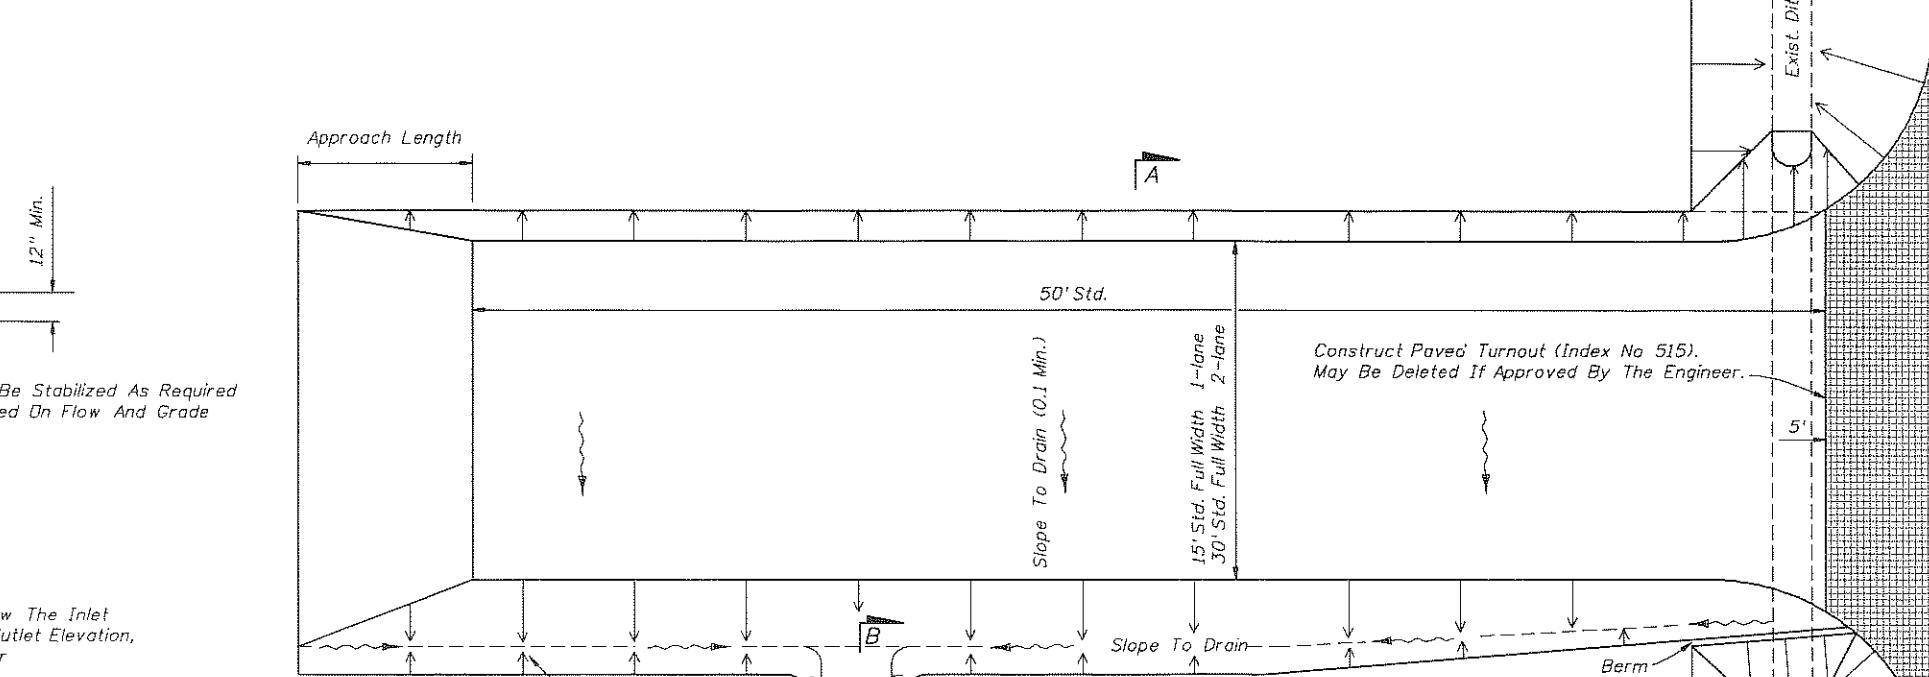


TEMPORARY SLOPE DRAIN AND SOD FLUME

NOTES FOR SILT FENCES

1. Type III Silt Fence to be used at most locations. Where used in ditches, the spacing for Type III Silt Fence should be in accordance with Chart 1, Sheet 1.
2. Type IV Silt Fence to be used where large sediment loads are anticipated. Suggested use is where fill slope is 1:2 or steeper and length of slope exceeds 25 feet. Avoid use where the detained water may back into travel lanes or all the right of way.
3. Do not construct silt fences across permanent flowing watercourses. Silt fences are to be at upland locations and turbidity barriers used at permanent bodies of water.
4. Where used on slope protection, Silt Fence is to be constructed on 0% longitudinal grade to avoid channeling runoff along the length of the fence.
5. Silt Fence is to be paid for under the contract unit price for Staked Silt Fence, LF.


TEMPORARY EROSION AND SEDIMENT CONTROL

(REF. FOOT INDEX 102) N.T.S.

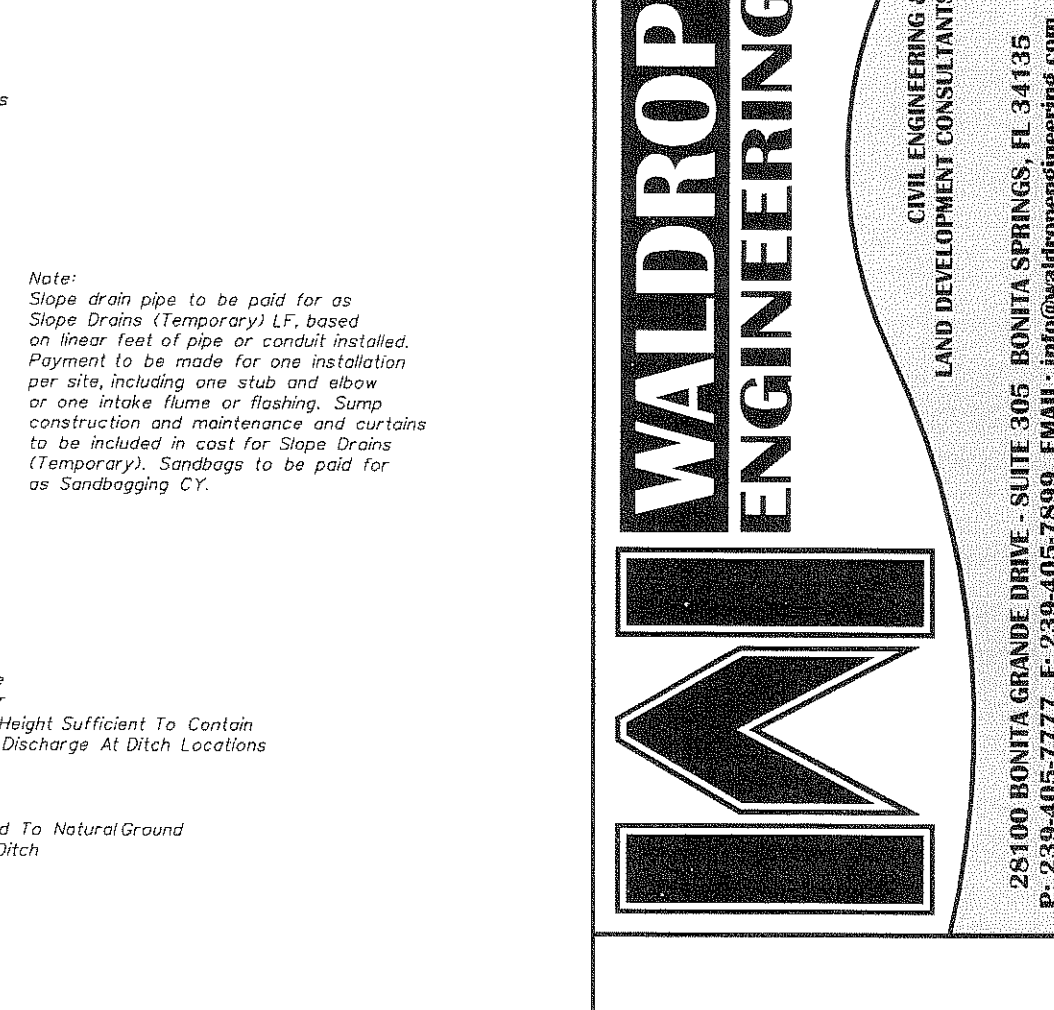


TEMPORARY SLOPE DRAIN AND SOD FLUME

(REF. FOOT INDEX 100) N.T.S.

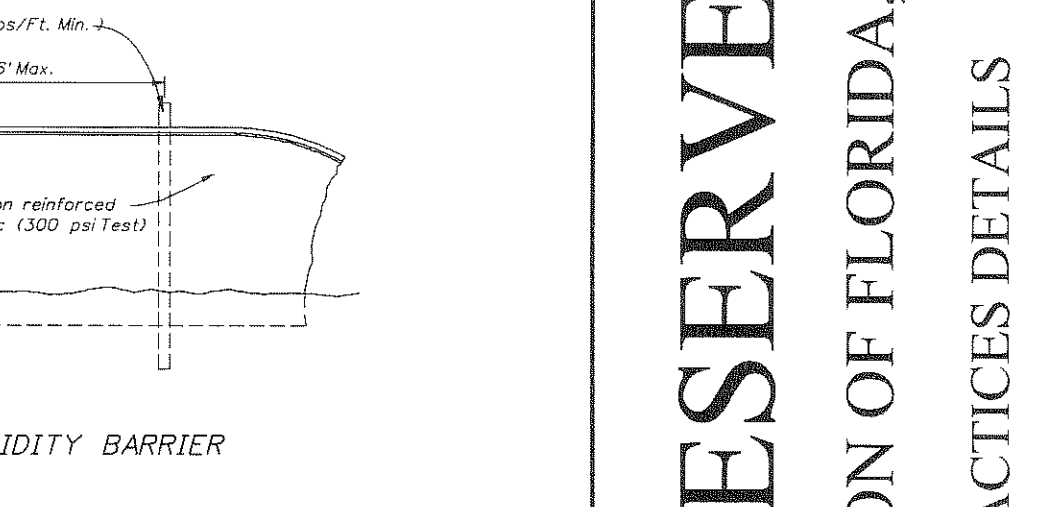


TEMPORARY SLOPE DRAIN AND SOD FLUME

(REF. FOOT INDEX 100) N.T.S.

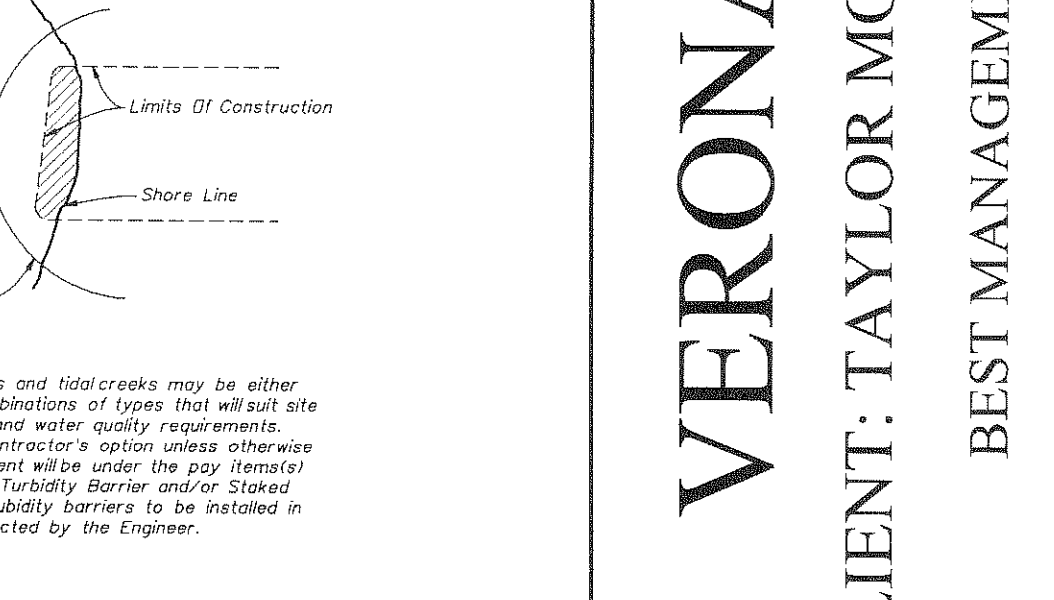

TEMPORARY SLOPE DRAIN AND SOD FLUME

(REF. FOOT INDEX 100) N.T.S.

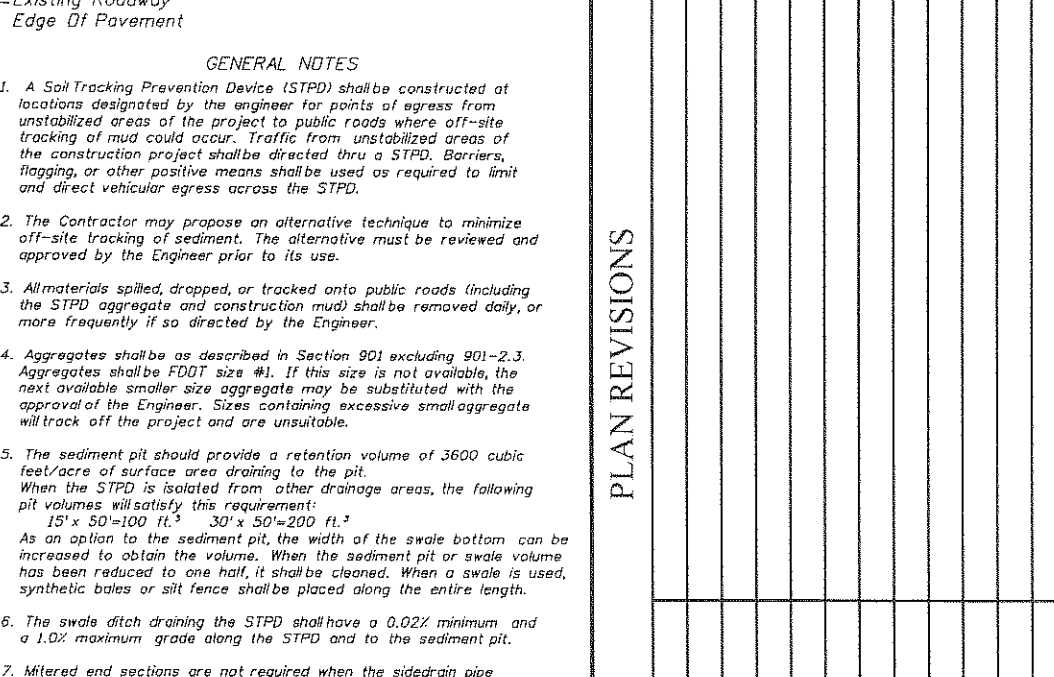

TEMPORARY SLOPE DRAIN AND SOD FLUME


NOTES FOR SILT FENCES

1. Type III Silt Fence to be used at most locations. Where used in ditches, the spacing for Type III Silt Fence should be in accordance with Chart 1, Sheet 1.
2. Type IV Silt Fence to be used where large sediment loads are anticipated. Suggested use is where fill slope is 1:2 or steeper and length of slope exceeds 25 feet. Avoid use where the detained water may back into travel lanes or all the right of way.
3. Do not construct silt fences across permanent flowing watercourses. Silt fences are to be at upland locations and turbidity barriers used at permanent bodies of water.
4. Where used on slope protection, Silt Fence is to be constructed on 0% longitudinal grade to avoid channeling runoff along the length of the fence.
5. Silt Fence is to be paid for under the contract unit price for Staked Silt Fence, LF.

TEMPORARY EROSION AND SEDIMENT CONTROL

(REF. FOOT INDEX 102) N.T.S.

WALDROP ENGINEERING

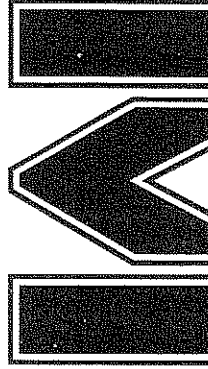

CIVIL ENGINEERING & LAND DEVELOPMENT CONSULTANTS
28100 BONTA GRANDE DRIVE - SUITE 305 BONTA SPRINGS, FL 34135
P: 239-405-7777 F: 239-405-7599 EMAIL: info@waldropengineering.com

VERONA RESERVE


CLIENT: TAYLOR MORRISON OF FLORIDA, INC.

BEST MANAGEMENT PRACTICES DETAILS

PLAN REVISIONS

1	
2	
3	
4	
5	
6	
7	
8	
9	
10	

FLORIDA CERTIFICATE OF AUTHORIZATION #536

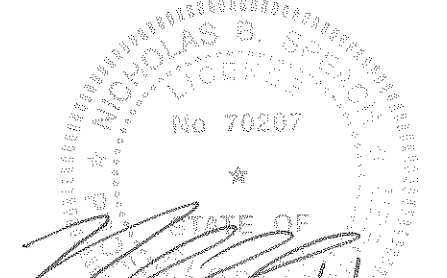

SET NUMBER: 225-01-01

SHEET: 36



PAVING, SIGNAGE & GRADING SITE PLAN (A)

SET NUMBER:	225 01
SHEET:	